



1-54
WESTER-MARTIN INC.
1-55
WESTER-MARTIN INC.

1-54
WESTER-MARTIN INC.
1-55
WESTER-MARTIN INC.

ARTHUR J. & ELAINE D. PAQUETTE
 CULVERT RIGHTS: STA 146+50± TO 152+00±
 UNDERDRAIN: STA 160+00±
 SLOPE RIGHTS: 155+00-167+00±
 GRADE CHANGE: 160+00-162+00±
 CHANNEL CHANGE: STA 151+75-152+50±
 WD 12/9/57
 RECORDED: HYDE PARK - BK 35 - PG 216/217 - 12/17/57

CONSTRUCT DRIVES	
160+30	LT
161+80	LT
157+50	RT

CONSTRUCT APPROACH
153+00 RT.

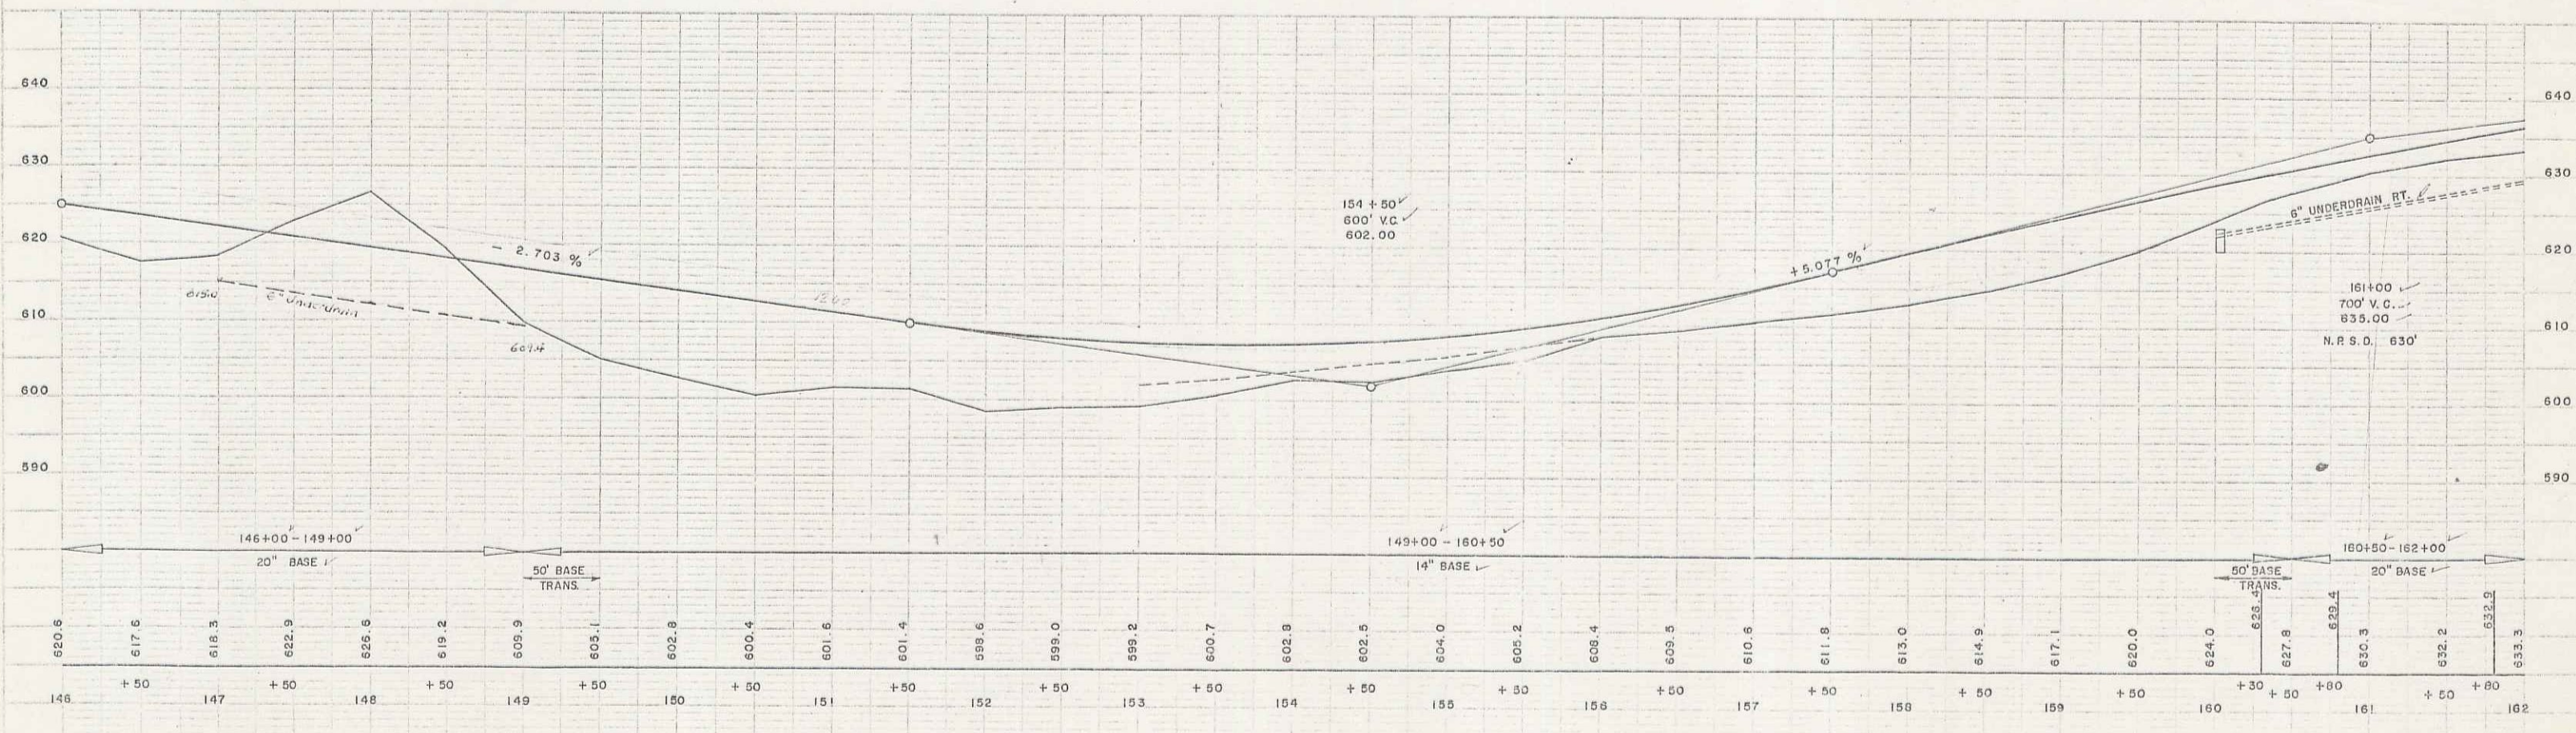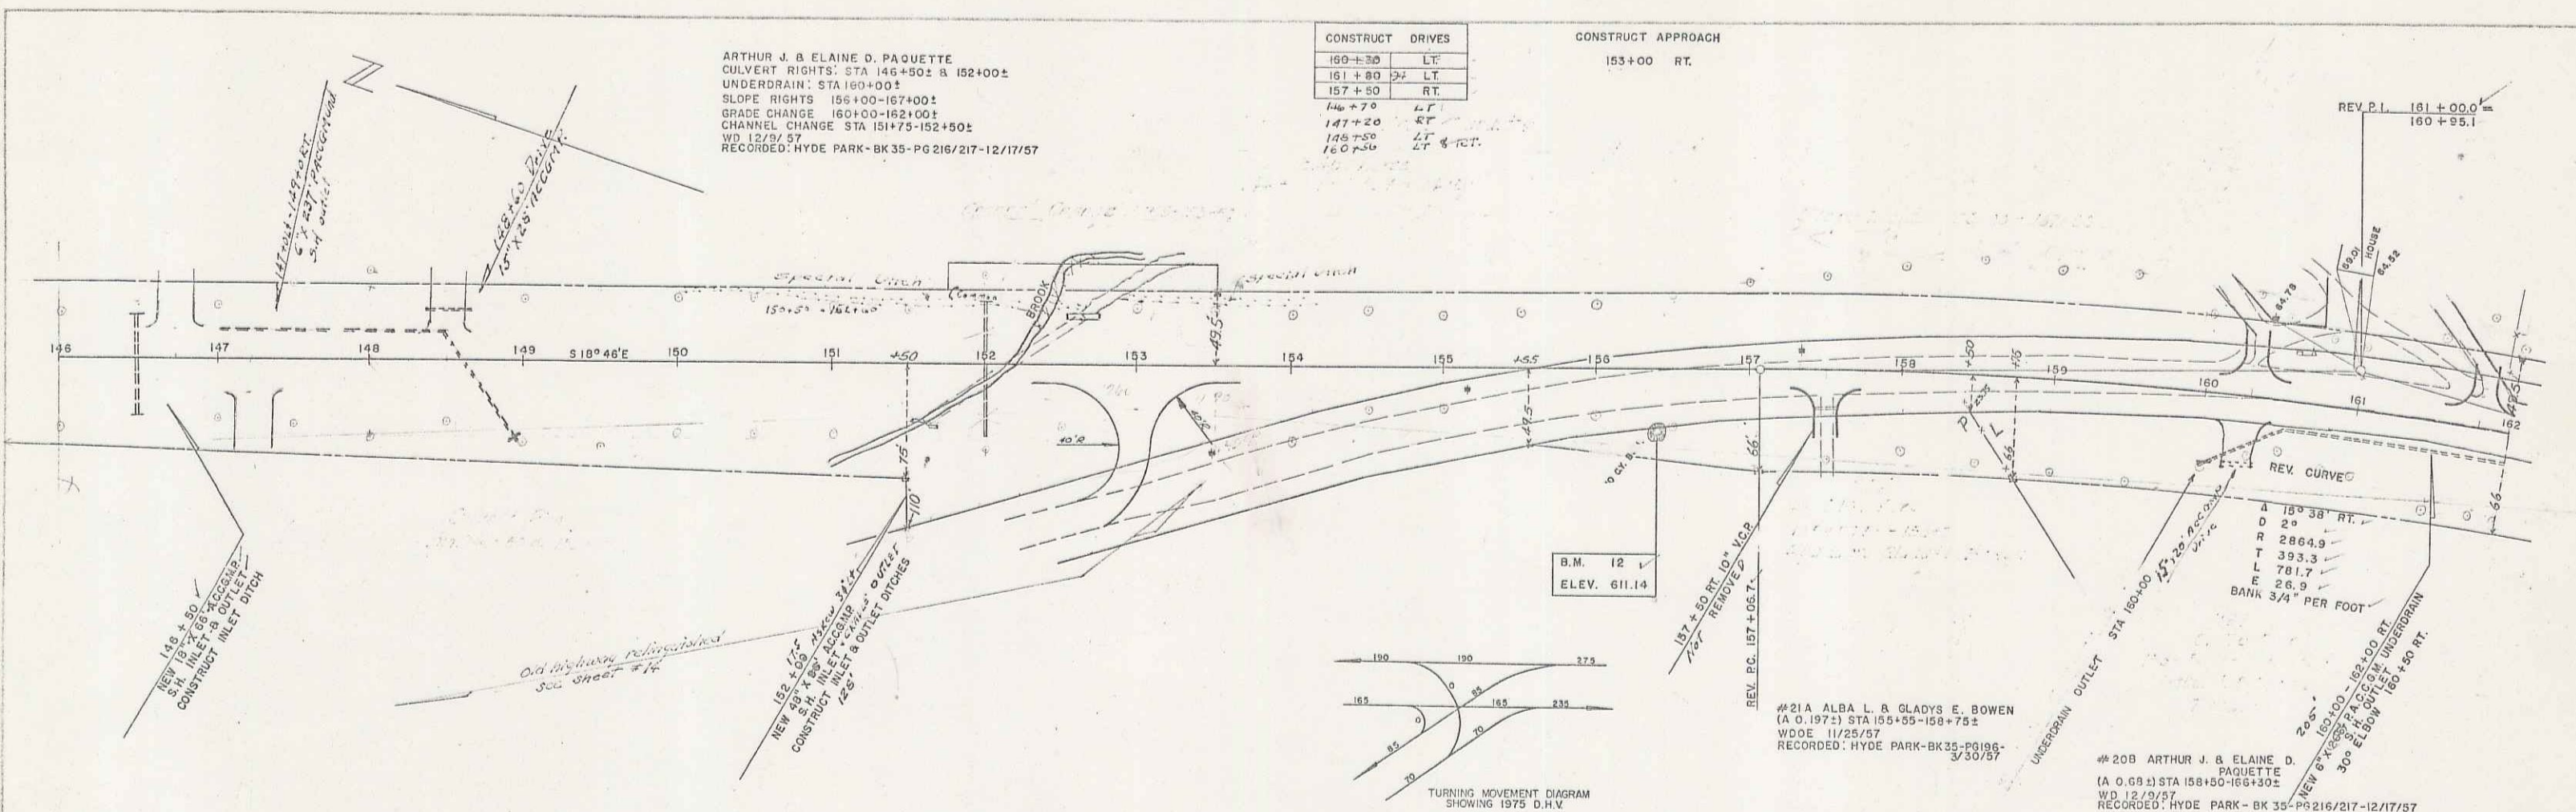

B.M. 12 40 RT. 155+39 SPOT AT HI POINT 3 CY BOULDER ELEV. 611.14

HYDE PARK - MORRISTOWN F 39(2)
SHEET 18 OF 133

9