



Removal of deposit of gravel from rail
183+66 - 187+46.50

CONSTRUCT DRIVES	
179+40	LT
180+15	LT
181+00	LT
183+08	LT
183+74	LT & RT
190+20	RT
191+70	LT
193+50	LT

#26 WENDELL BUSCAGLIA
SLOPE RIGHTS STA 188+33-190+20
WOODE 11/29/57
RECORDED: MORRISTOWN-BK 56-PG 436-12/7/57

Three Curve Guard Rail Steel 188+5
182+50 - 188+04 61' RT

#27 WILLIE A ROSS & ERNEST W ROSS
(A O 1022) STA 191+82-195+90
WO 01 11/25/57
RECORDED: MORRISTOWN-BK 55-PG 537-11/30/57

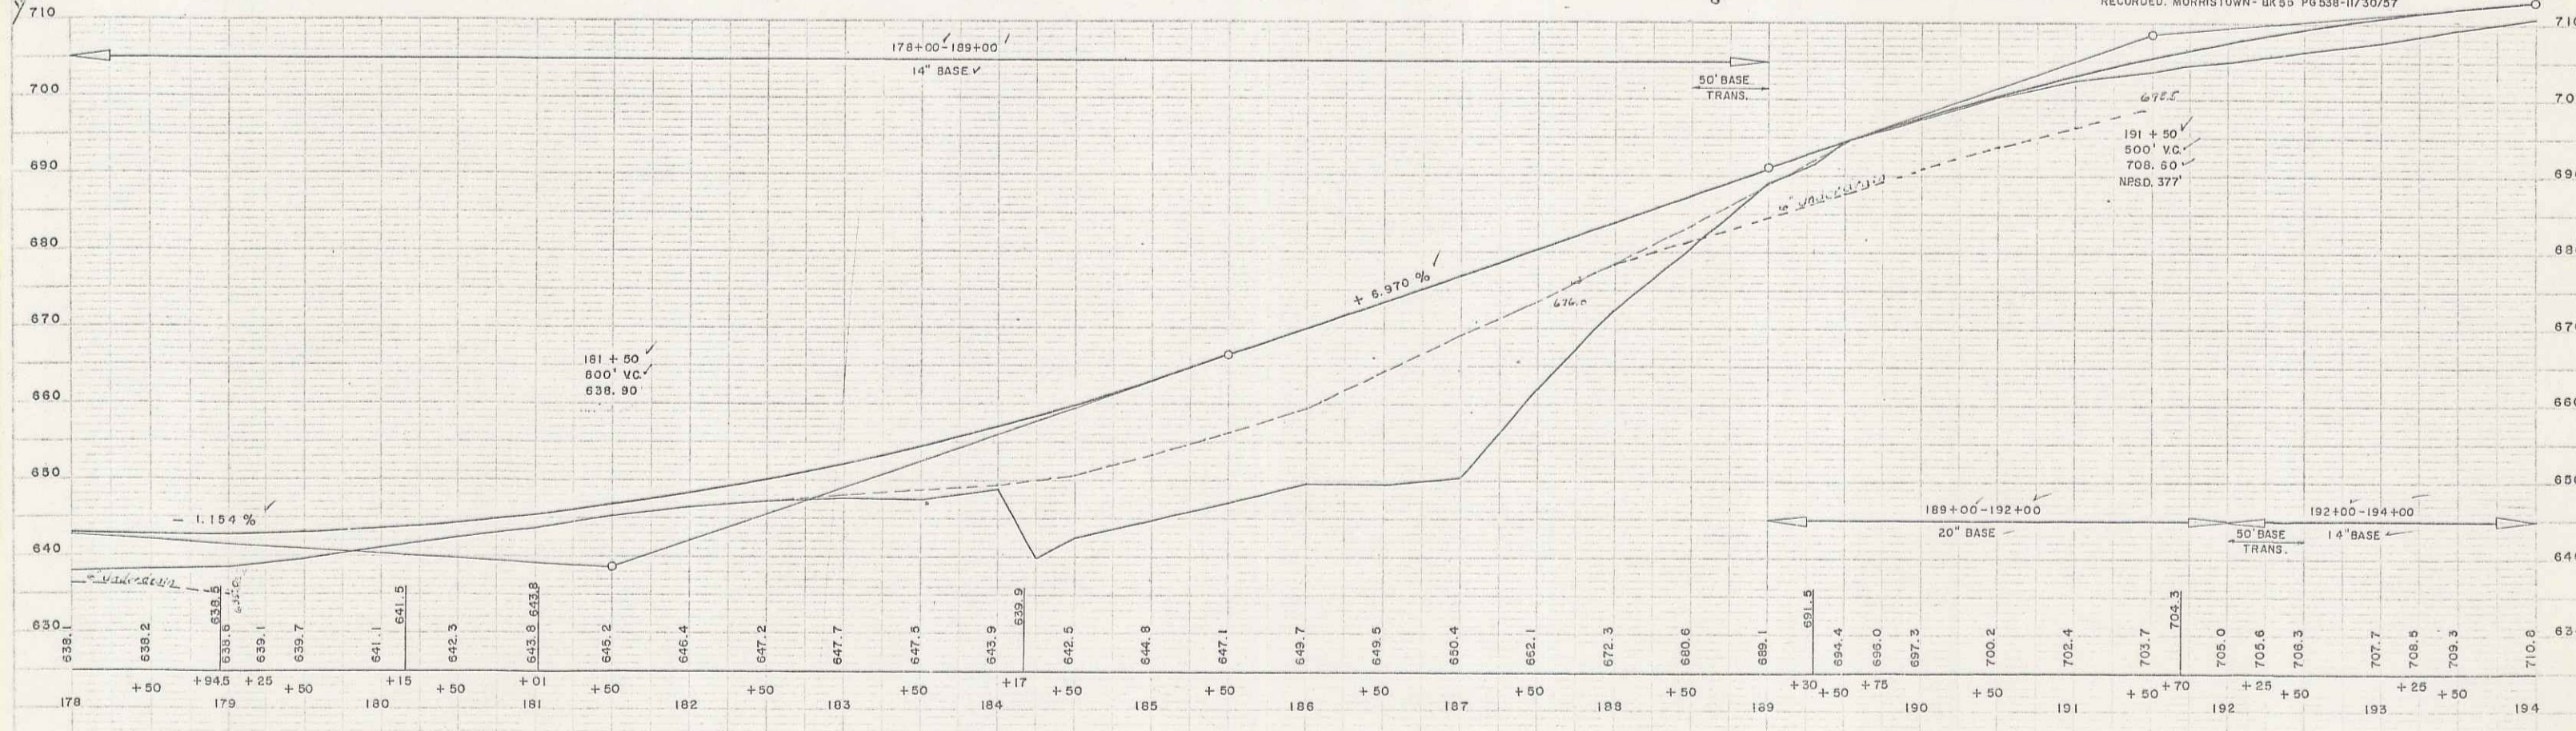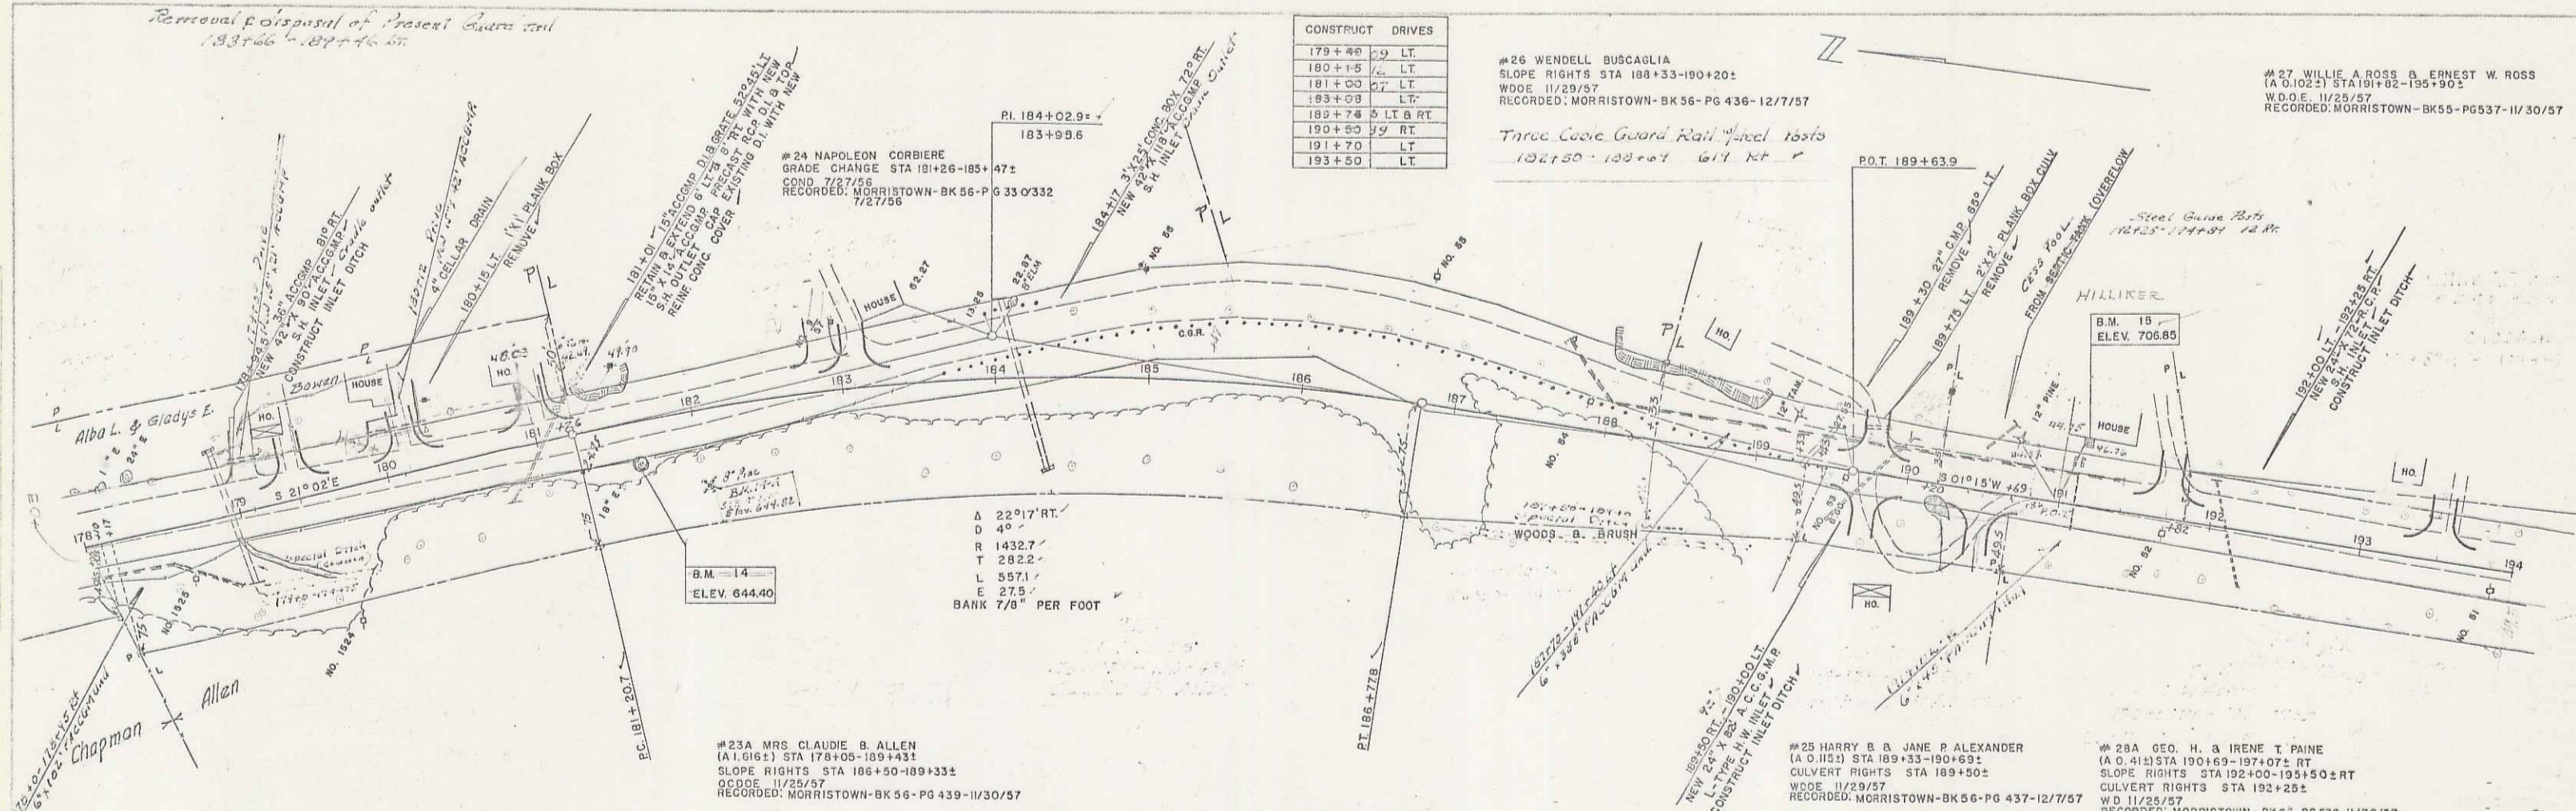

B.M. 14 20' RT. 181+00 SUR. 15" ELM. ELEV. 644.40. B.M. 14 SUR. 15" ELM. 182+01 SUR. 644.25

B.M. 15 39' LT. 191+17 R.O.C. TOP CONCRETE STEP OF HOUSE ELEV. 708.85

HYDE PARK - MORRISTOWN F 39(2)
SHEET 20 OF 133