




DELANO WESTER-MARTIN, INC. 1-55

DELANO WESTER-MARTIN, INC. 1-55

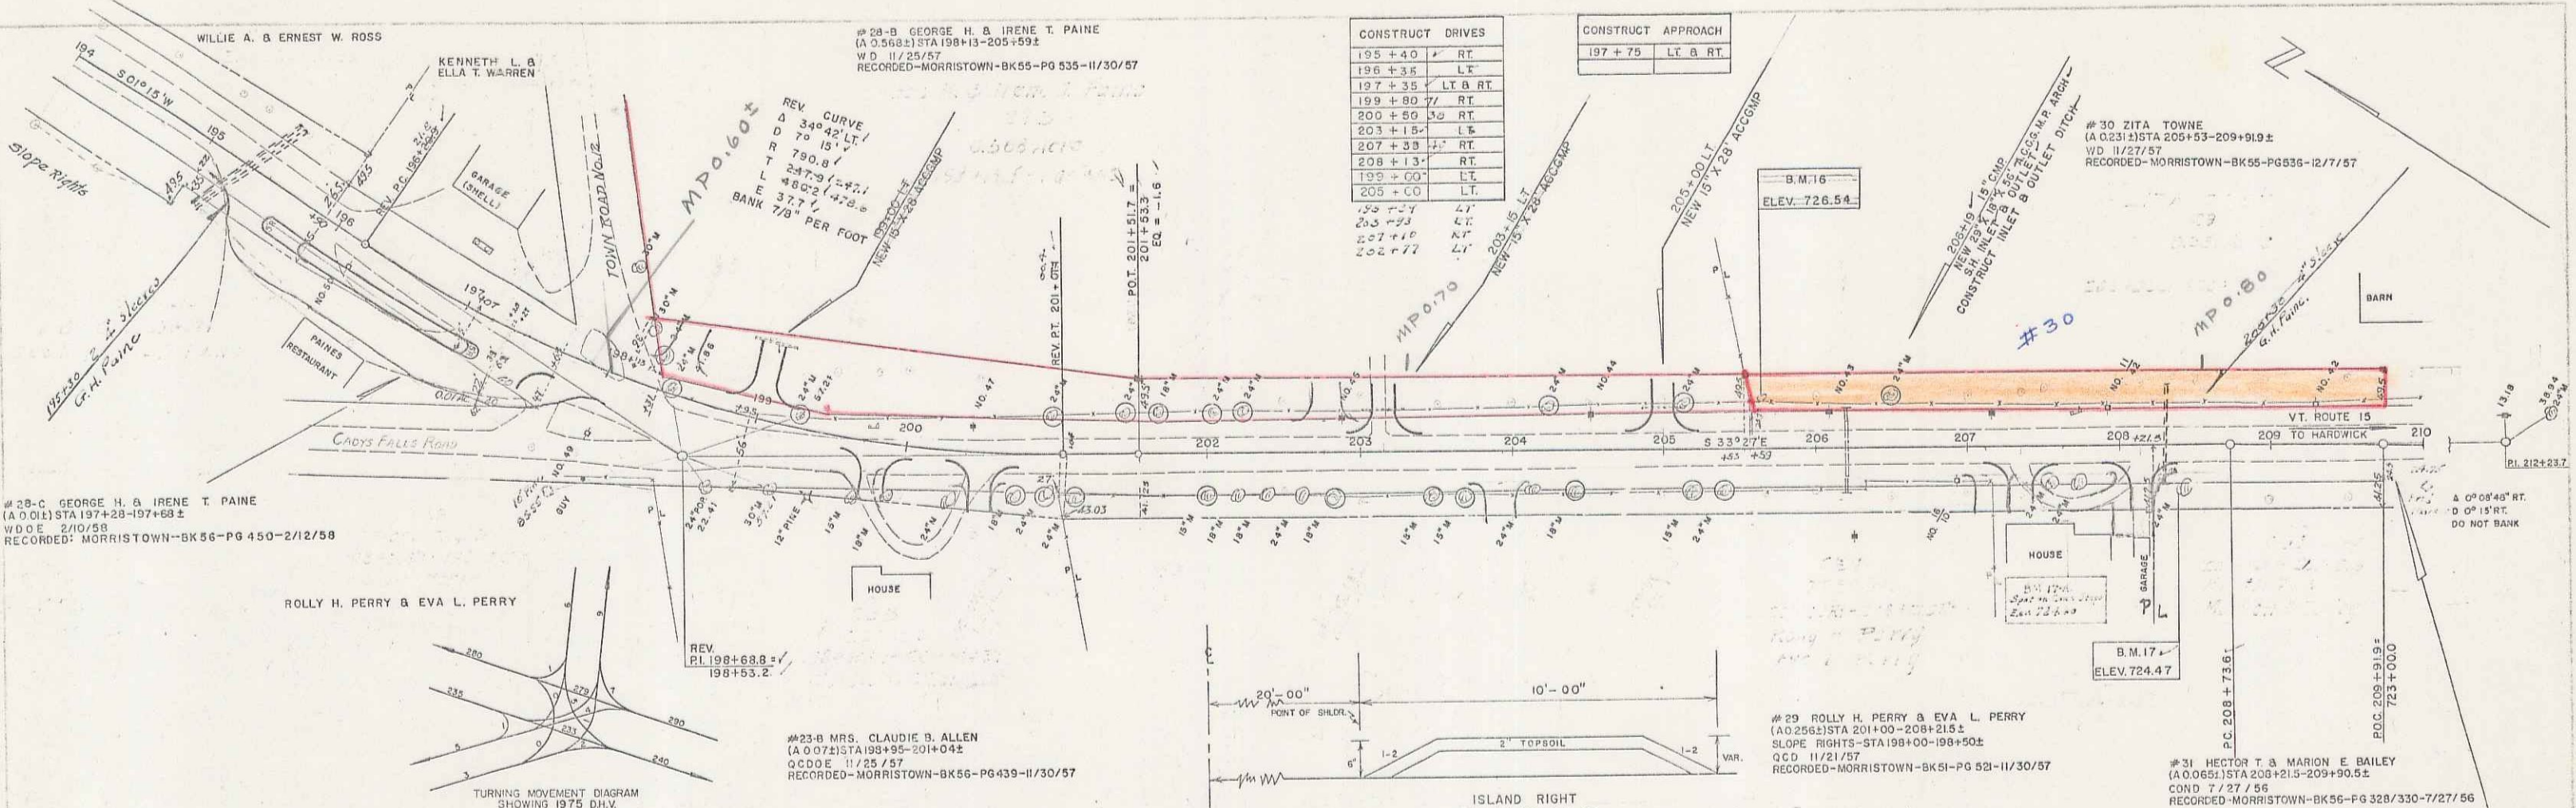

CONSTRUCT DRIVES	
195 + 4.0	RT
196 + 3.5	LT
197 + 3.5	LT & RT
199 + 8.0	RT
200 + 8.0	RT
203 + 1.5	LS
207 + 3.0	RT
208 + 1.3	RT
190 + 0.0	LT
205 + 0.0	LT
205 + 2.7	LT
203 + 2.1	LT
207 + 1.0	RT
202 + 7.7	LT

CONSTRUCT APPROACH	
197 + 7.5	LT & RT

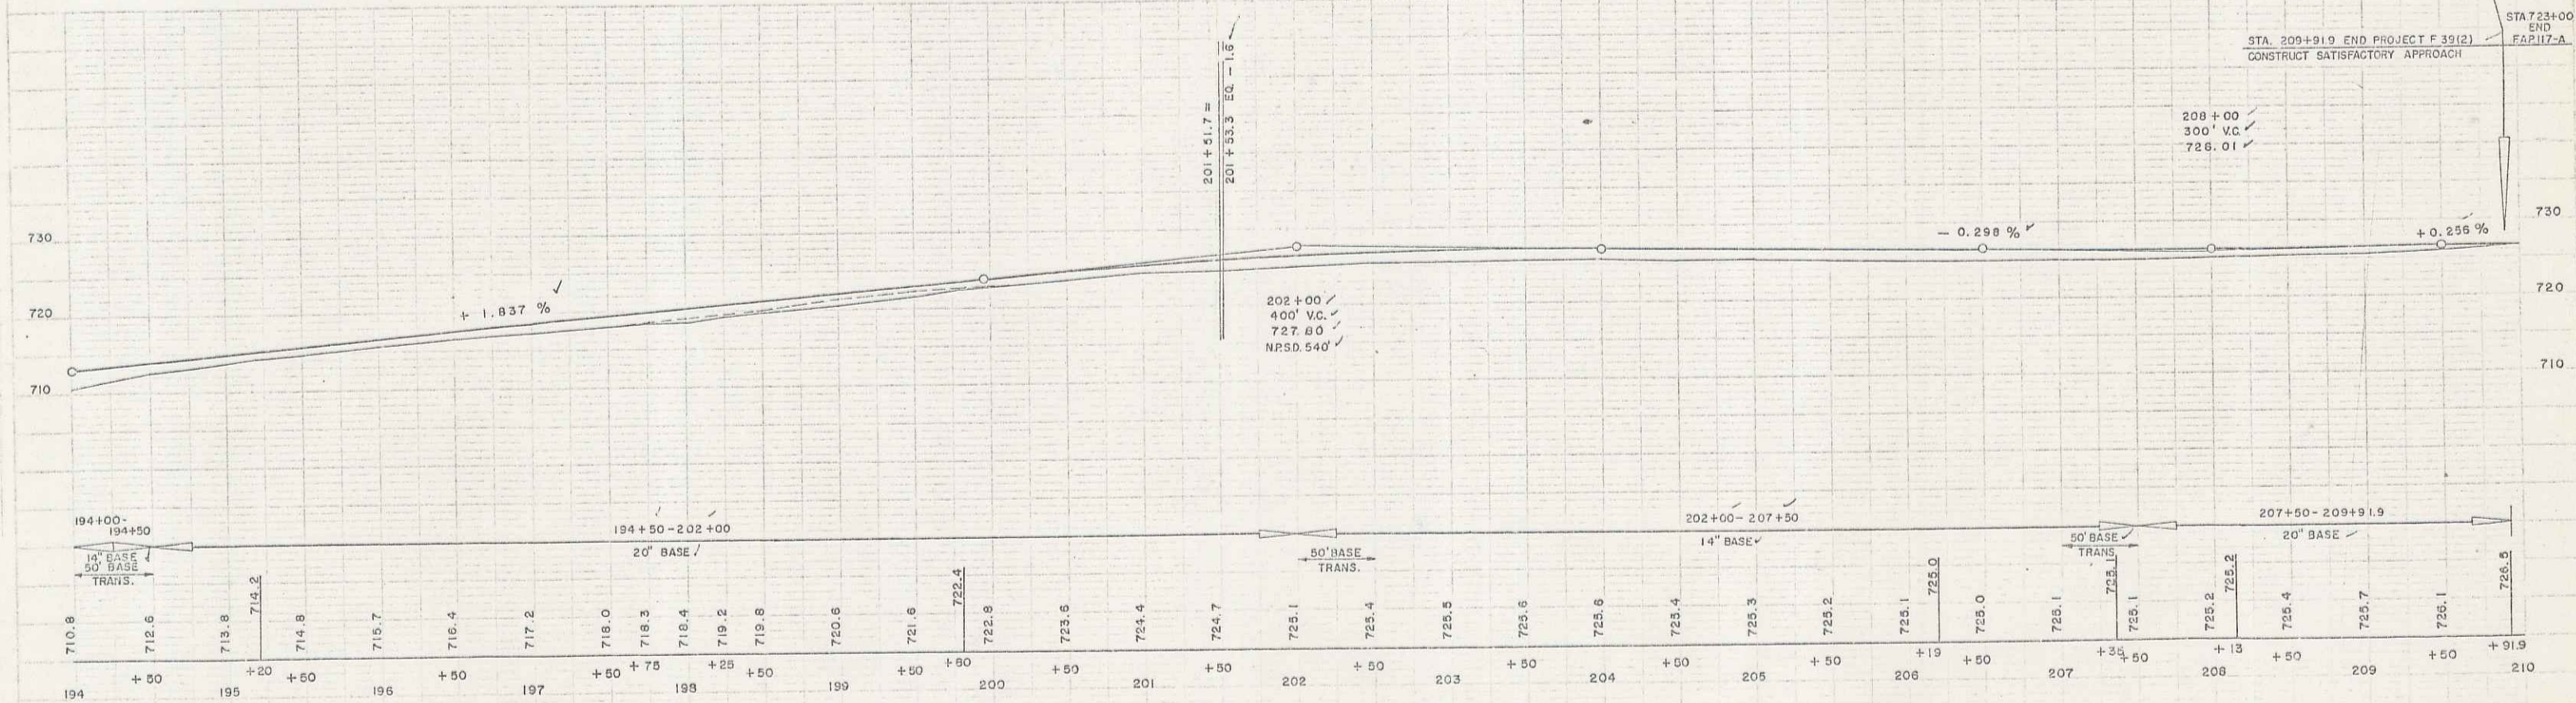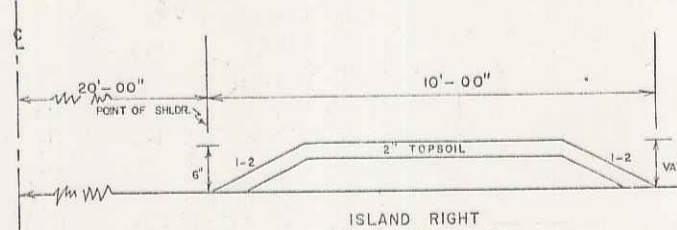

HYDE PARK - MORRISTOWN F39(2)
 SHEET 21 OF 133
 B.M. 16 29' LT. 205 + 03 SPIKE IN TOP STUMP ELEV. 726.54
 B.M. 17 S.R. 24' MAPLE 28' RT 203 + 40 ELEV. 724.47 = 724.53 OLD B.M. 99

12