


PLAN
 WESTFIELD, MASS.
 WESTFIELD-MARTIN, INC.
 12-54
 1-55

PROF. A. J. DELARCO
 WESTFIELD-MARTIN, INC.
 12-54
 1-55

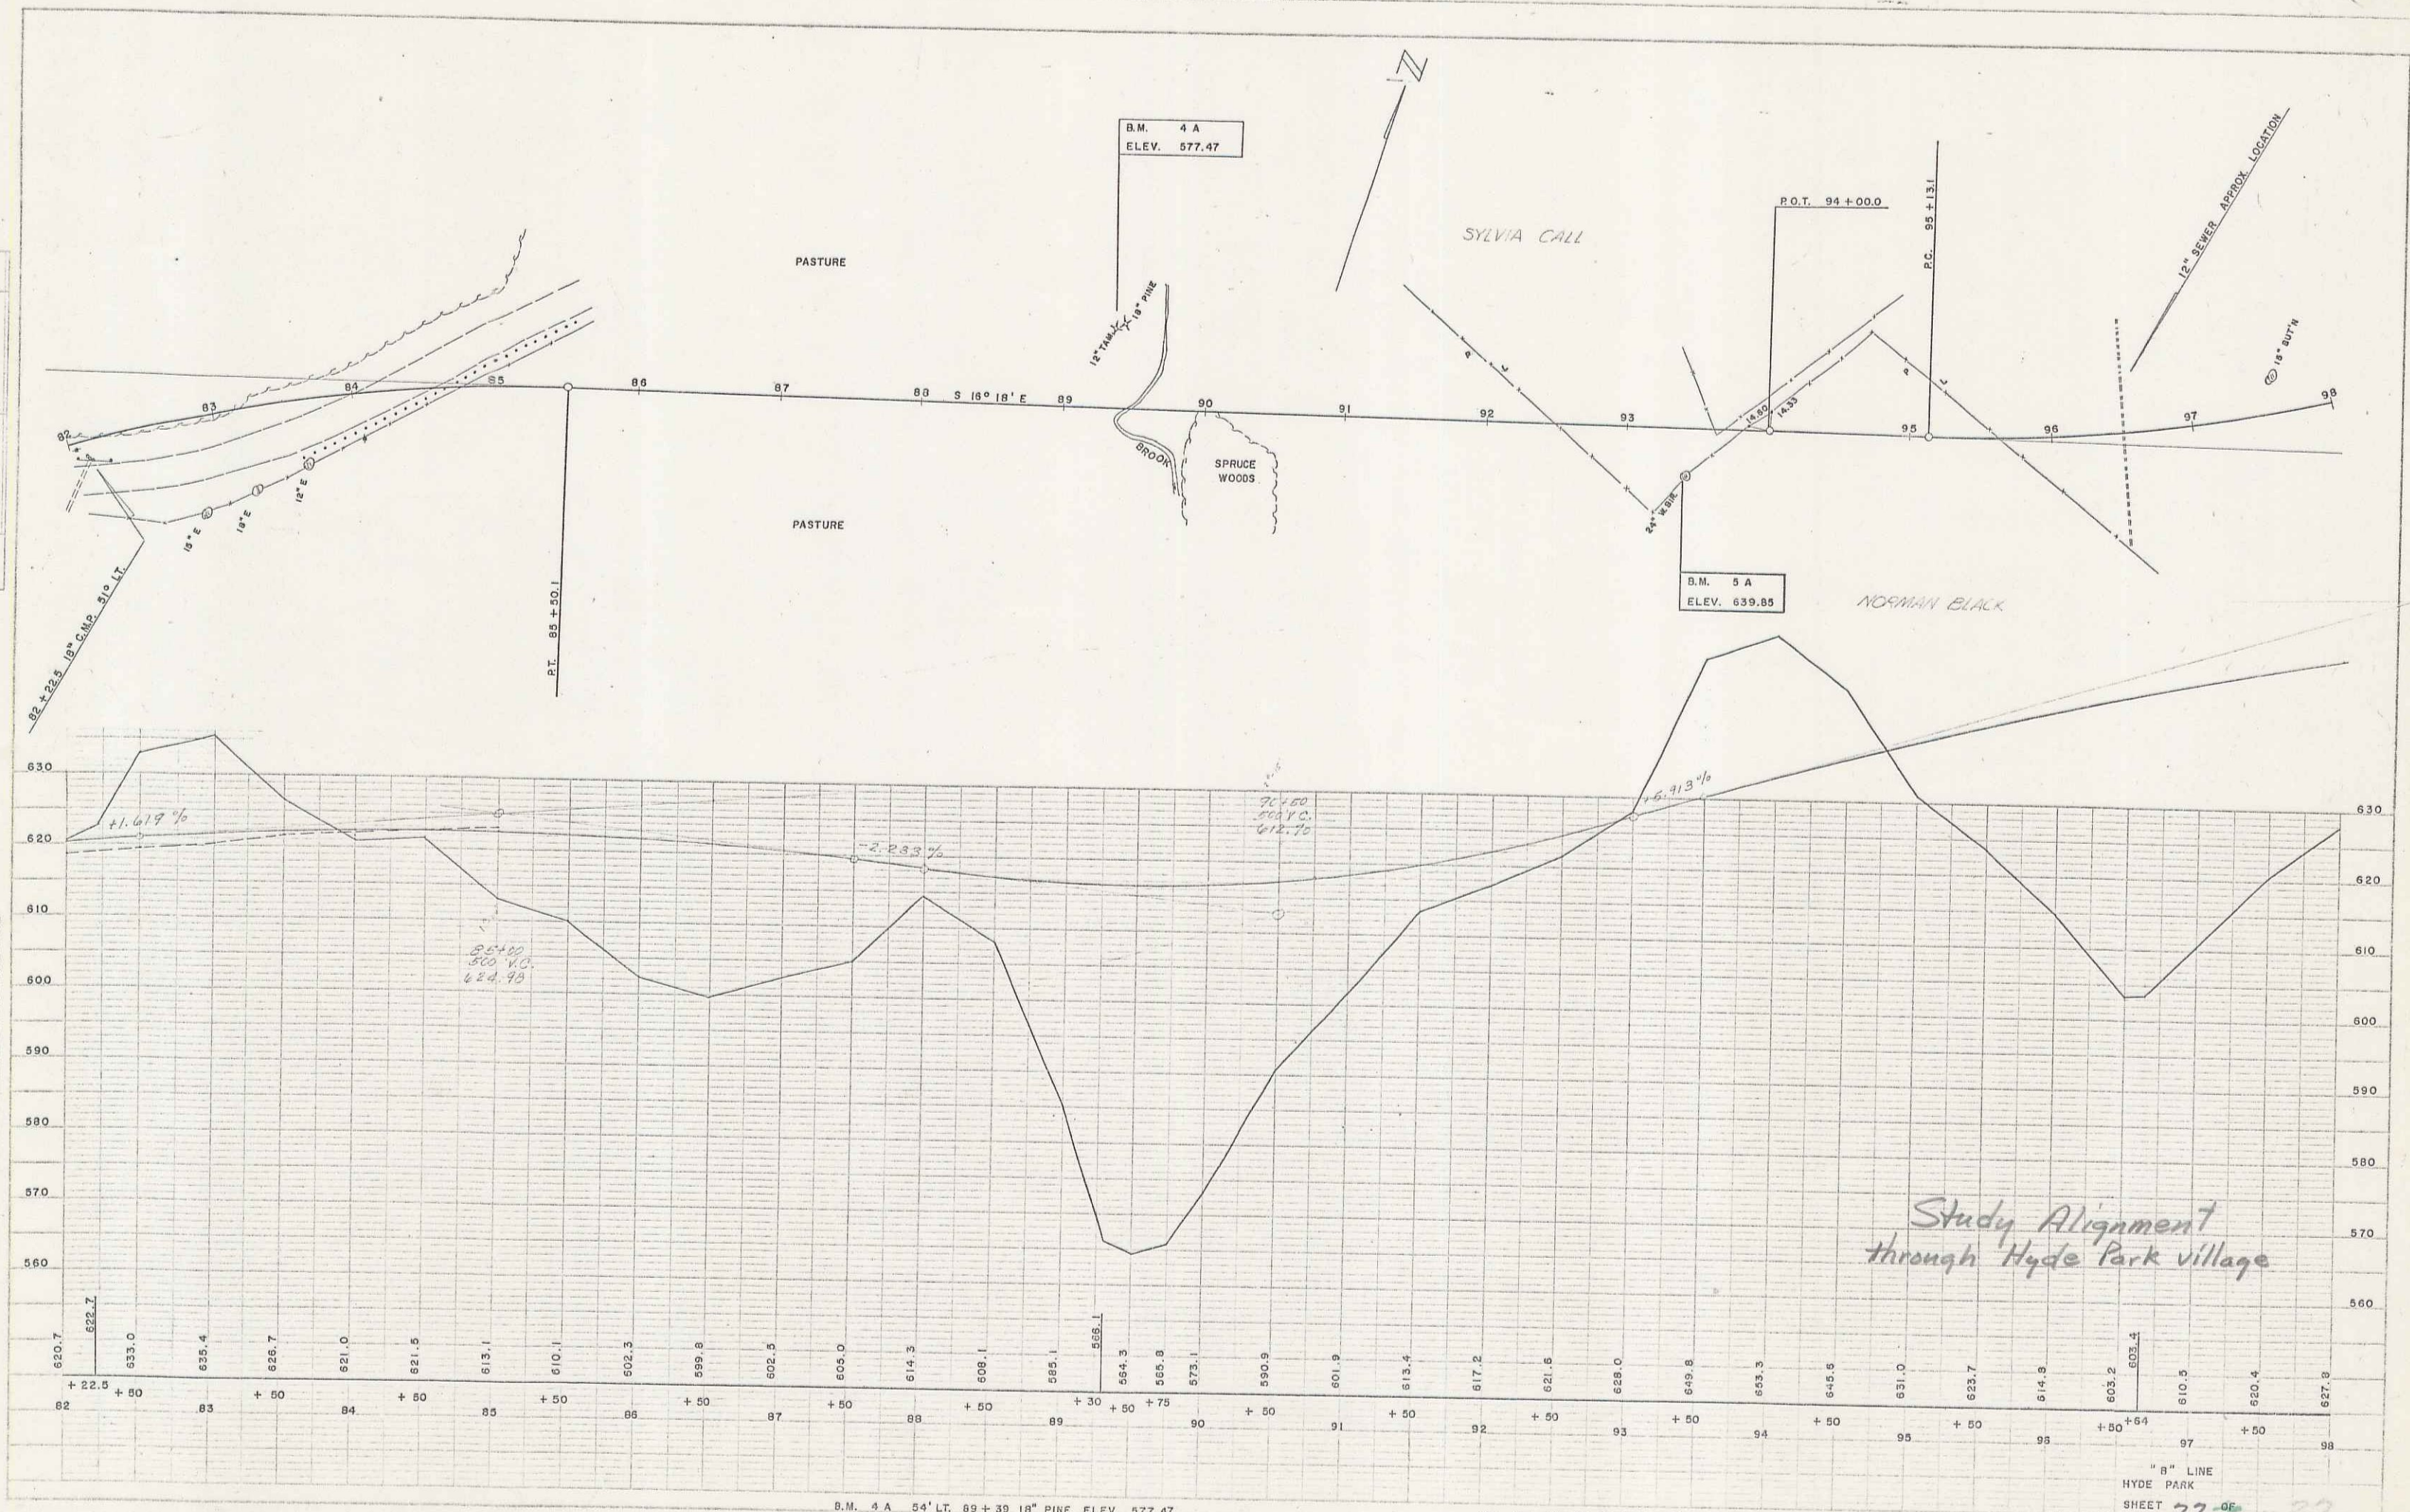

B.M. 4 A 54' LT. 69 + 39 18" PINE ELEV. 577.47
 B.M. 5 A 32' RT. 93 + 39 24" W. BIRCH ELEV. 639.85

*Study Alignment
 through Hyde Park village*

"B" LINE
 HYDE PARK
 SHEET 22-06 22

** Not built as Surveyed only 13*