


$\Delta$  21' 14" ✓  
 D 4' ✓  
 R 1432.7 ✓  
 T 260.6 ✓  
 L 530.8 ✓  
 E 25.0 ✓

Sta 577+25 to 579+05 Rt Cut slope - sand + silt TO BE TOPSOILED AND MULCHED

Sta 579+15 to 585+25 Rt Cut slope - gravel + silt TO BE TOPSOILED + MULCHED

PARCEL INSTRUMENT	DATE	GRANTOR	GRANTEE	RECORDED MORRISTOWN BOOK PAGE	REMARKS
A, B	W.D.O.E 1-27-41	ELLA BRYANT	ST OF W	48 282.5	2-8-41
C	W.D.O.E 1-27-41	BEATRICE SPALLS	ST OF W	48 282.4	1-30-41
	W.D.O.E 1-27-41	LEO & LENA B EDWIN	ST OF W	48 284.5	1-30-41

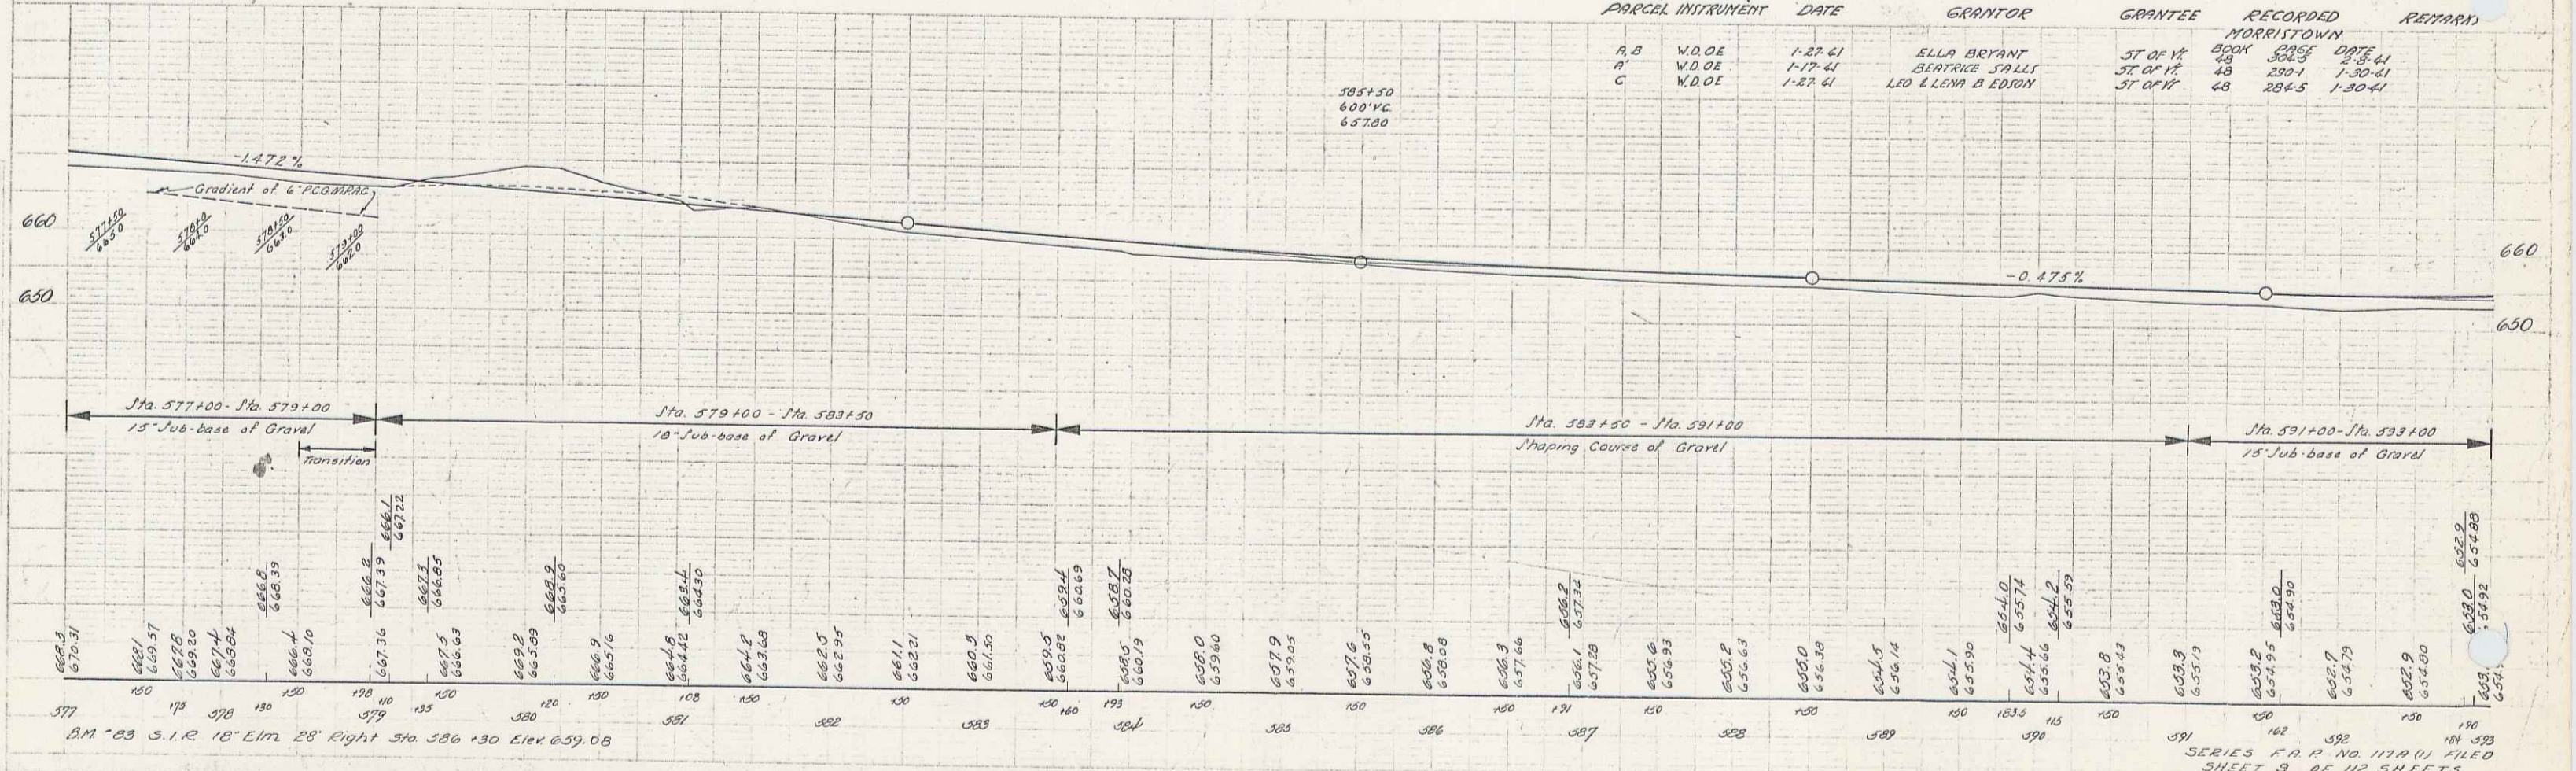

SERIES F.A.P. NO. 117A (U) FILED  
 SHEET 9 OF 112 SHEETS