
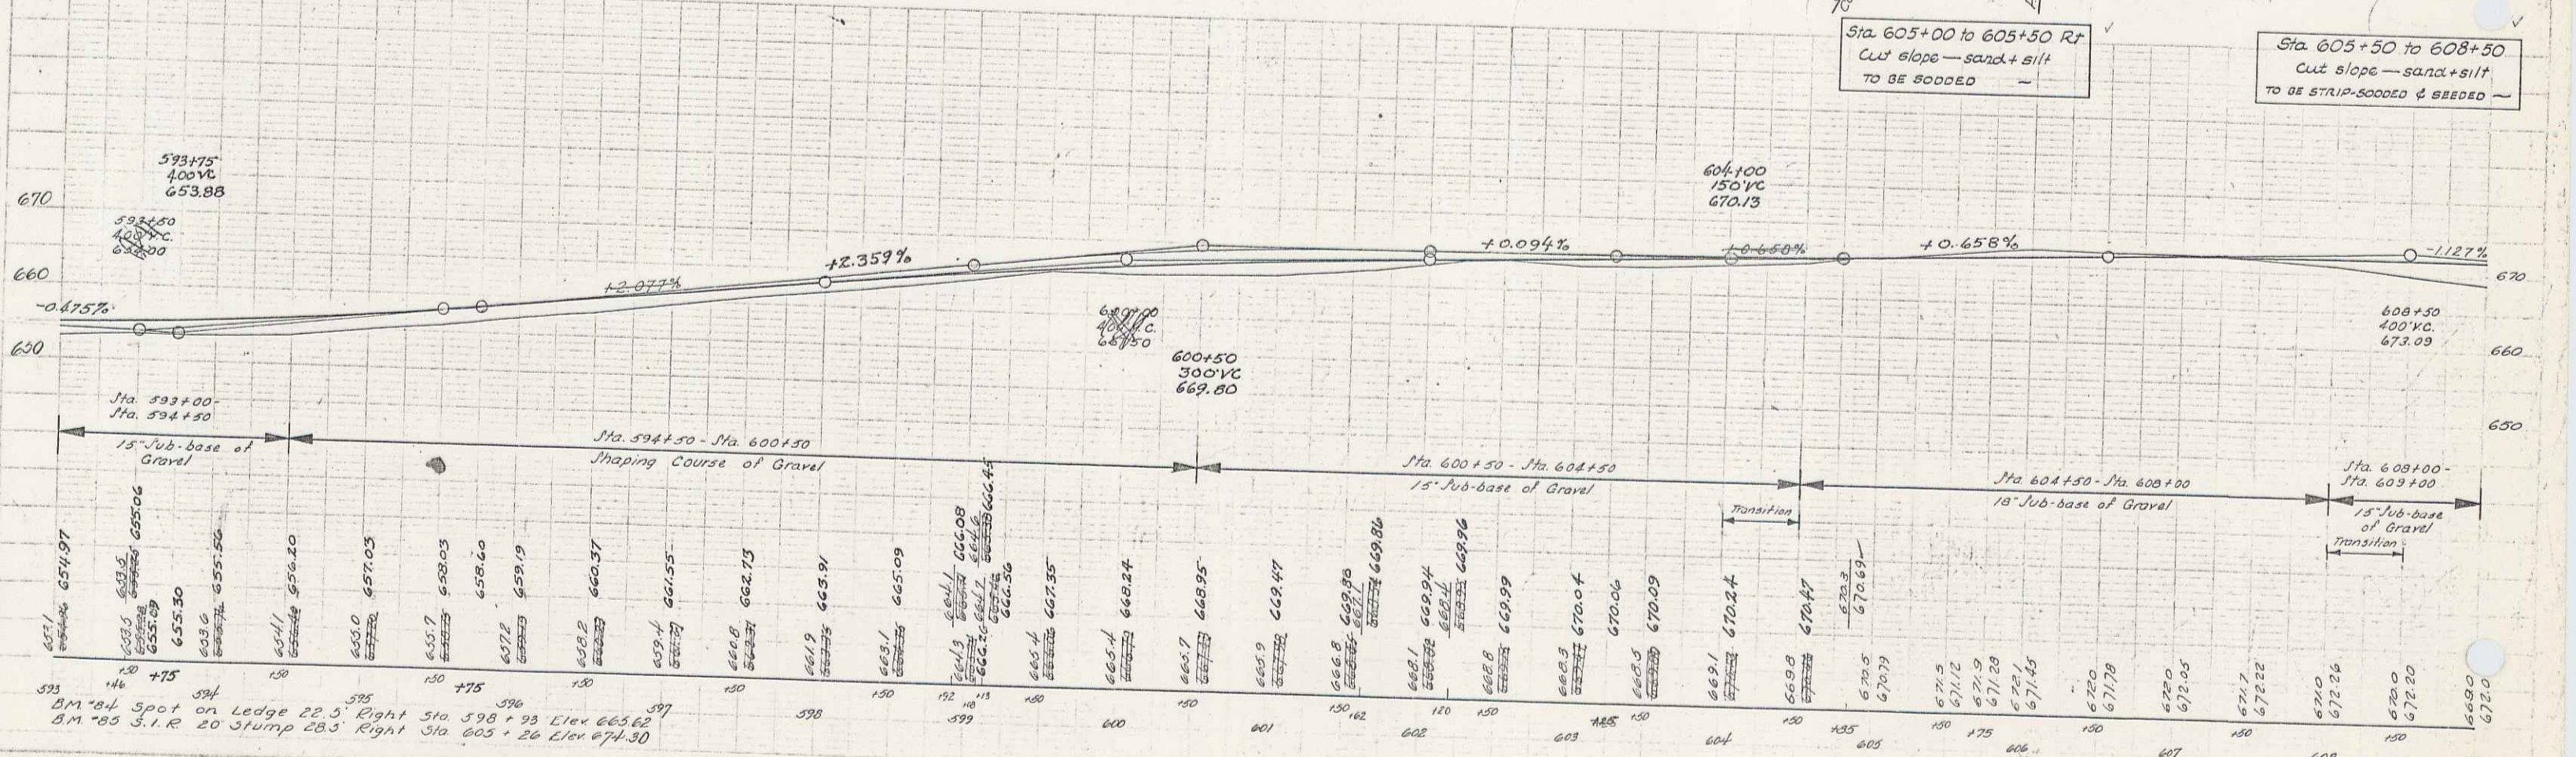


PARCEL INSTRUMENT	DATE	GRANTOR	GRANTEE	RECORDED	REMARKS
A, B	N.D.O.E.	1-27-41	C. J. L. BERTHA GUYETTE	ST. OF VT. BOOK PAGE DATE	28 286-7-8 1-30-41

STATE OF VERMONT
 PLAN NO. 117-401
 YEAR 1941
 NO. SHEETS 10

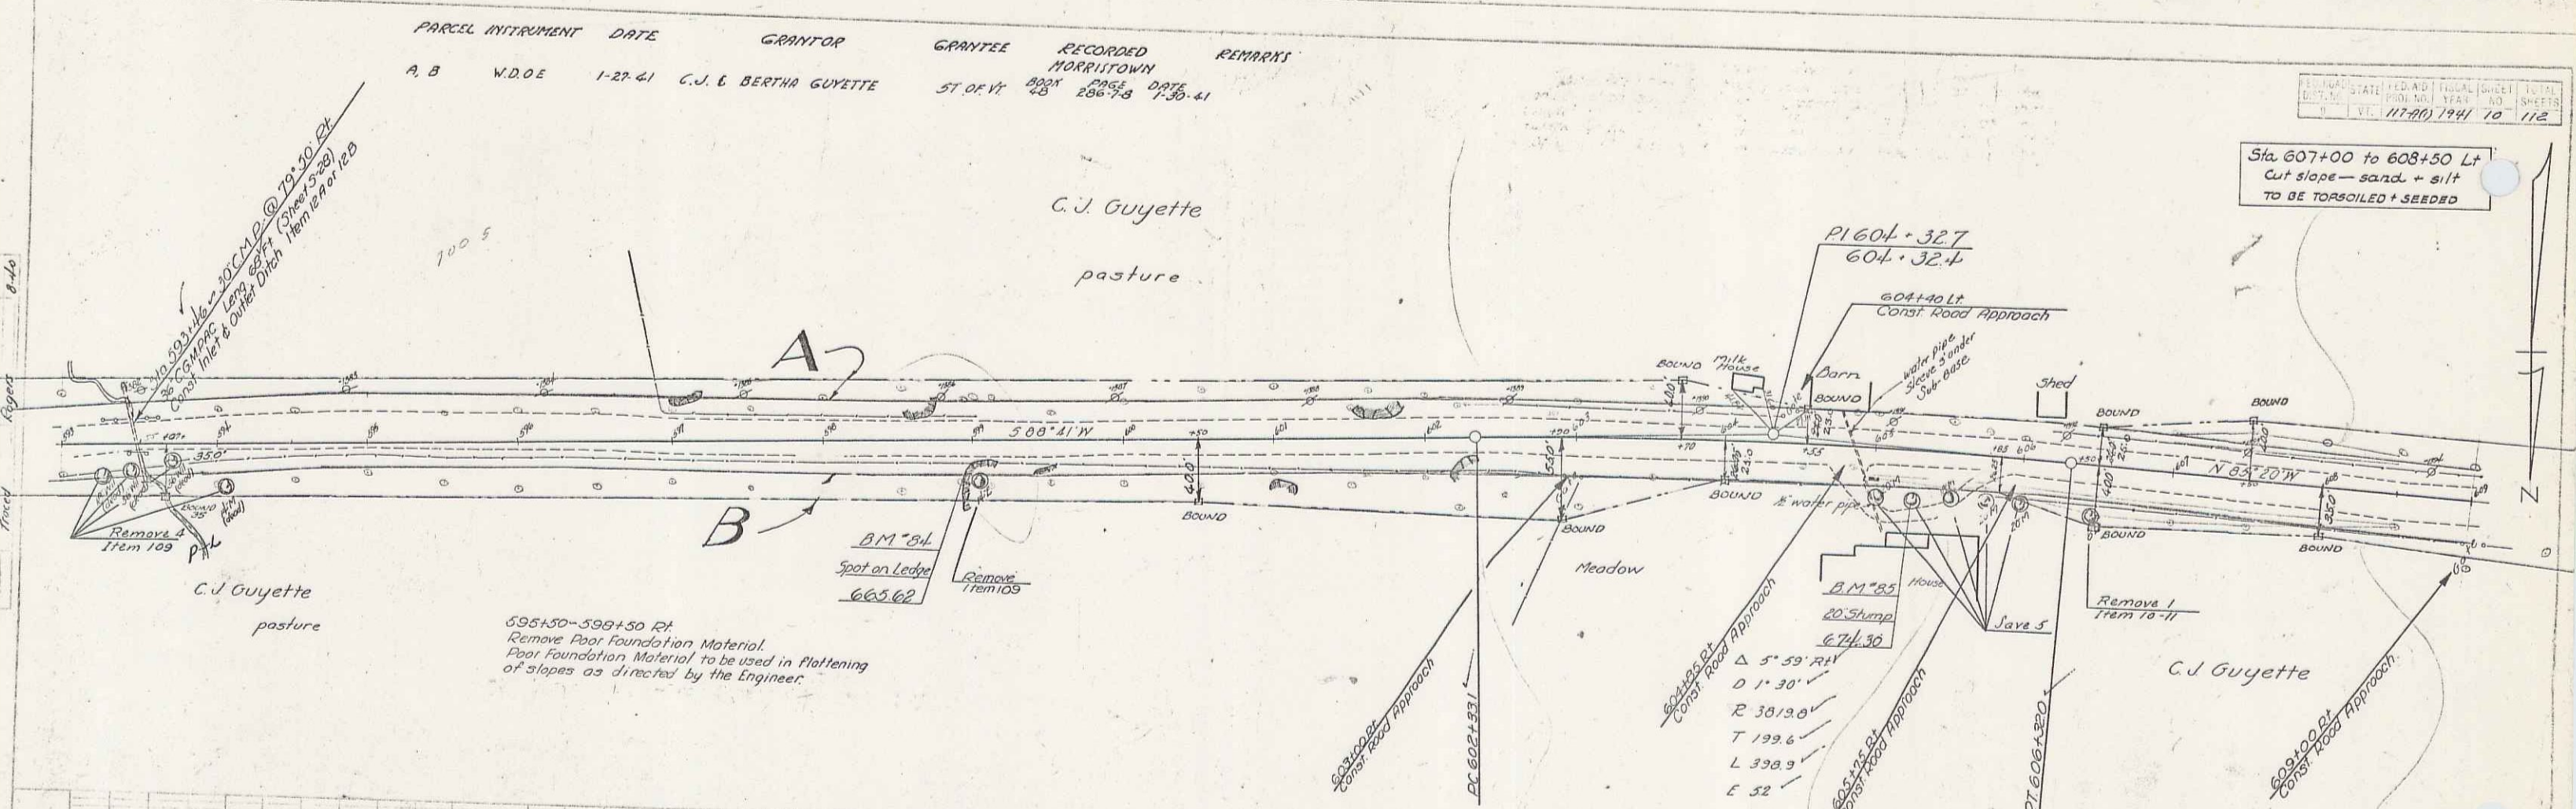

593+75 400 V.C. 653.88
 593+50 400 V.C. 653.88
 600+50 300 V.C. 669.80
 606+00 150 V.C. 670.13
 608+50 400 V.C. 673.09

Sta. 593+00 - Sta. 594+50
 15' Sub-base of Gravel

Sta. 594+50 - Sta. 600+50
 Shaping Course of Gravel

Sta. 600+50 - Sta. 604+50
 15' Sub-base of Gravel

Sta. 604+50 - Sta. 608+00
 15' Sub-base of Gravel

Sta. 608+00 - Sta. 609+00
 15' Sub-base of Gravel

BM #84 Spot on Ledge 22.5' Right Sta. 598+93 Elev 665.62
 BM #85 3.1 R 20' Slump 28.5' Right Sta. 603+20 Elev 674.30

247
 SERIES K A P NO. 117-401 FILED
 SHEET 10 OF 112 SHEETS