
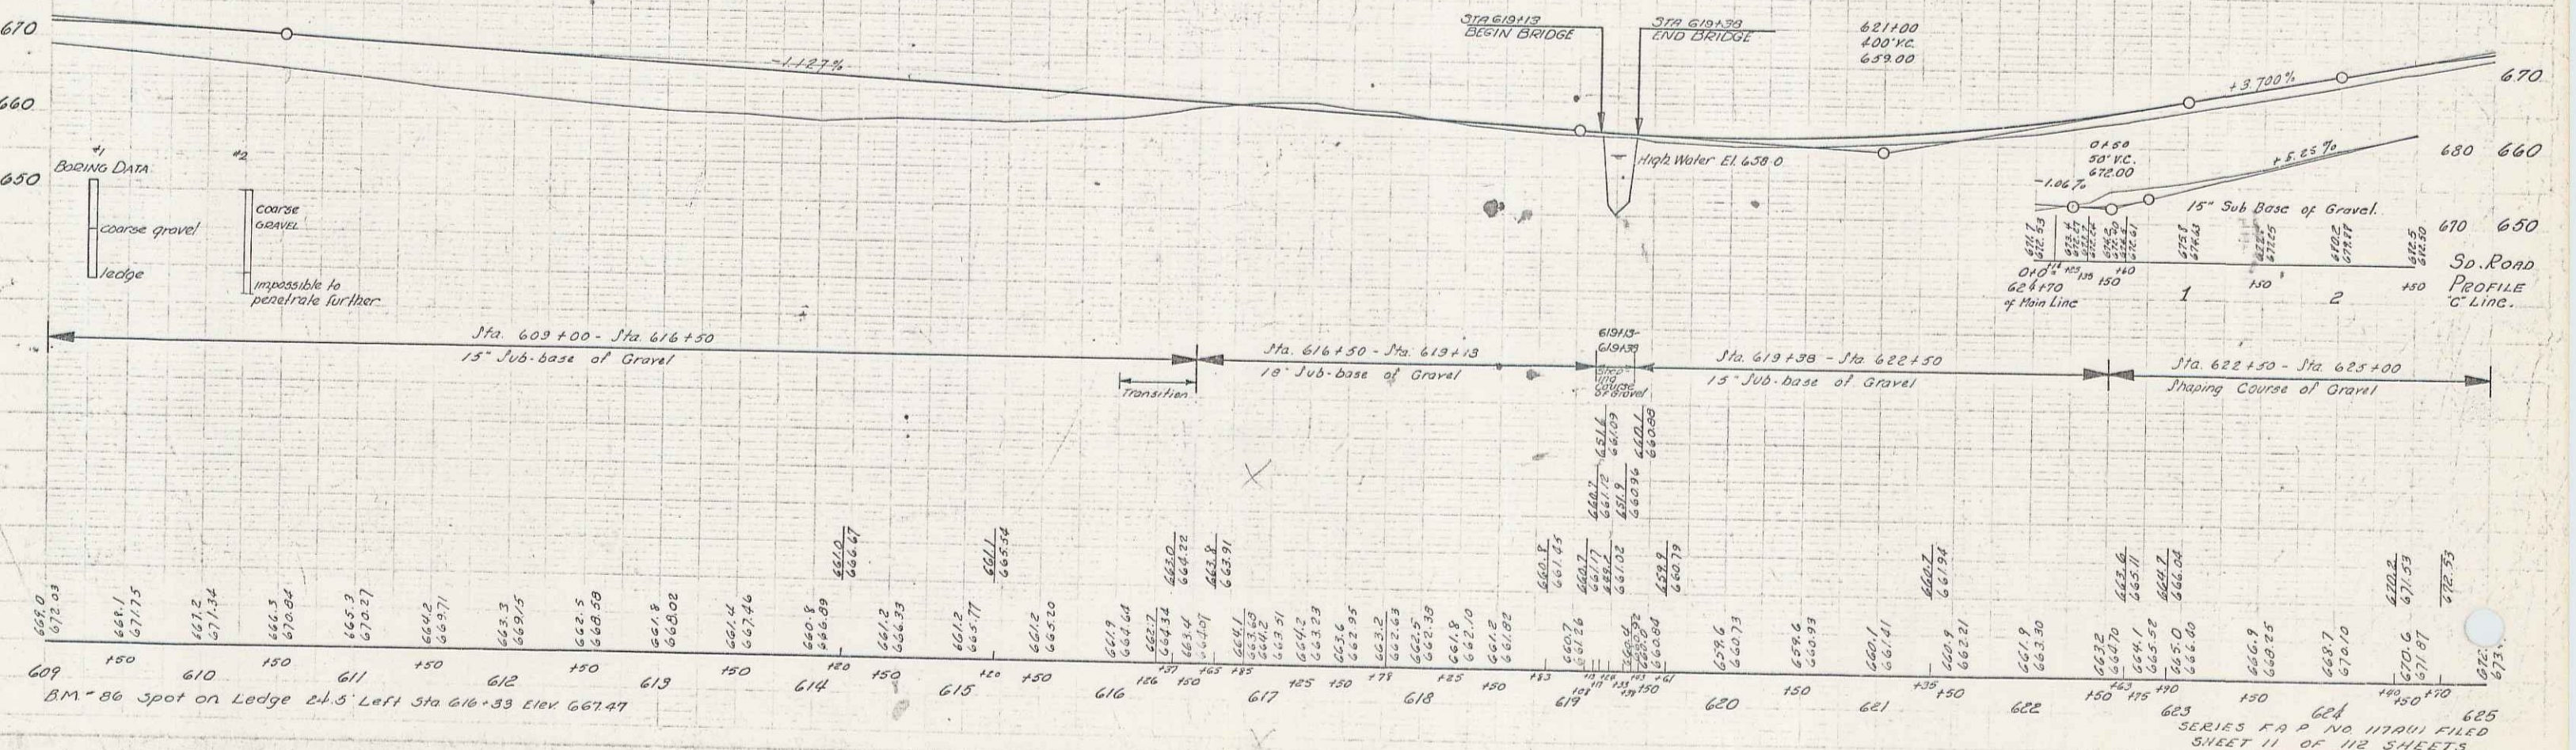


PARCEL INSTRUMENT	DATE	GRANTOR	GRANTEE	RECORDED	REMARKS
C.D.	W.D. 06	1-27-41	C.J. & BERTHA GUYETTE	ST. OF VT. 280X	PAGES 0233
A, B, C'	W.D. 06	1-27-41	MARGUERITE BILLINGS	ST. OF VT. 48	281-23 130-41
C.D. 06	W.D. 06	1-27-41	C.H. STAFFORD & SONS INC.	ST. OF VT. 48	306-78 2-8-41
A'	W.D. 06	2-28-41	M.E. L.B.G. BRIGHAM	ST. OF VT. 48	344-43 3-3-41

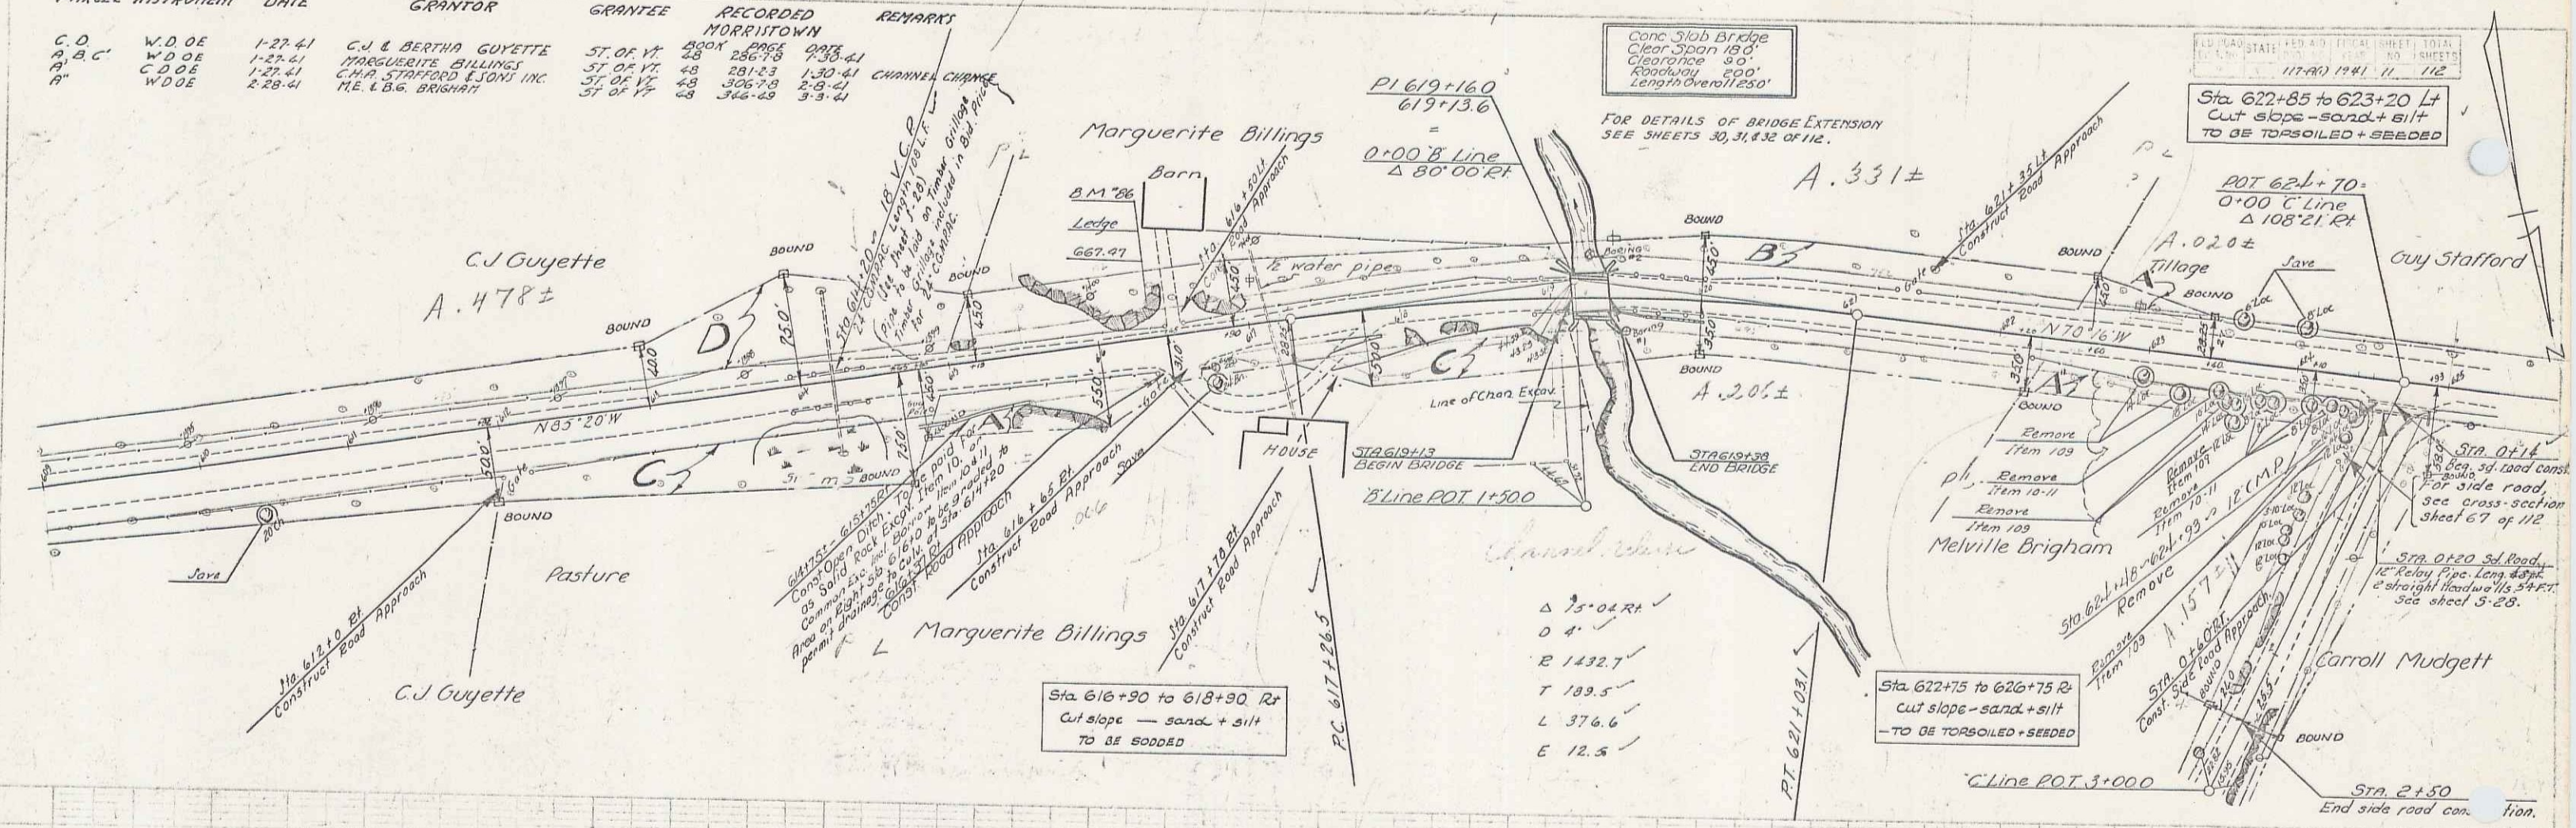

SERIES R.P. NO. 11741 FILED SHEET 11 OF 112 SHEETS