
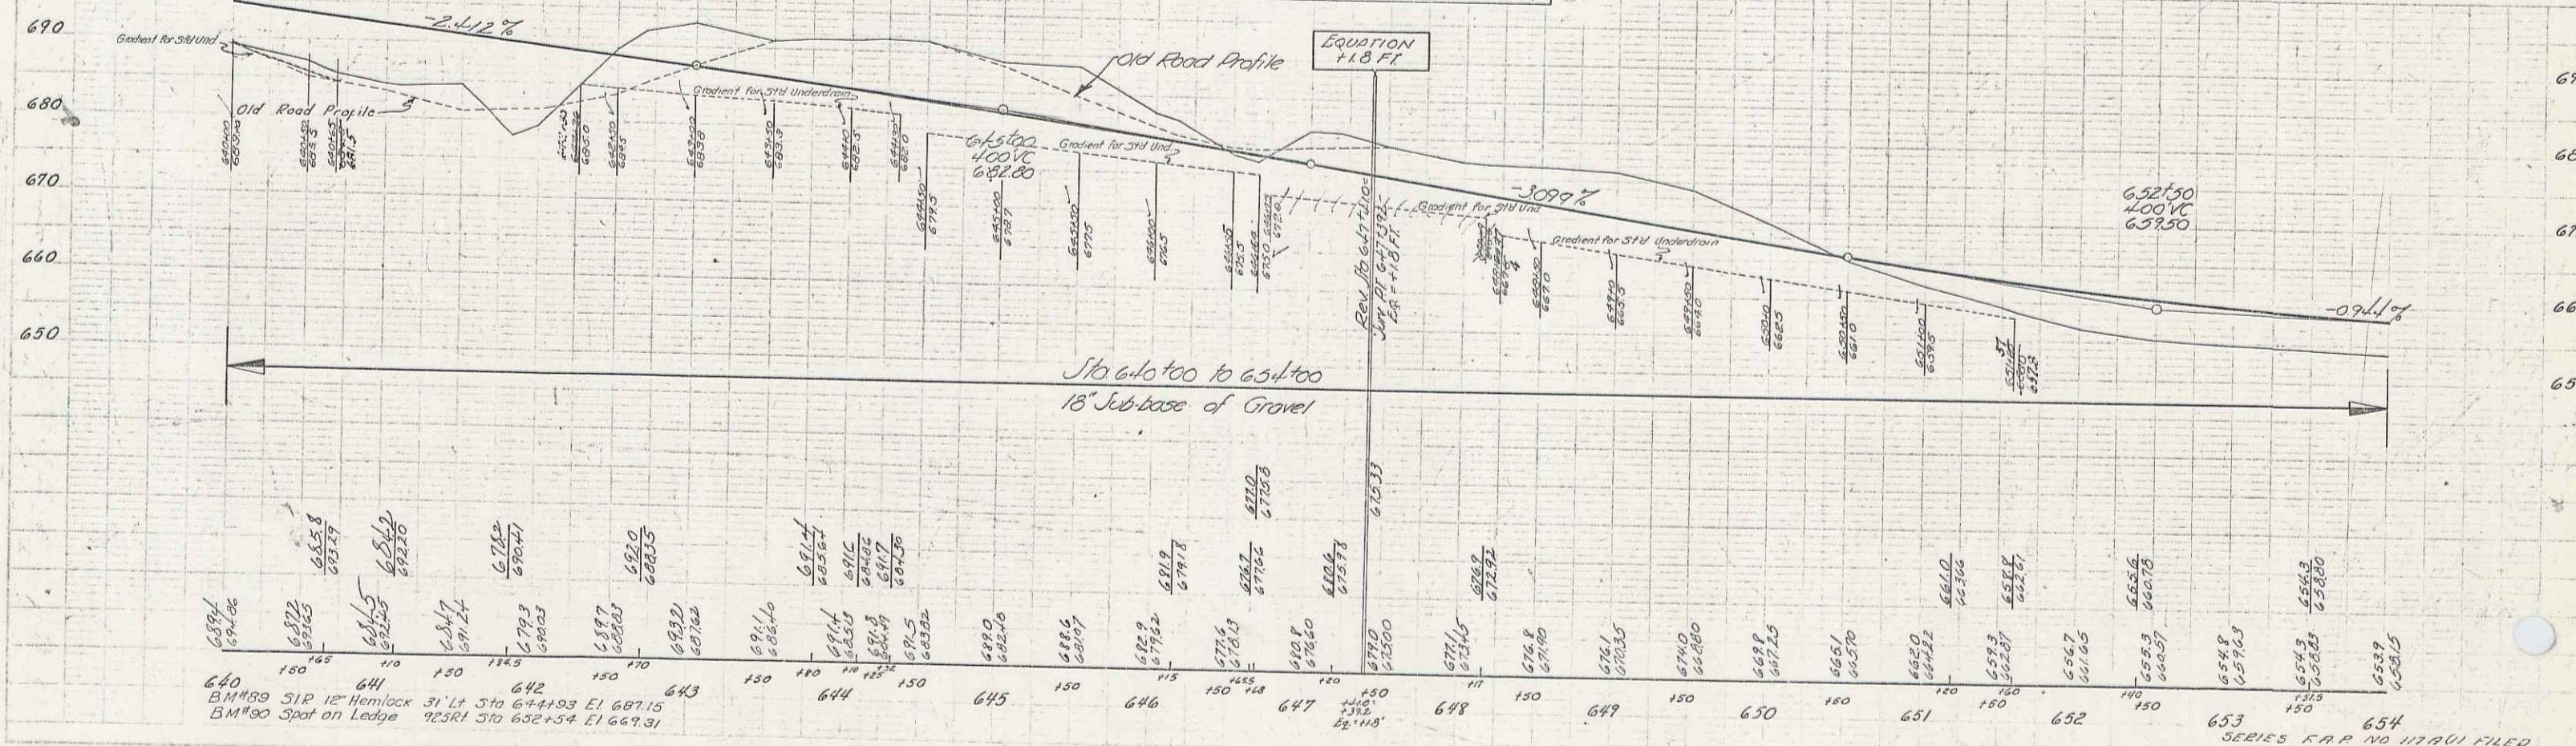


PARCEL INTRUMENT DATE	GRANTOR	GRANTEE	RECORDED	REMARKS
643100-645100	B-D W.D.O.E. 2.28.41	M.E. & B.G. BRIGHAM	ST. OF VT. BOOK 98 PAGE 92	MORRISTOWN

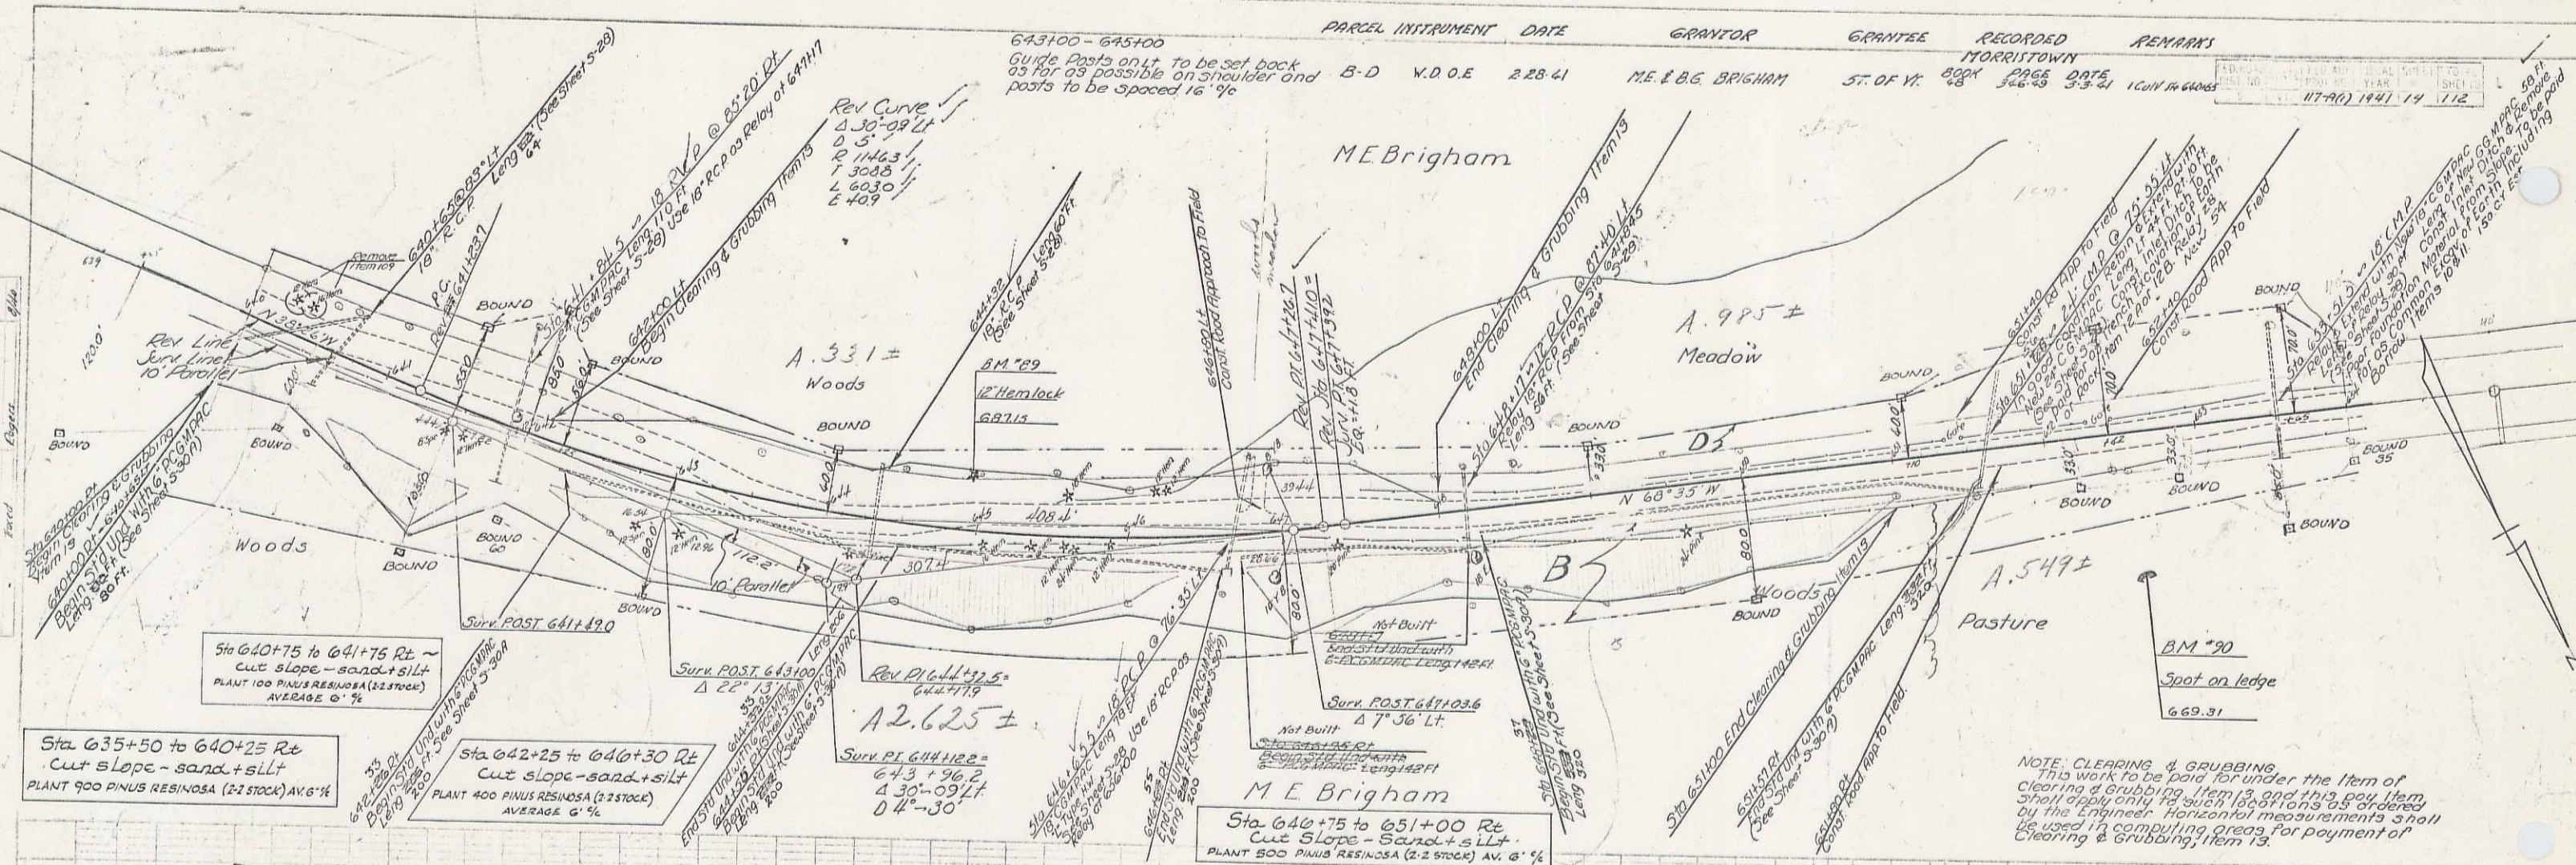

NOTE CLEARING & GRUBBING  
This work to be paid for under the item of Clearing & Grubbing, Item 13, and this pay item shall apply only to such locations as ordered by the Engineer. Horizontal measurements shall be used in computing areas for payment of Clearing & Grubbing, Item 13.

BRUNETT  
BAUNELLE  
CLARK

8-10  
8-10  
8-10

BM 189 51R 12" Hemlock 31' LT Sta 644+93 El 687.15  
BM 190 Spot on Ledge 925R1 Sta 632+54 El 669.31

653 654  
SERIES R.A.P. NO. 17101 FILED  
SHEET 14 OF 12 SHEETS