
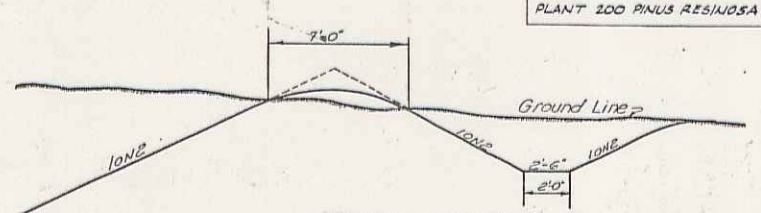



PARCEL INSTRUMENT DATE GRANTOR GRANTEE RECORDED REMARKS
 A.B. W.D.O.E. 2-3-61 O.D. & ADELIAE MATTHEWS ST. OF VT. BOOK PAGE DATE
 28 365 123 2-15-61

RECORDED STATE FILED AS PUBLIC RECORDS
 117-80 1961 16 112

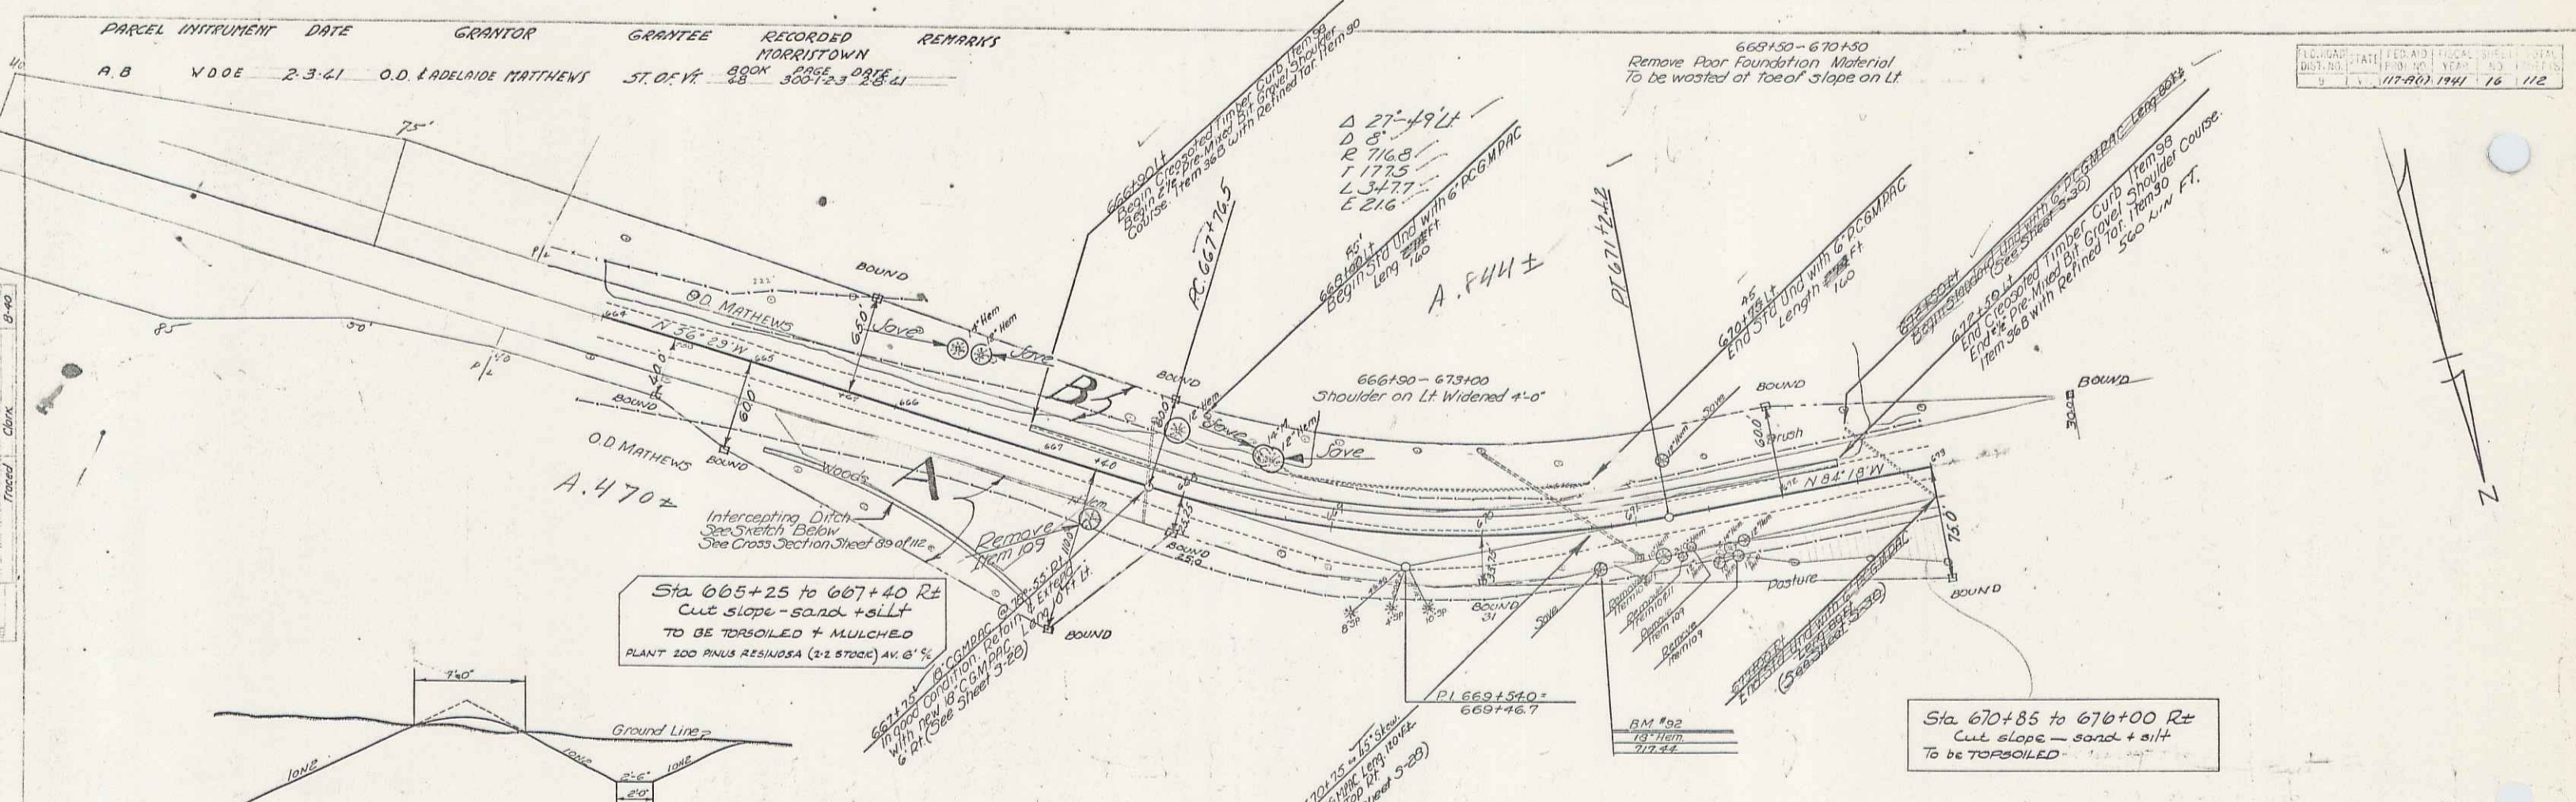

Sta 665+25 to 667+40 Rt
 Cut slope - sand + silt
 TO BE TORSOILED + MULCHED
 PLANT 200 PAULUS RESINOSA (3-2 57000) AT 6"

Sta 670+85 to 670+00 Rt
 Cut slope - sand + silt
 TO BE TORSOILED

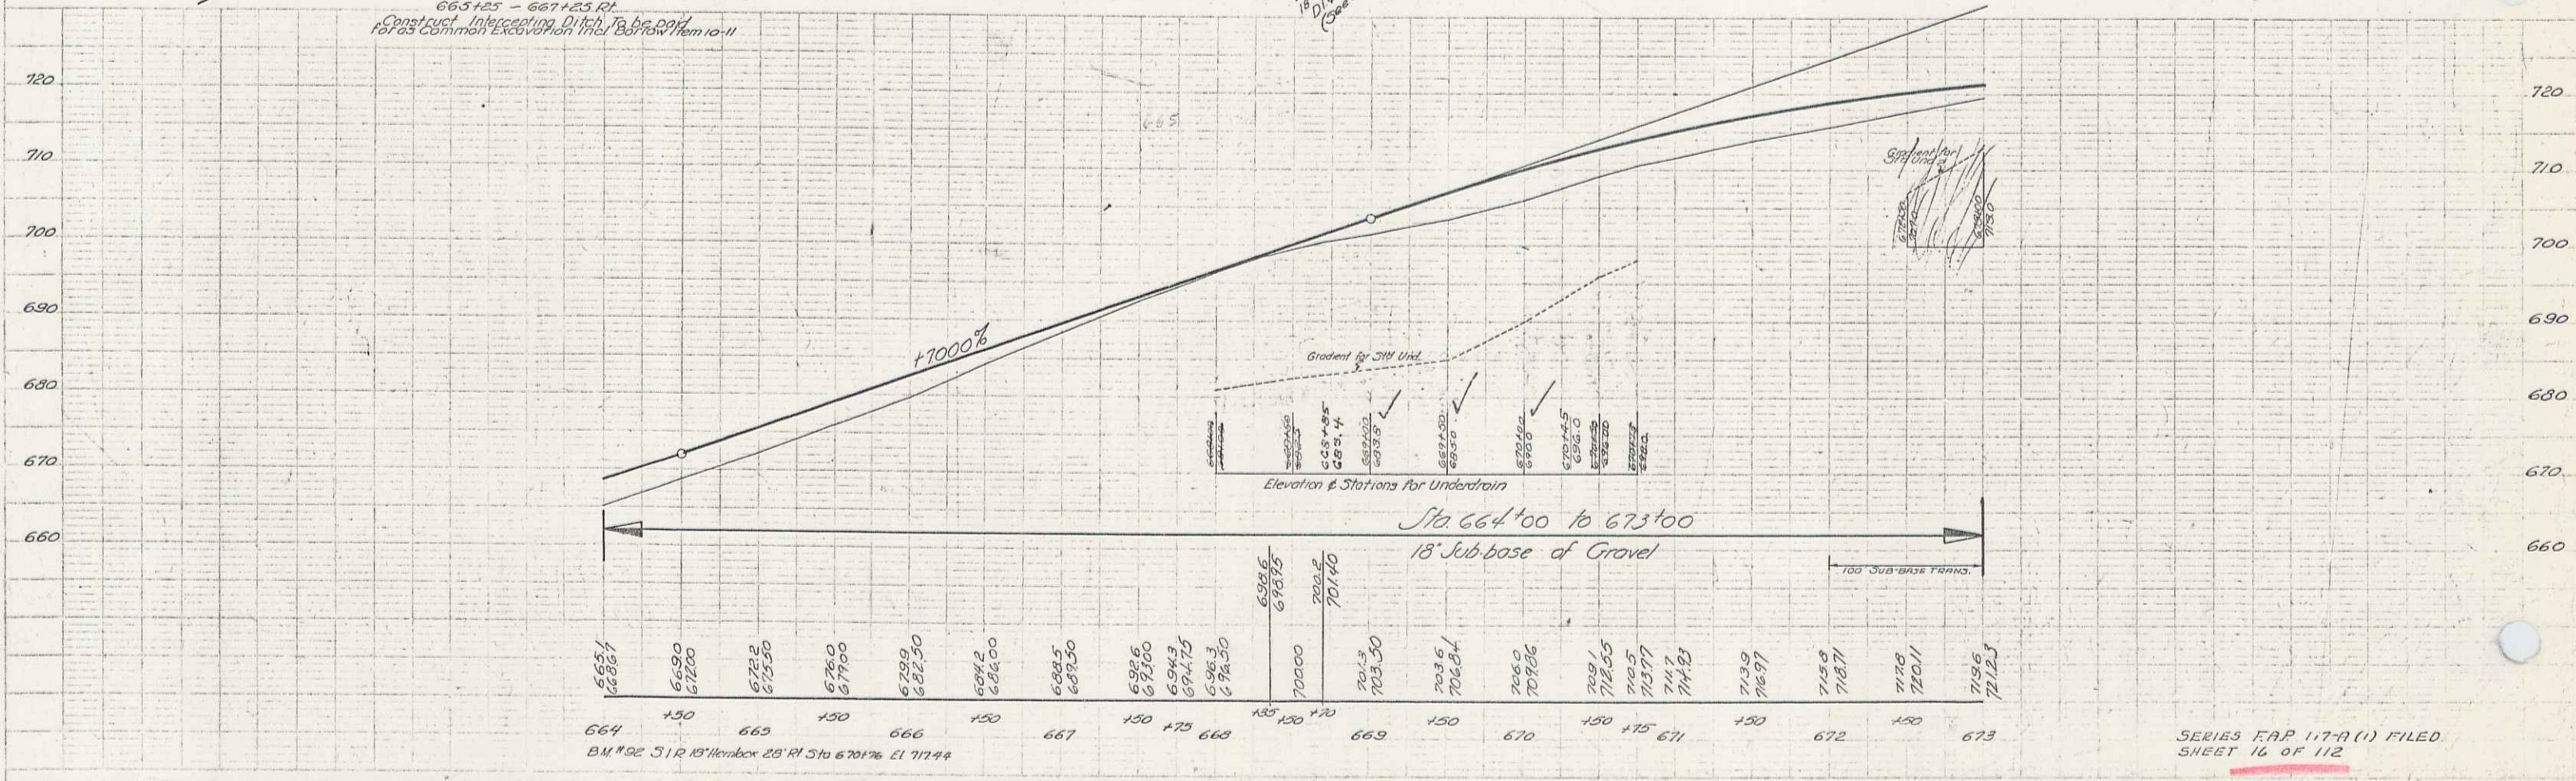

SERIES EAP 117-A(1) FILED
 SHEET 16 OF 112

13