


PARCEL INSTRUMENT	DATE	GRANTOR	GRANTEE	RECORDED	REMARK
C.D.E A	WOOE WOOE	2-3-41 1-27-41	O.D. & ADELAIDE MATTHEWS HOWARD H. & FRANCES LYON	ST OF VT BOOK PAGE DATE 48 3001-3 2-28-41 48 339-40 2-15-41	MORRISTOWN

FED. ROAD DIST. NO.	STATE	FED. AID FISCAL YEAR	SHEET NO.	TOTAL SHEETS
	VT	1947	17	712

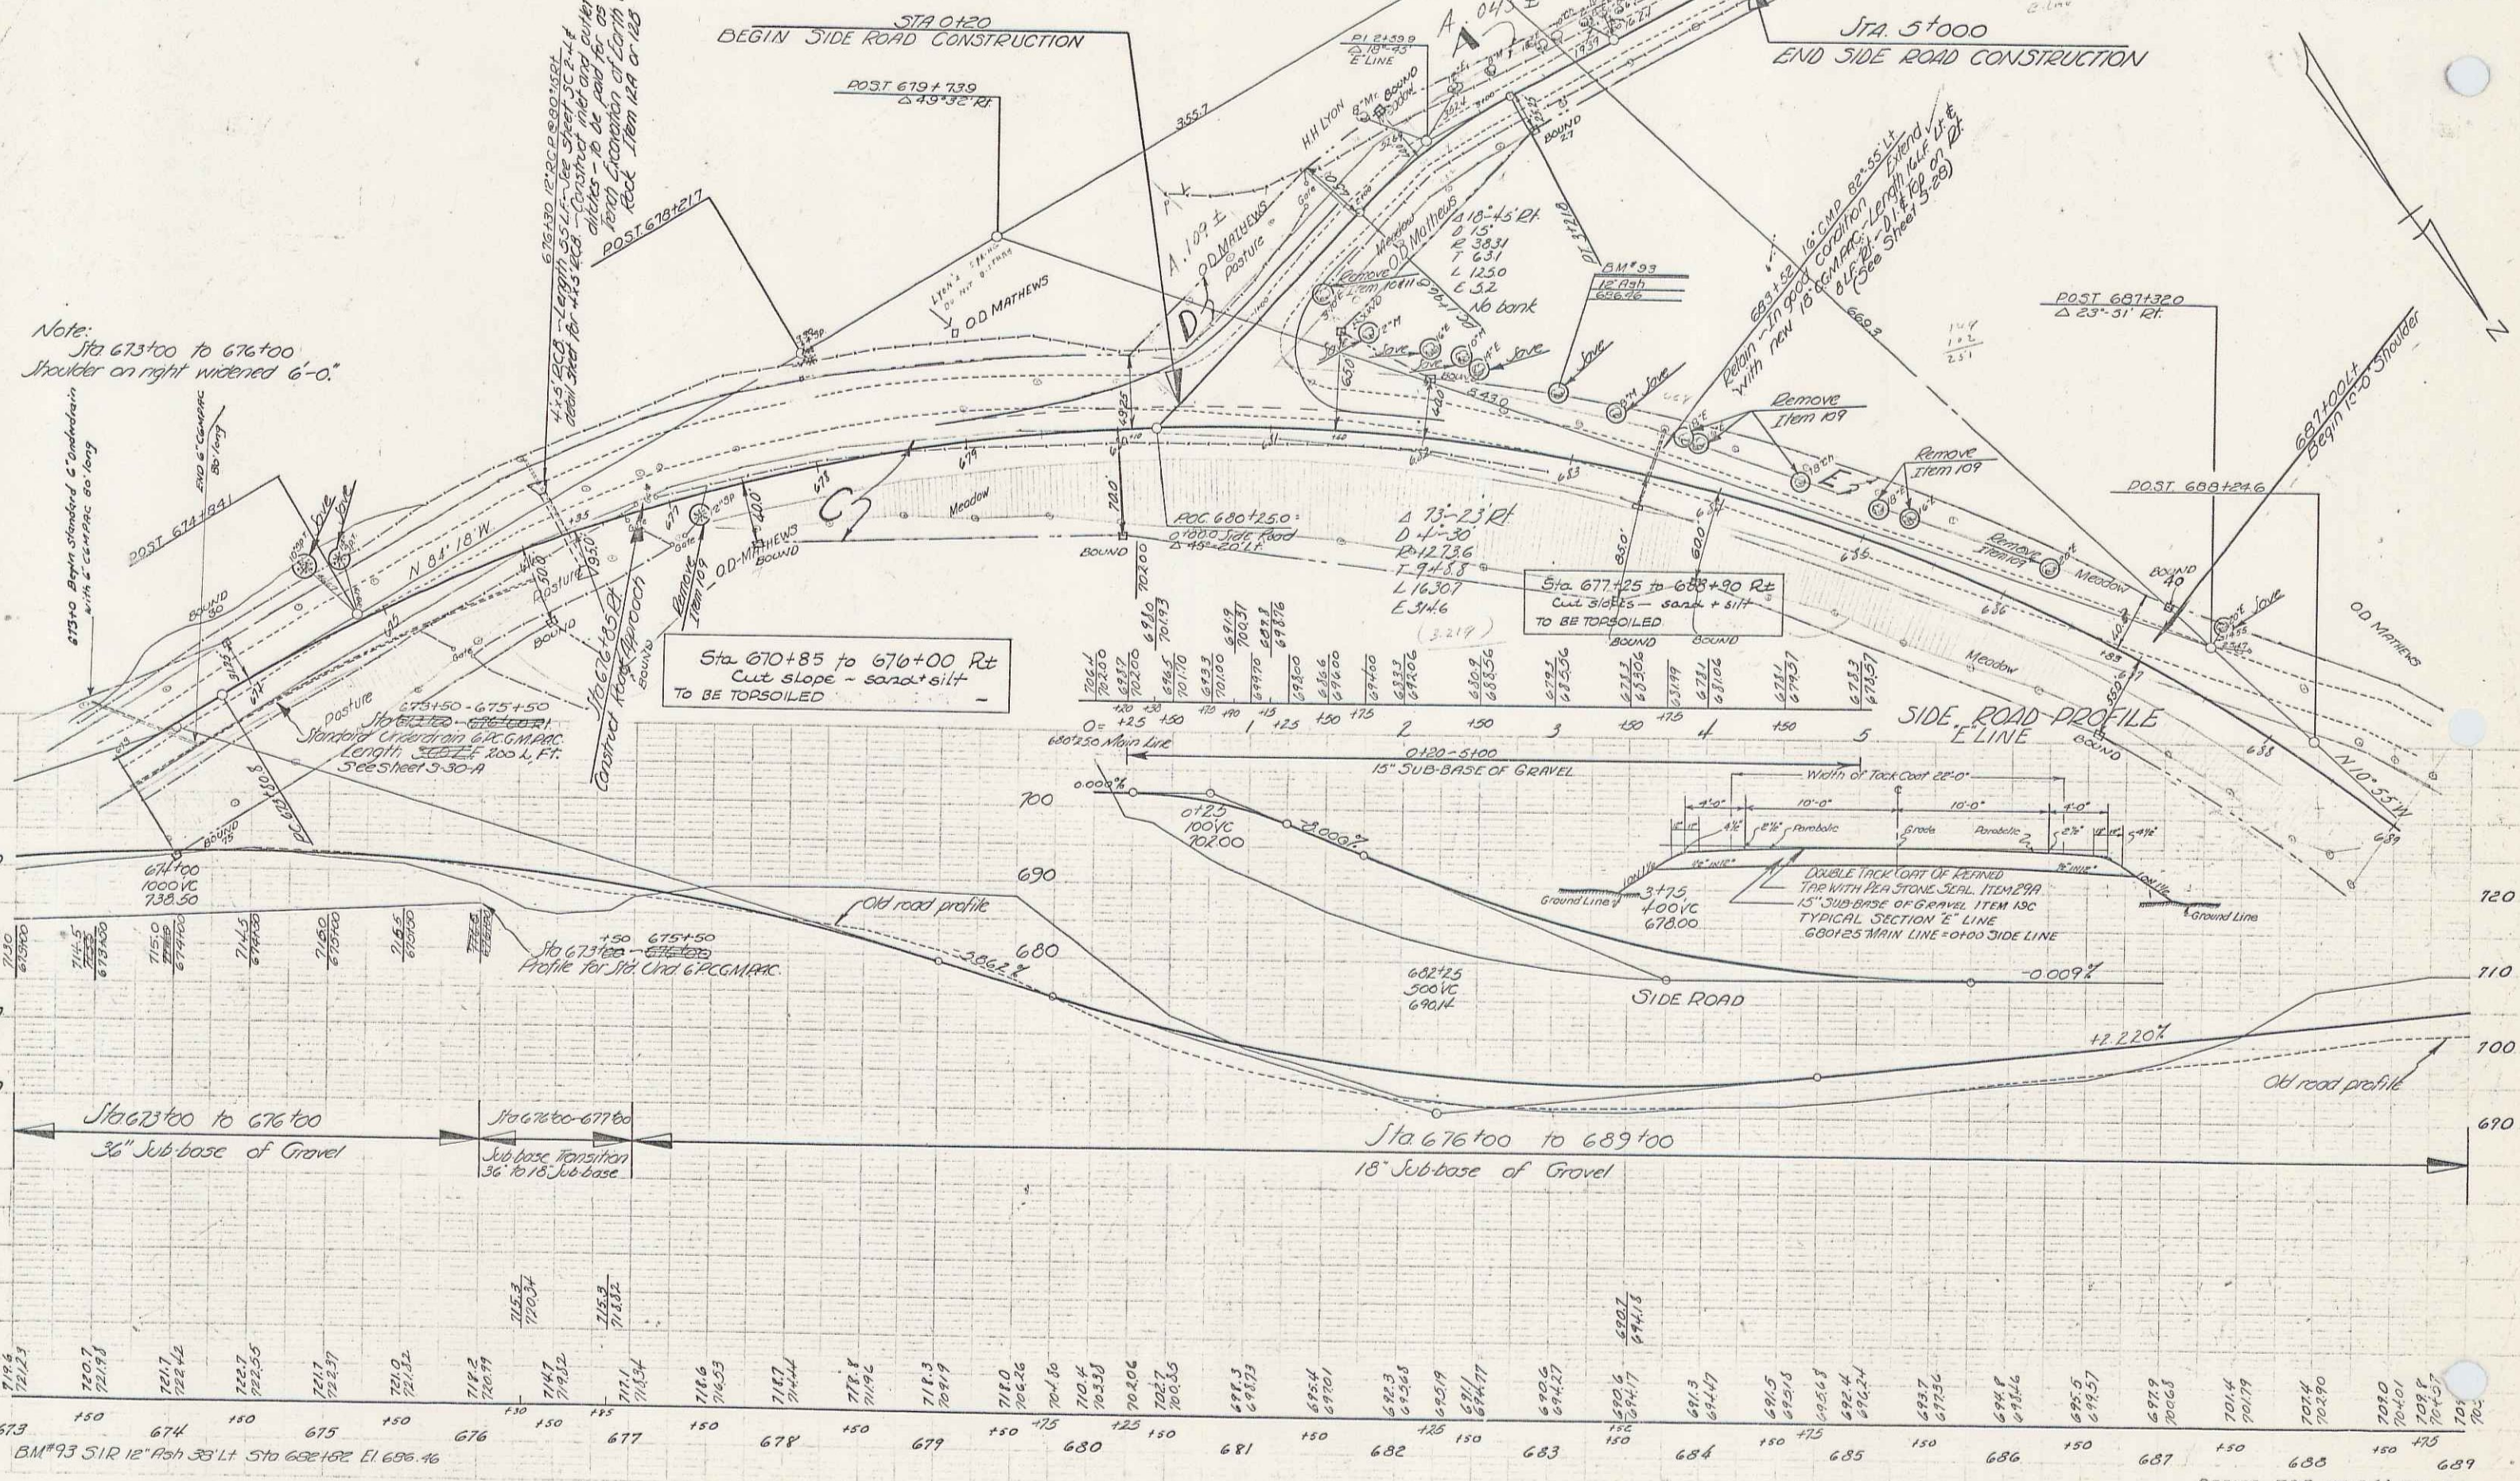

Note:
Sta 673+00 to 676+00
Shoulder on right widened 6'-0"

673+00 Right Standard C Compaction
with 2" Ca-Mpac 80/100

Cham 8-40

BM 93 S1R 12' Fish 35' Lt Sta 682+182 El 696.46

SERIES FAR 117-A(1) FILED
SHEET 17 OF 112