

ONE COURSE CEMENT CONC SIDEWALK ITEM 560

STATION	STATION	NOTES
62+00	66+85	NO. WALK

PLANT TREES ITEM 631 LEFT

STATION	STATION
62+02	62+30
65+40	
66+34	
67+10	

TOPSOIL & SEEDING ITEMS 621 & 611

STATION	STATION
62+00	68+00

TRANSPLANT SHRUBS ITEM 632 LEFT

STATION	STATION
65+76	65+86

GRANITE CURB ITEM 556-B LEFT

STATION	STATION
62+00	67+94

PARCEL: 3A,B,C,D,E,F,G,H
 GRANTOR: ST. MICHAEL'S COLLEGE, INC.
 STATIONS: 62+08-62+09 ±
 TAKING: 11/11/62
 REMAINDER RIGHTS:
 CULVERT - STA 62+98.75+86 RT, 72+00 LT ±
 SLOPE - STA 50+08-53+05 LT (900 SQ FT)
 55+38-59+10 LT (1100 SQ FT), 56+96-58+06 LT (0.3A),
 66+00-67+00 RT (550 SQ FT), 71+10-79+57 RT (0.1A) ±
 67+00-68 RT (2000 SQ FT), 71+10-79+57 RT (0.1A) ±
 TITLE TAKEN: 4/29/62 60ND
 RECORDED: COLCHESTER BK 12 P 120-132 5/0/62

WIDENING FOR MEDIAN

STATION	MEDIAN	RT. LANE	CURB
64+35.7		24' RT	
+50		24' RT	
65+00		24.4' RT	
+50		25.1' RT	
+63		25.4' RT	
+93		26.1' RT	
66+00		26.3' RT	
+28		27.2' RT	
+50		28.0' RT	
+86		29.4' RT	
+98	4.0	30.0' RT	
67+00	4.1	30.1' RT	
+50	7.8	32.6' RT	
68+00	11.4	35.6' RT	
+38	14.1	38.2' RT	
+50	15.0	39.0' RT	
+543	15.3	39.3' RT	
+749	16.0	40.0' RT	

ONE COURSE CEMENT CONC SIDEWALK ITEM 560 RIGHT


STATION	STATION
62+00	68+00

GRANITE SLOPE EDGING ITEM 556-A

STATION	STATION
66+98	68+00

CONSTRUCT MEDIAN

STATION	RIGHT	STATION
66+98		68+00

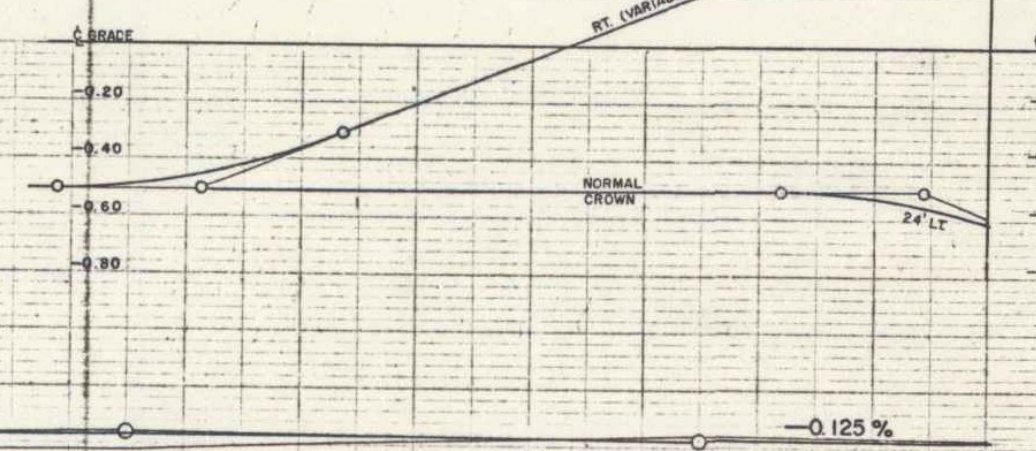

WESTER-MARTIN INC. 6-57
 WESTER-MARTIN INC. 10-1

WESTER-MARTIN INC. 6-57
 WESTER-MARTIN INC. 10-1

BM 11-A S.I.T. 42' Oak 42' H Sta. 66+95 El. 318.50

4