


PROFILE
WESTERN-MARTIN INC.
WESTERN-MARTIN INC.
5-27
7-27

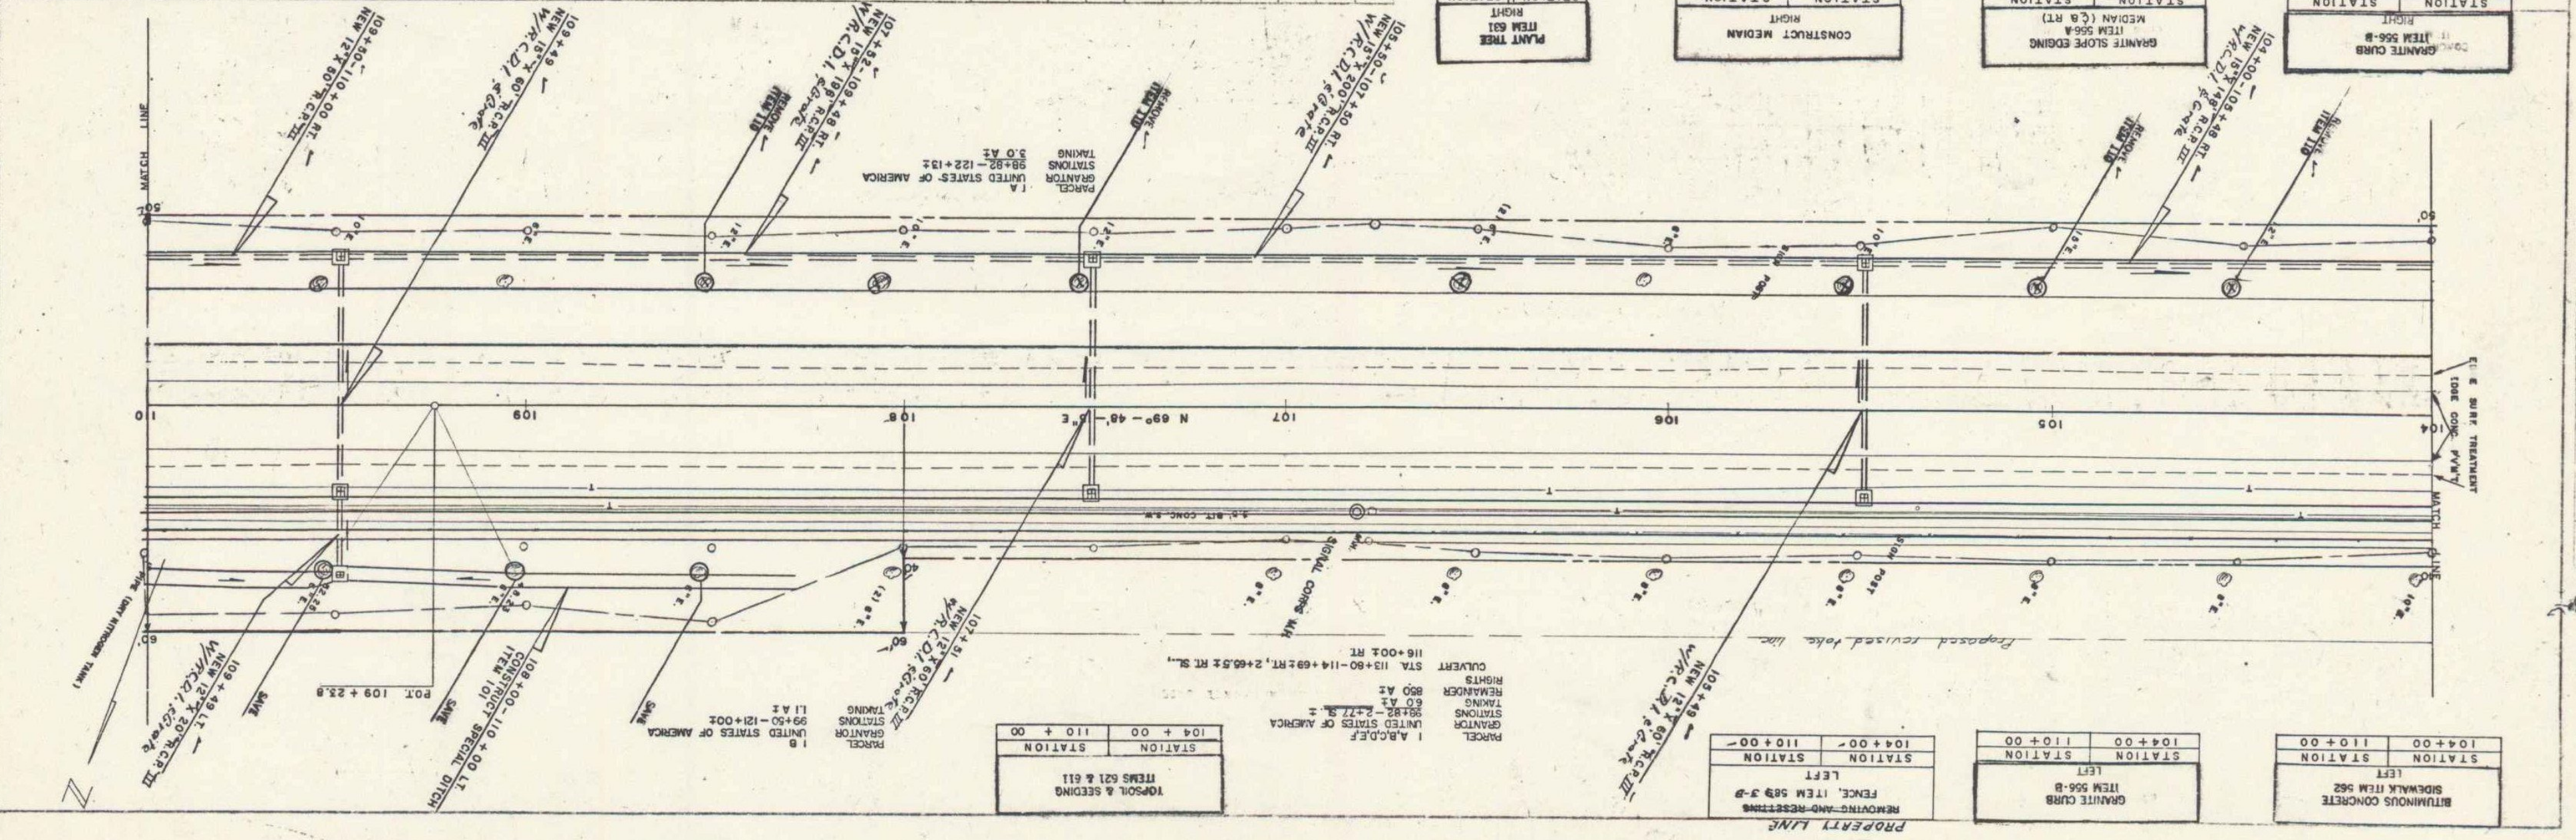

PLAN
WESTERN-MARTIN INC.
WESTERN-MARTIN INC.
5-27
7-27