

TOPSOIL & SEEDING ITEMS 621 & 611	
STATION	STATION
116 + 00	122 + 00

CONSTRUCT APPROACH LEFT	
STATION	STATION
116 + 95	

GRANITE CURB ITEM 556-B		
STATION	STATION	POS
116 + 00	116 + 46	LT
116 + 00	116 + 75	RT
117 + 15	122 + 00	RT
117 + 37	122 + 00	LT



GRANITE SLOPE EDGING ITEM 556-A		
STATION	STATION	POS
116 + 00	116 + 46	RT
117 + 15	122 + 00	RT
117 + 37	122 + 00	LT
ETHAN ALLEN AFB ISLANDS		
116 + 00	116 + 75	LT
117 + 15	116 + 97	LT
117 + 37	118 + 00	LT

CONSTRUCT ISLANDS LEFT	
STATION	STATION
116 + 00	116 + 75
116 + 93	116 + 97
117 + 17	117 + 98

CONSTRUCT 12' DECELERATION LANE (INCL. TAPER) LEFT			
STATION	STATION	TAPER	STATION
116 + 00	117 + 00	100'	
118 + 56	121 + 06	175'	

PLANT TREE ITEM 631 LEFT	
STATION	STATION
119 + 69	

REMOVING PROPERTY FENCE ITEM 587-3-B LEFT	
STATION	STATION
118 + 00	122 + 00

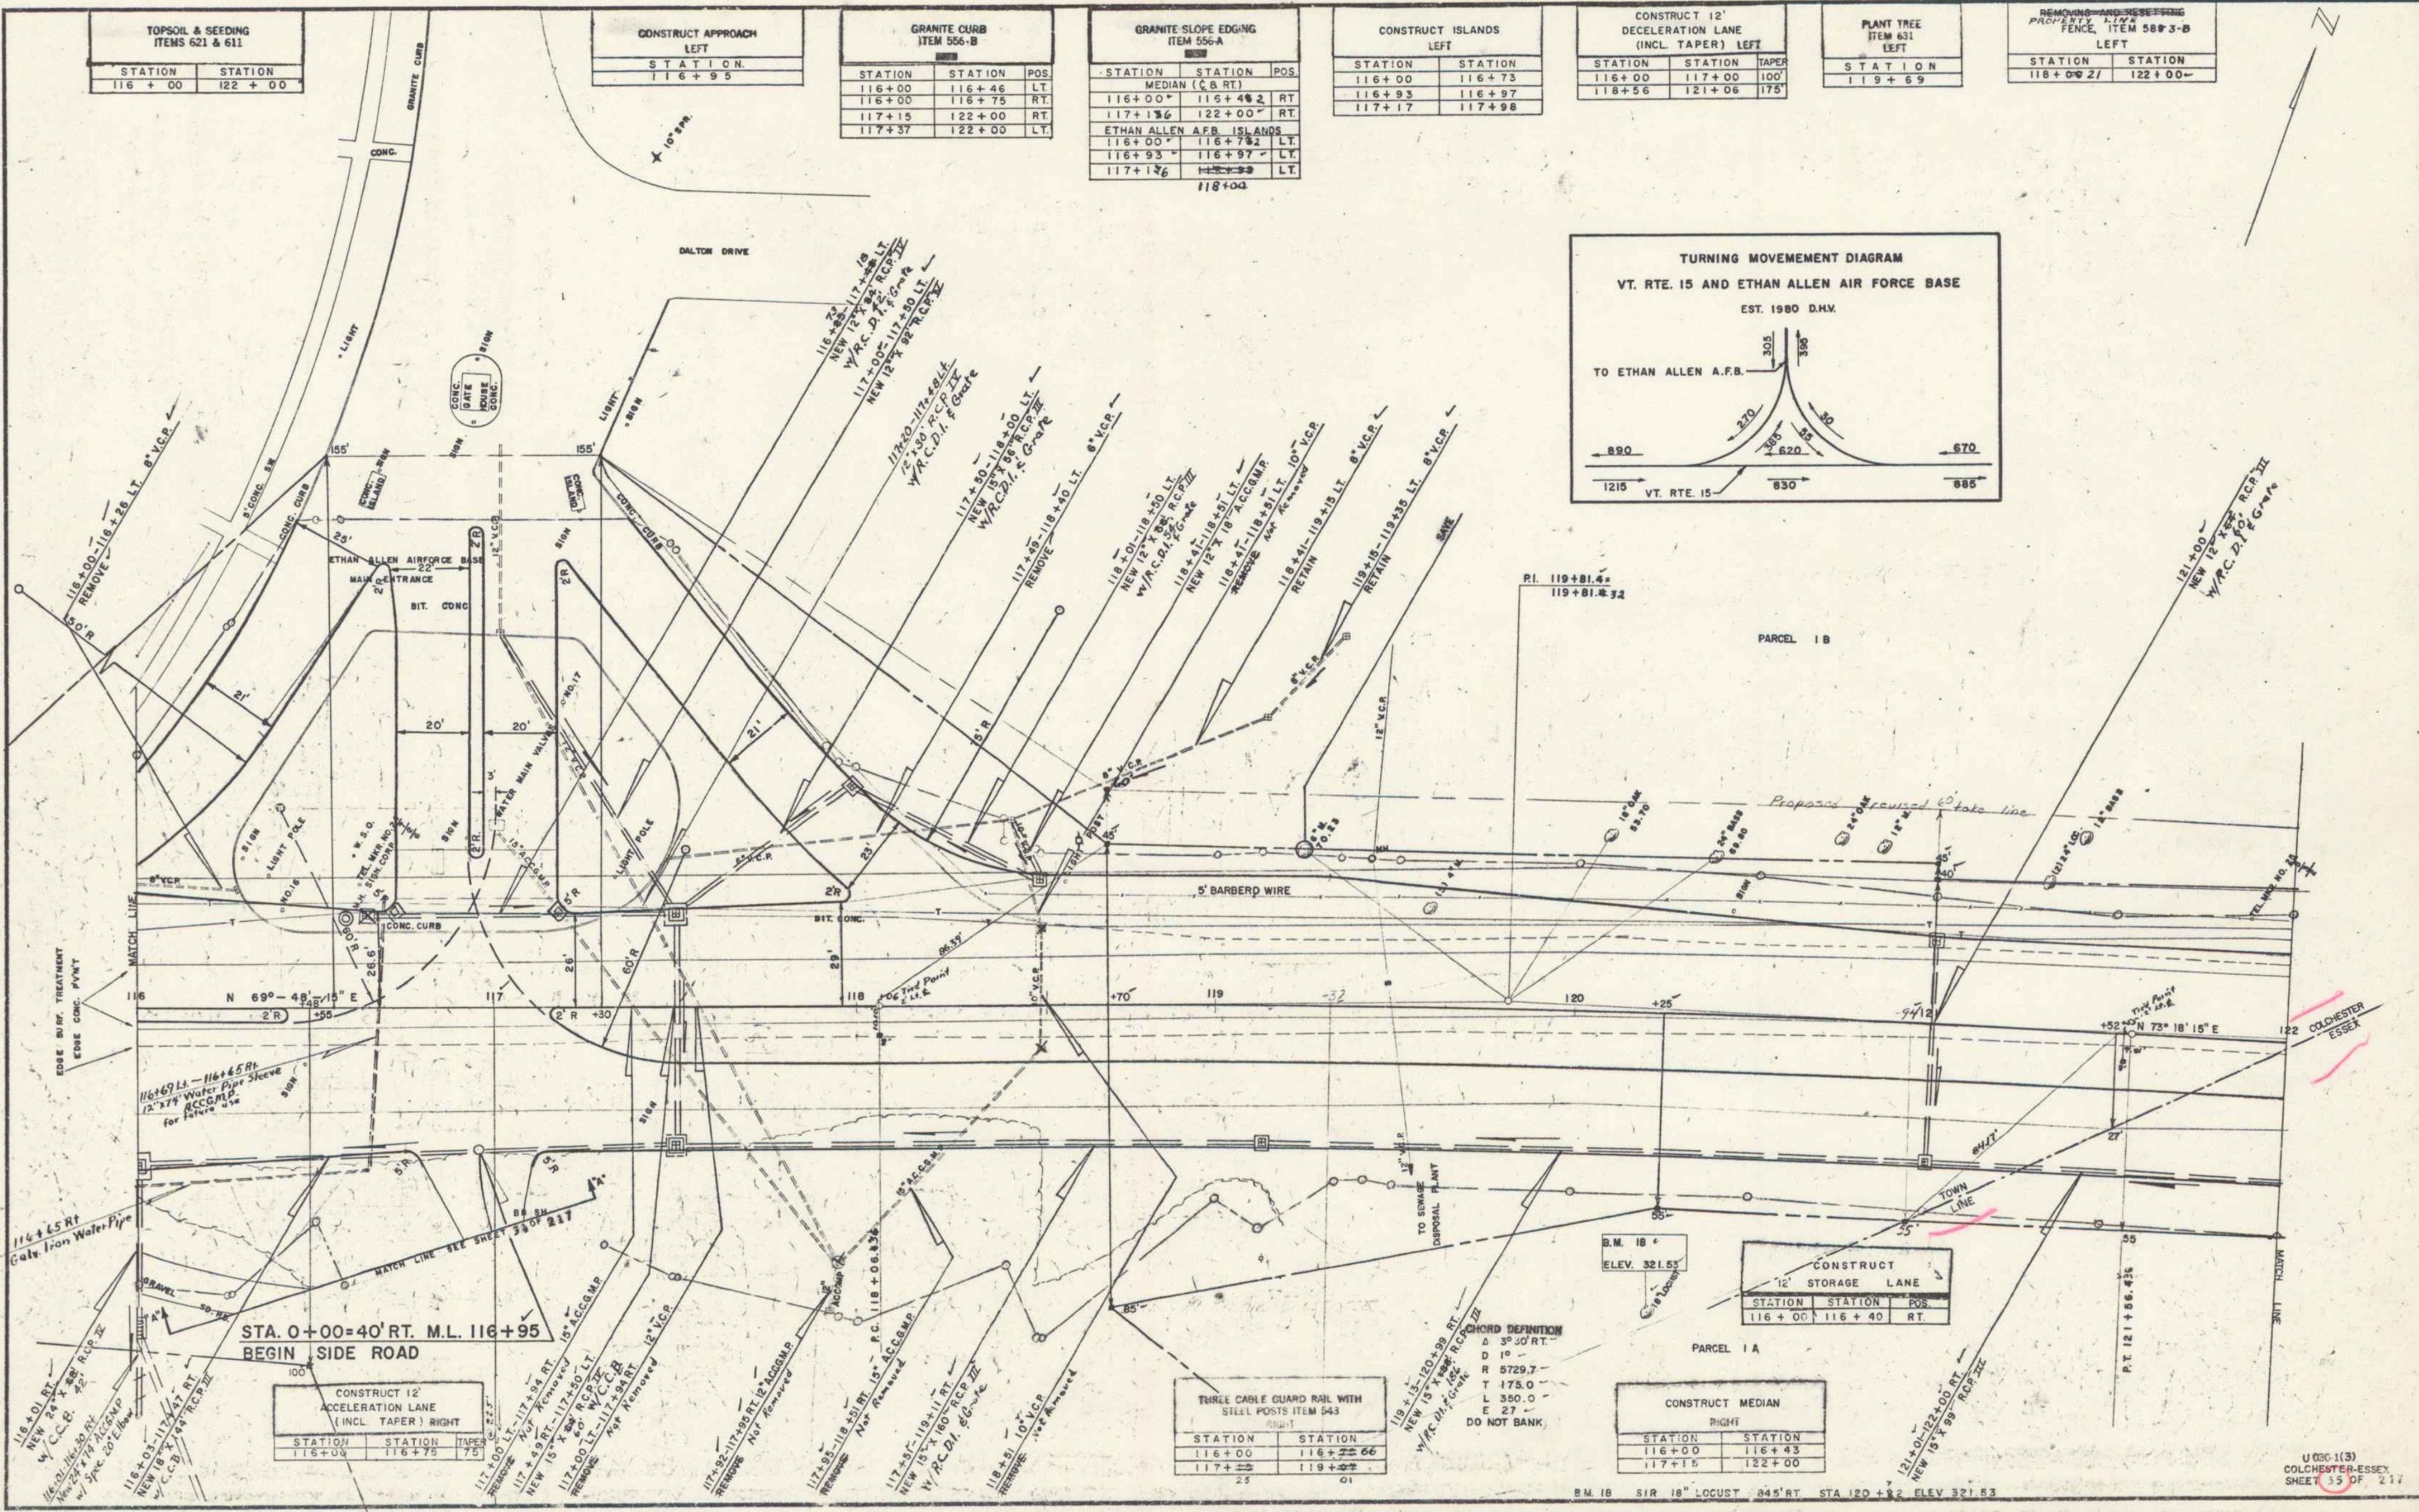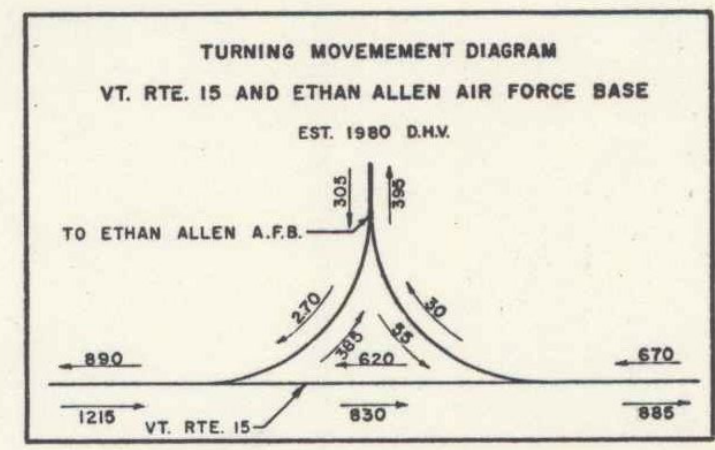

STA. 0+00=40' RT. M.L. 116+95  
BEGIN SIDE ROAD

CONSTRUCT 12' ACCELERATION LANE (INCL. TAPER) RIGHT		
STATION	STATION	TAPER
116 + 00	116 + 75	75'

THREE CABLE GUARD RAIL WITH STEEL POSTS ITEM 543 RIGHT		
STATION	STATION	POS
116 + 00	116 + 22	66
117 + 25	119 + 20	25

CONSTRUCT MEDIAN RIGHT		
STATION	STATION	POS
116 + 00	116 + 43	
117 + 15	122 + 00	

B.M. 18 SIR 18' LOCUST 845' RT. STA 120+02 ELEV 321.53