


PLAN
 WESTER-MARTIN INC. 4-87
 WESTER-MARTIN INC. 7-87
 NOTE BOOK (AS SHOWN) CHECKED
 BY: [Signature]

WESTER-MARTIN INC. 4-87
 WESTER-MARTIN INC. 7-87
 NOTE BOOK (AS SHOWN) CHECKED
 BY: [Signature]

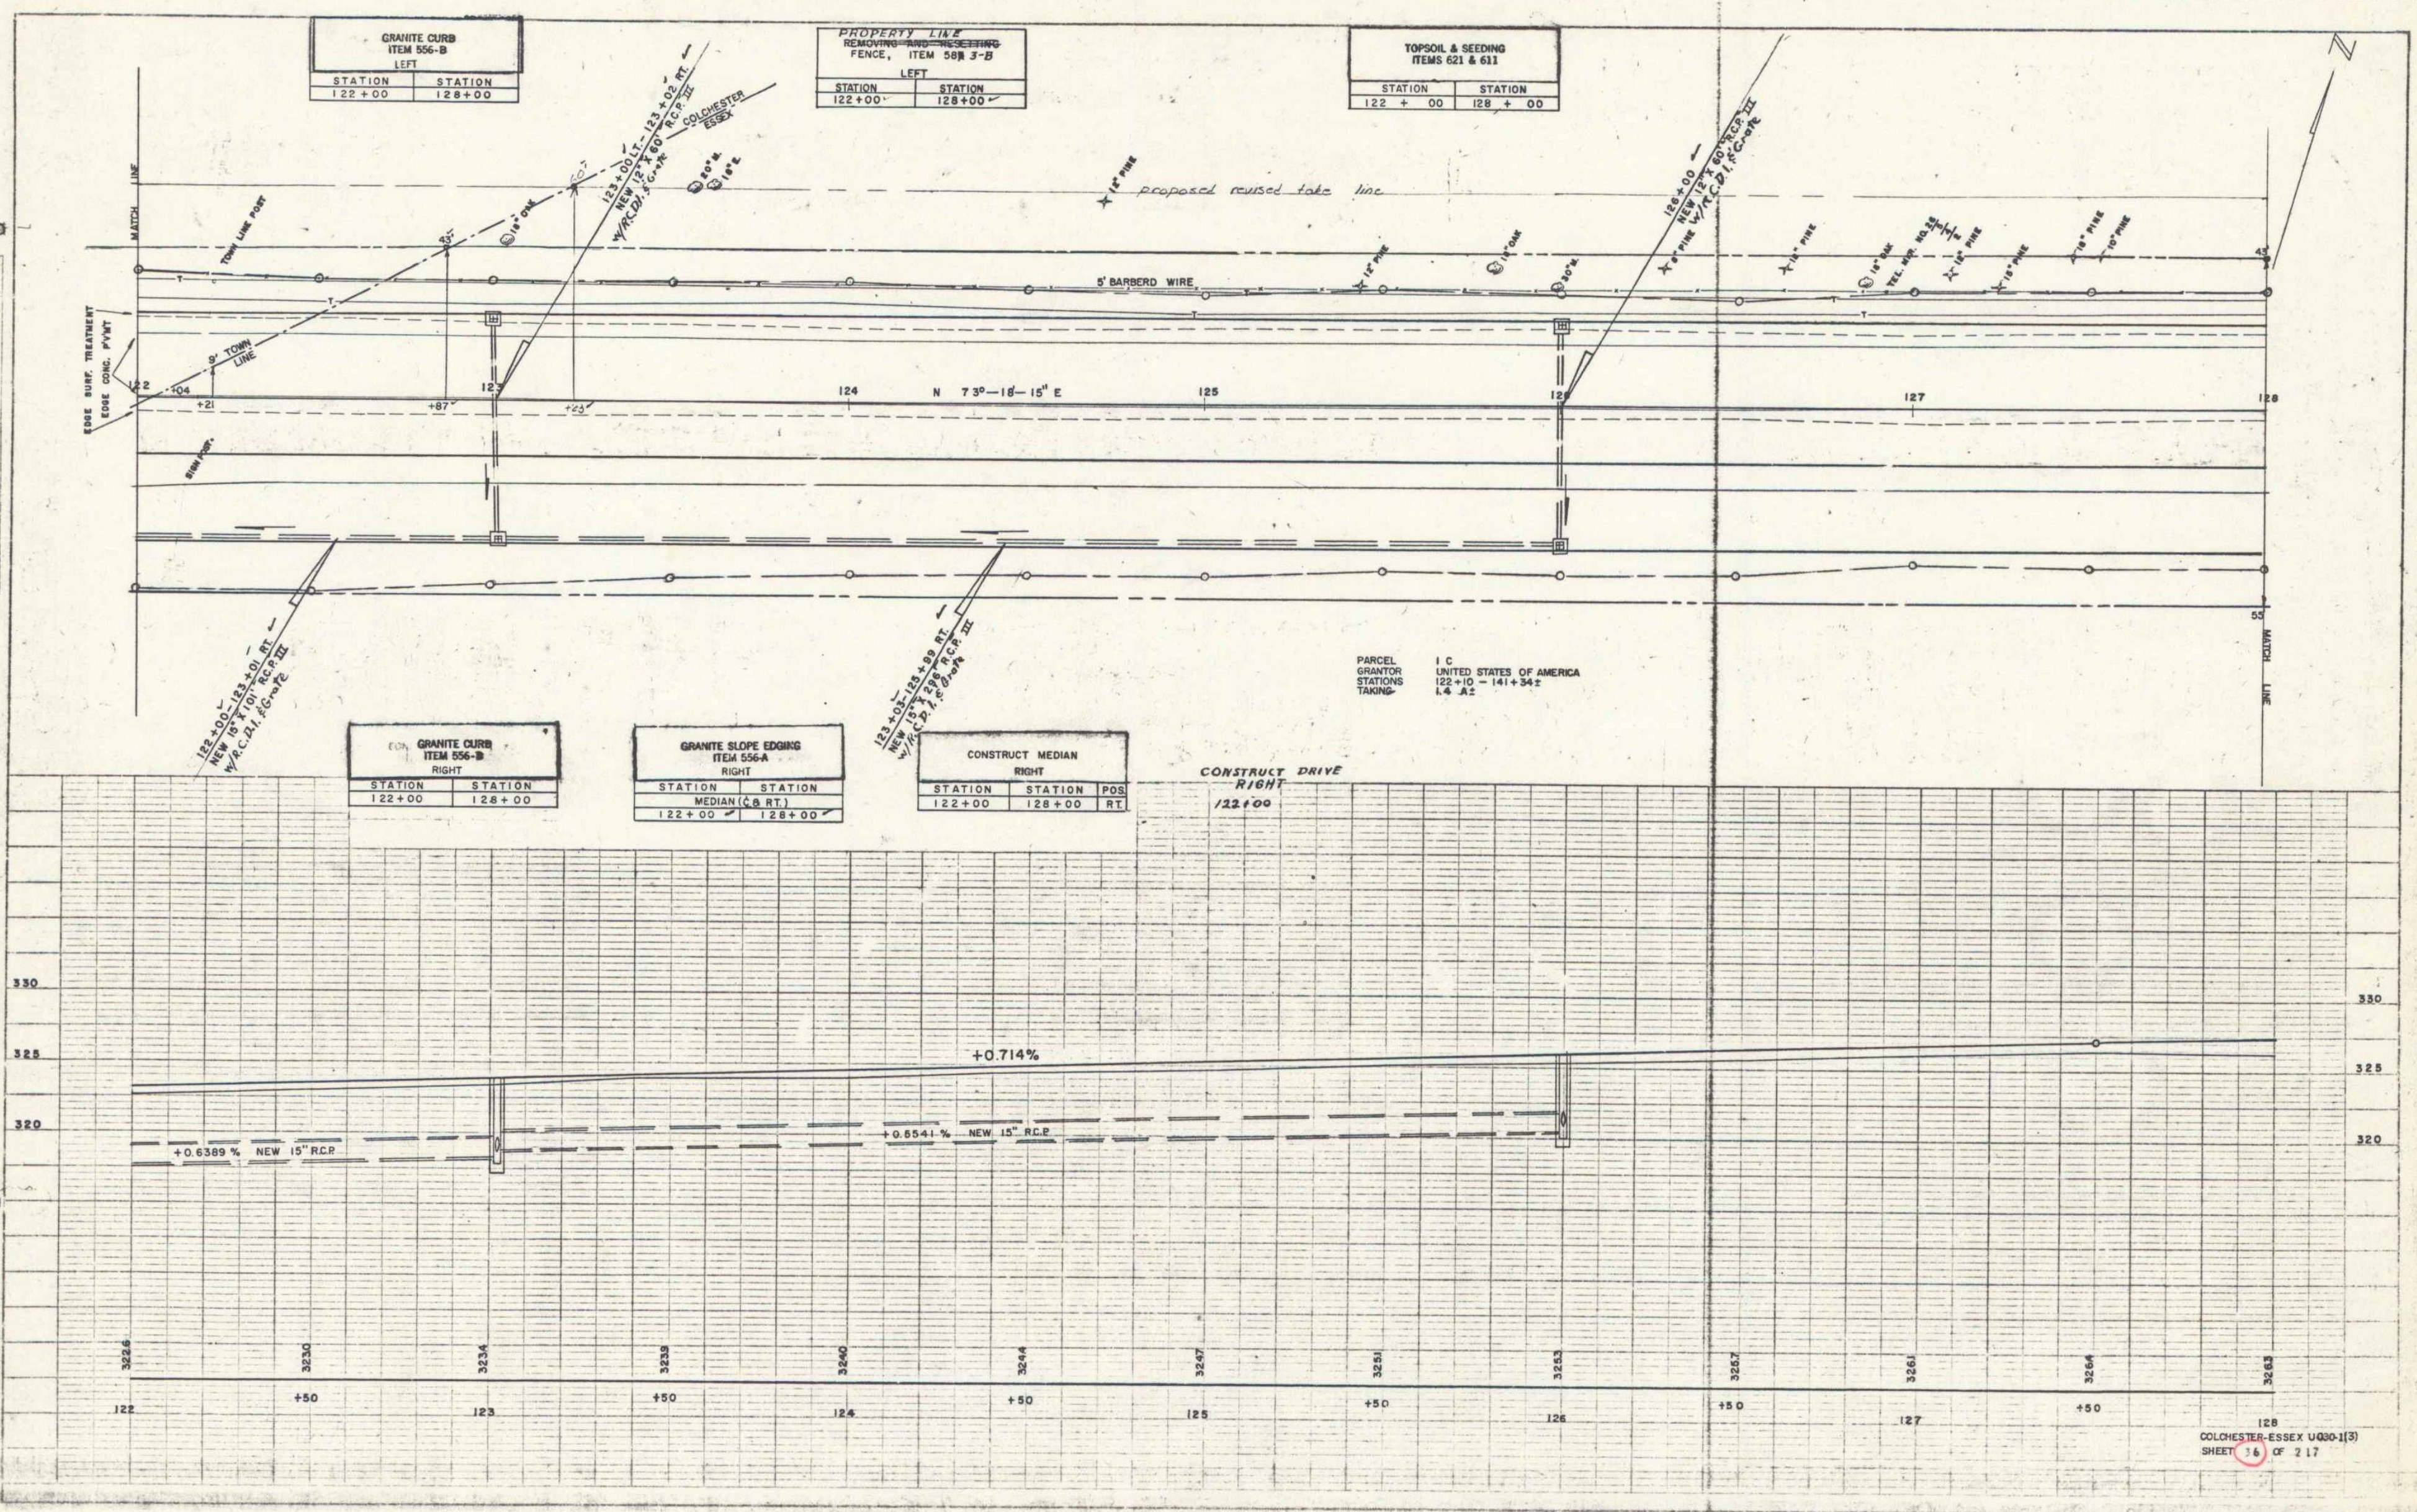

GRANITE CURB ITEM 556-B LEFT	
STATION	STATION
122+00	128+00

PROPERTY LINE REMOVING AND RESETTING FENCE, ITEM 588 3-B LEFT	
STATION	STATION
122+00	128+00

TOPSOIL & SEEDING ITEMS 621 & 611	
STATION	STATION
122+00	128+00

GRANITE CURB ITEM 556-B RIGHT	
STATION	STATION
122+00	128+00

GRANITE SLOPE EDGING ITEM 556-A RIGHT	
STATION	STATION
122+00	128+00

CONSTRUCT MEDIAN RIGHT		
STATION	STATION	POS
122+00	128+00	RT.

CONSTRUCT DRIVE
RIGHT
122+00

PARCEL
GRANTOR I C
STATIONS UNITED STATES OF AMERICA
TAKING 122+10 - 141+34±
1.4 AC