


GRANITE CURB ITEM 556-B		
STATION	STATION	POS
134+00	140+00	LT
134+00	140+00	RT

TOPSOIL & SEEDING ITEMS 621 & 611	
STATION	STATION
134+00	140+00

REMOVING AND RESETTING PROPERTY LINE FENCE, ITEM 583 3-B	
LEFT	
STATION	STATION
134+00	140+00

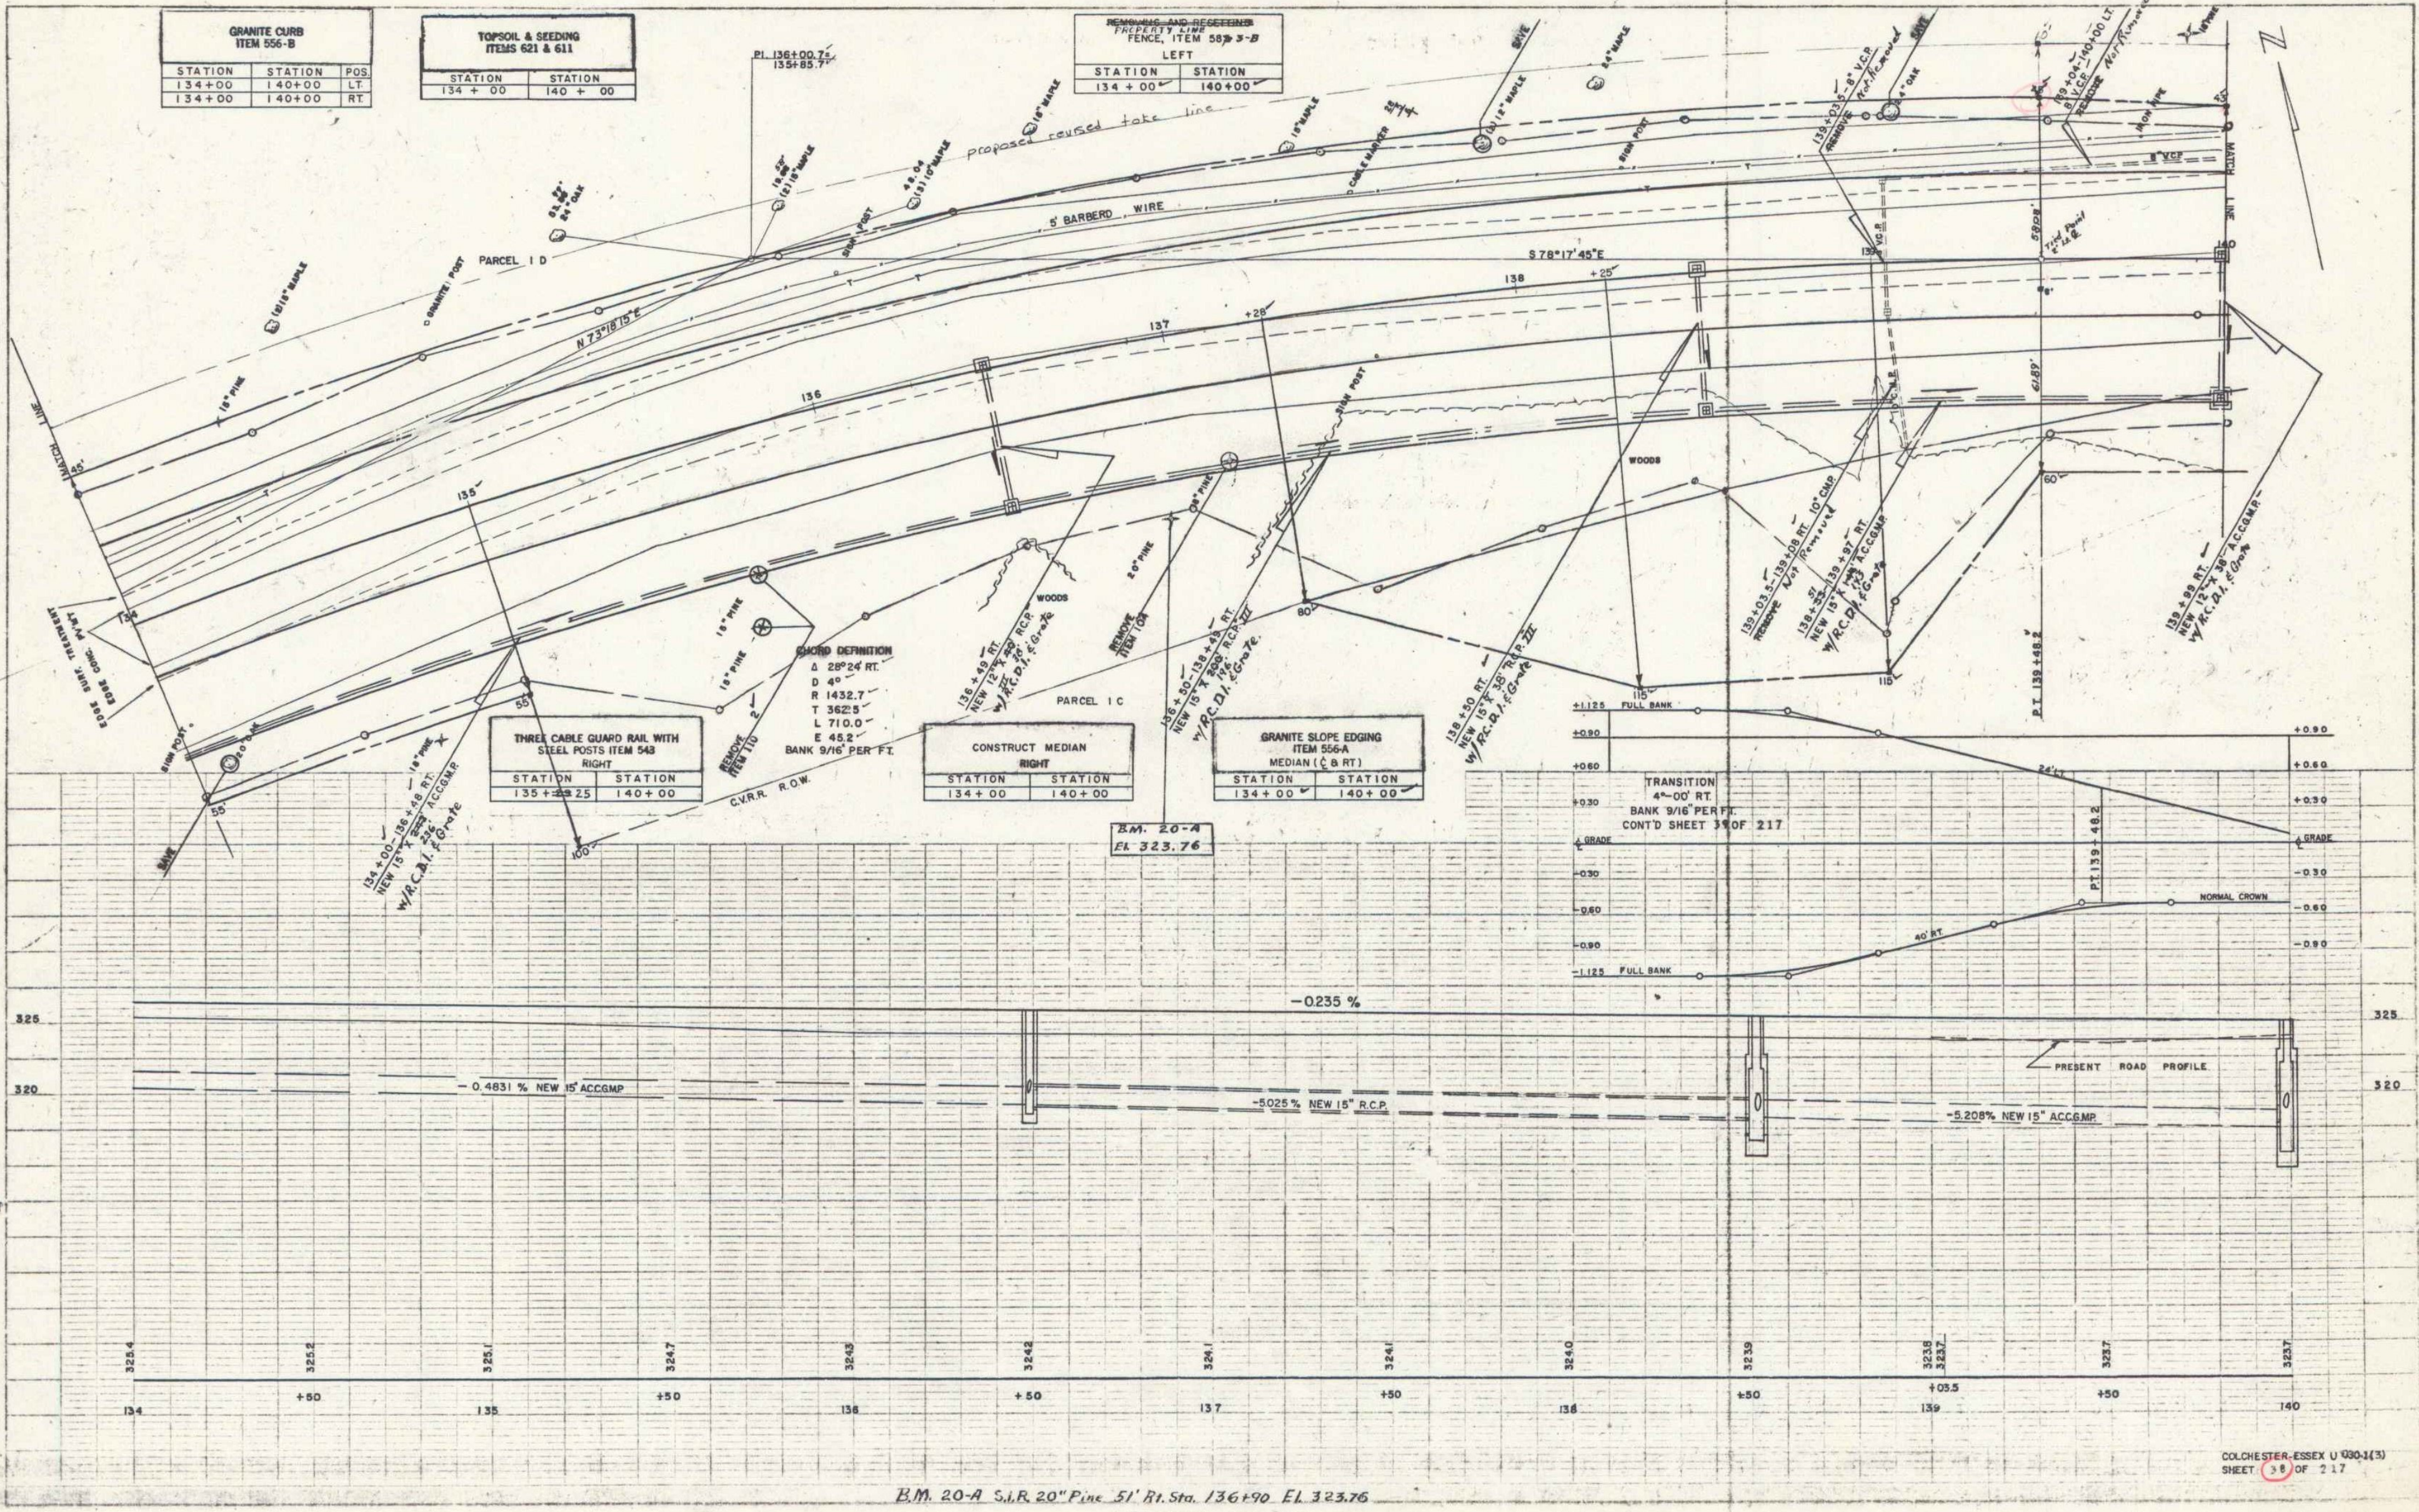

WESTER-MARTIN INC. 507
1000 WESTER-MARTIN INC. 507
1000 WESTER-MARTIN INC. 507

WESTER-MARTIN INC. 507
1000 WESTER-MARTIN INC. 507
1000 WESTER-MARTIN INC. 507

B.M. 20-A S.I.R. 20" Pine 51' Rt. Sta. 136+90 EL 323.76