

GRANITE CURB ITEM 556-B LEFT	
STATION	STATION
140+00	142+37
142+53	146+00

PROPERTY LINE REMOVING AND RESETTING FENCE, ITEM 568 3-B	
STATION	STATION
140+00	142+00
142+87	146+00

CONSTRUCT APPROACH LEFT	
STATION	STATION
142+50	142+50

TOPSOIL & SEEDING ITEMS 621 & 611	
STATION	STATION
140+00	146+00


GRANITE SLOPE EDGING ITEM 556-A MEDIAN (C&R RT)	
STATION	STATION
140+00	141+88
142+81	146+00

CONSTRUCT GRANITE CURB ITEM 556-B RIGHT	
STATION	STATION
140+00	146+00

CONSTRUCT MEDIAN RIGHT	
STATION	STATION
140+00	141+84
142+81	146+00

THREE CABLE GUARD RAIL WITH POSTS ITEM 545 RIGHT	
STATION	STATION
140+00	146+00

STONE FILL FOR SLOPE PROJECTION ITEM 522 RIGHT	
STATION	STATION
143+50	146+00

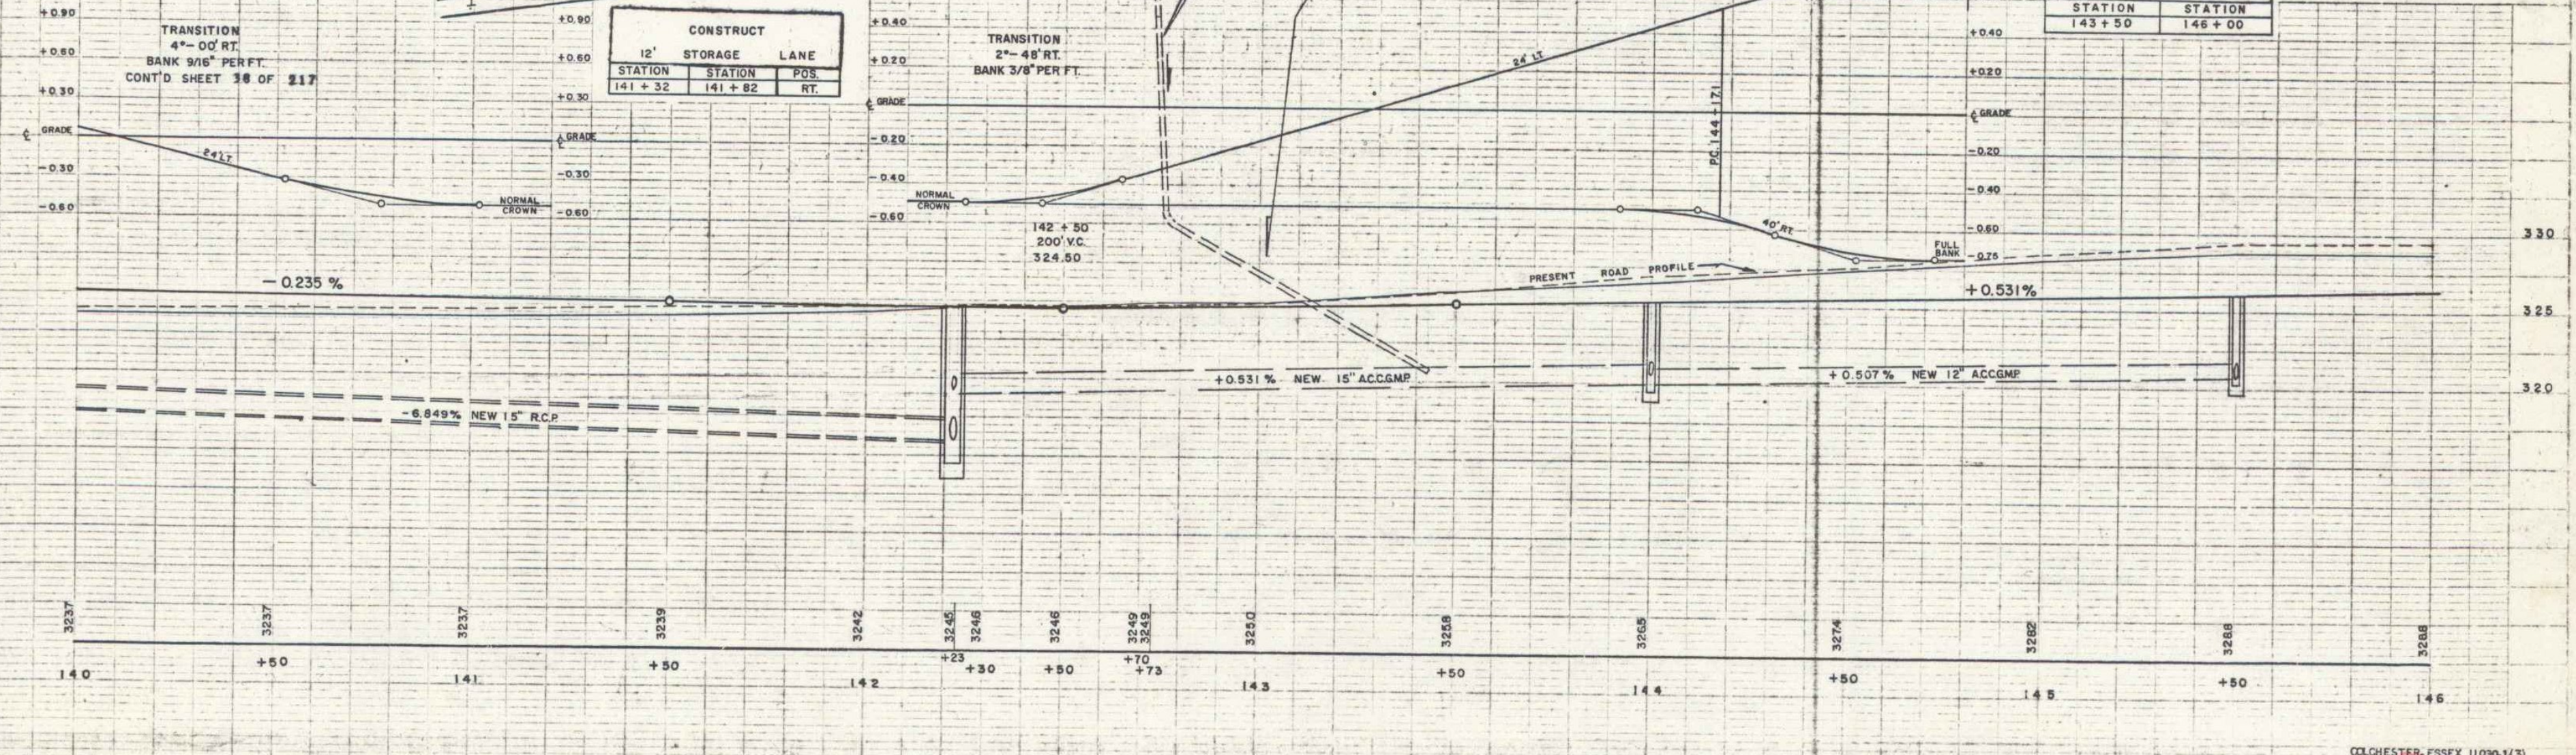

WESTER-MARTIN INC.  
 5-BY  
 7-87  
 WESTER-MARTIN INC.  
 1000 W. 10th St.  
 Des Moines, IA 50319

WESTER-MARTIN INC.  
 5-BY  
 7-87  
 WESTER-MARTIN INC.  
 1000 W. 10th St.  
 Des Moines, IA 50319

B.M. 21 S.I.R. 15" OAK 33" RT. STA. 141+54 ELEV. 322.41

B.M. 21-A Spot on West Con. West Brick Post 43' N. Sta. 1112+17 E.L. 325.46