
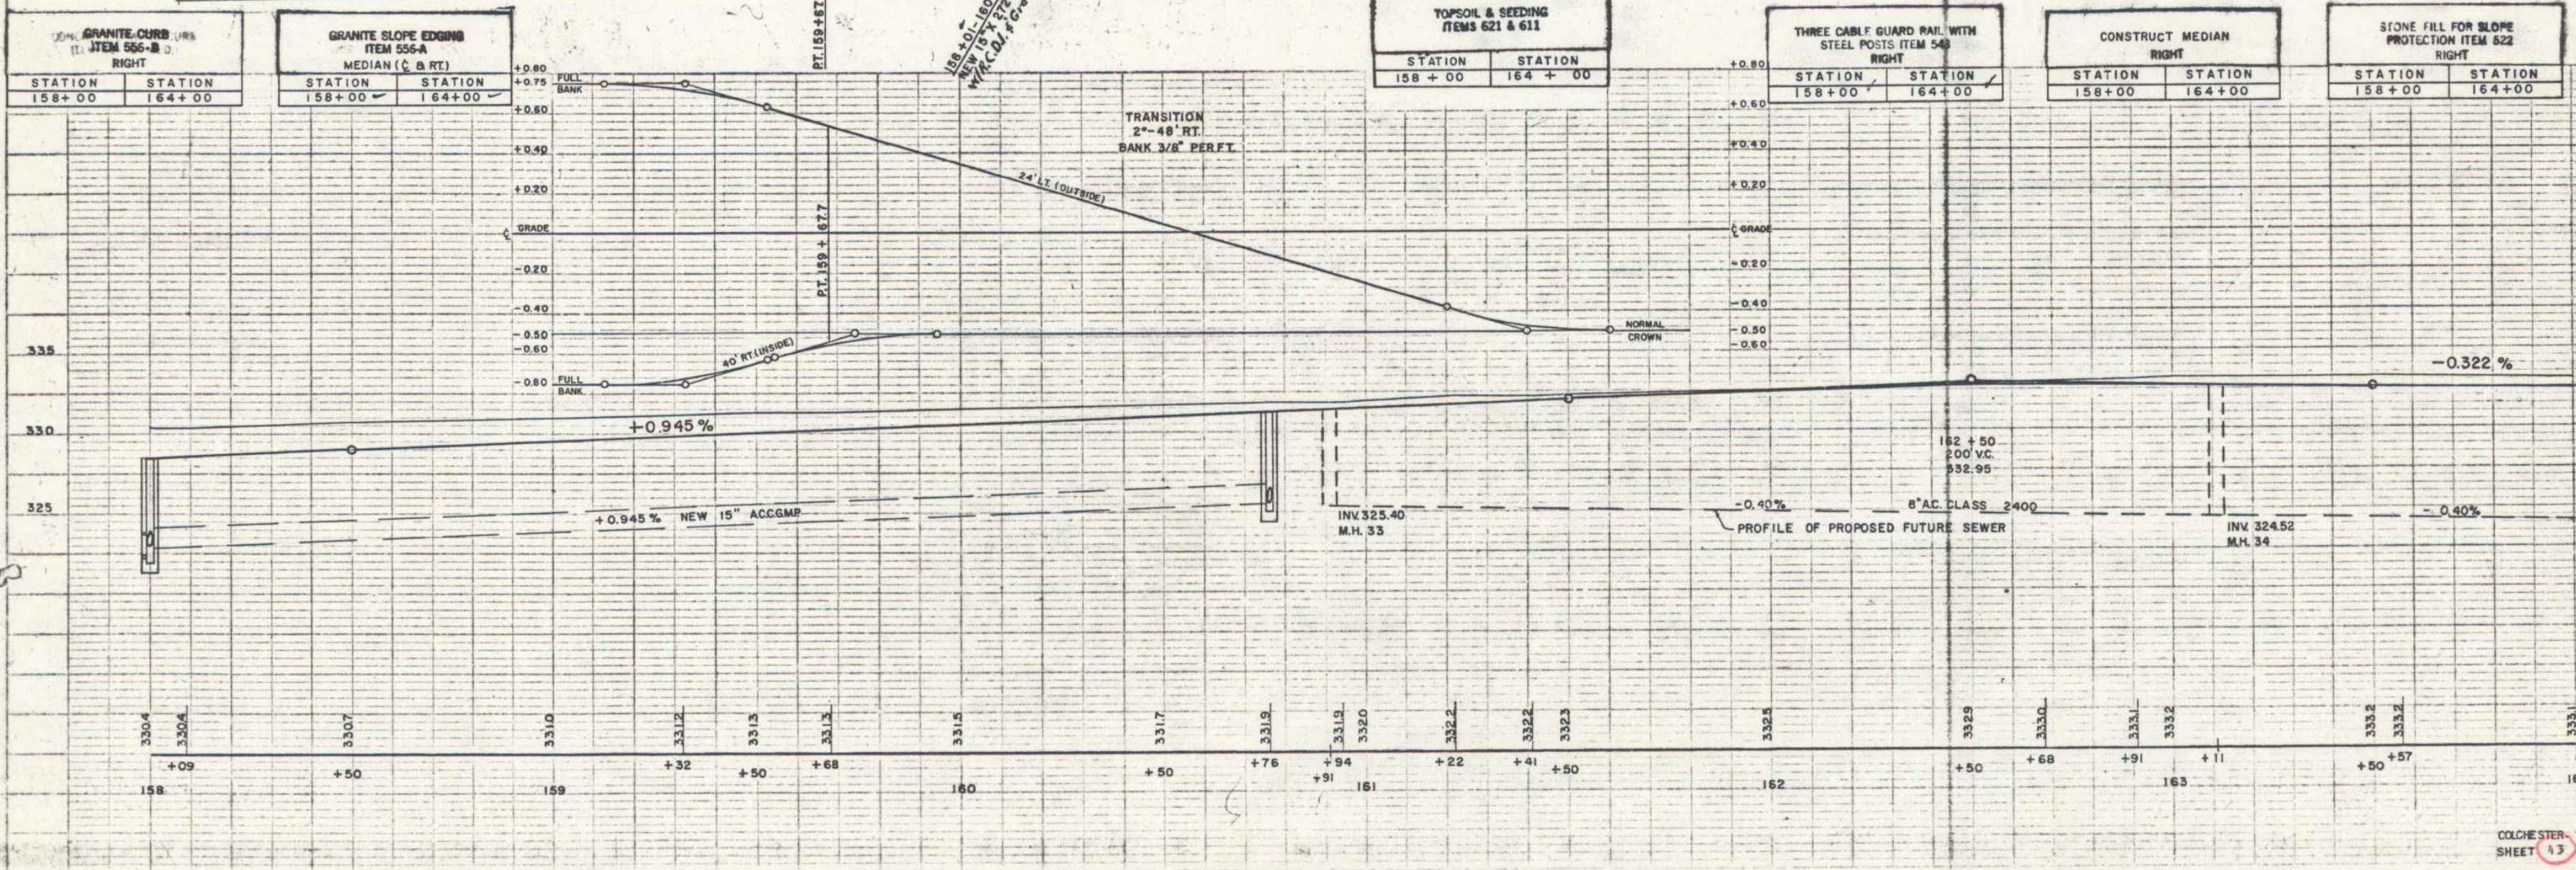


DRAWN BY: [Name]  
 CHECKED BY: [Name]  
 DATE: [Date]  
 PROJECT: [Project Name]  
 SHEET NO.: [Sheet Number]

PROJECT: [Project Name]  
 SHEET NO.: [Sheet Number]

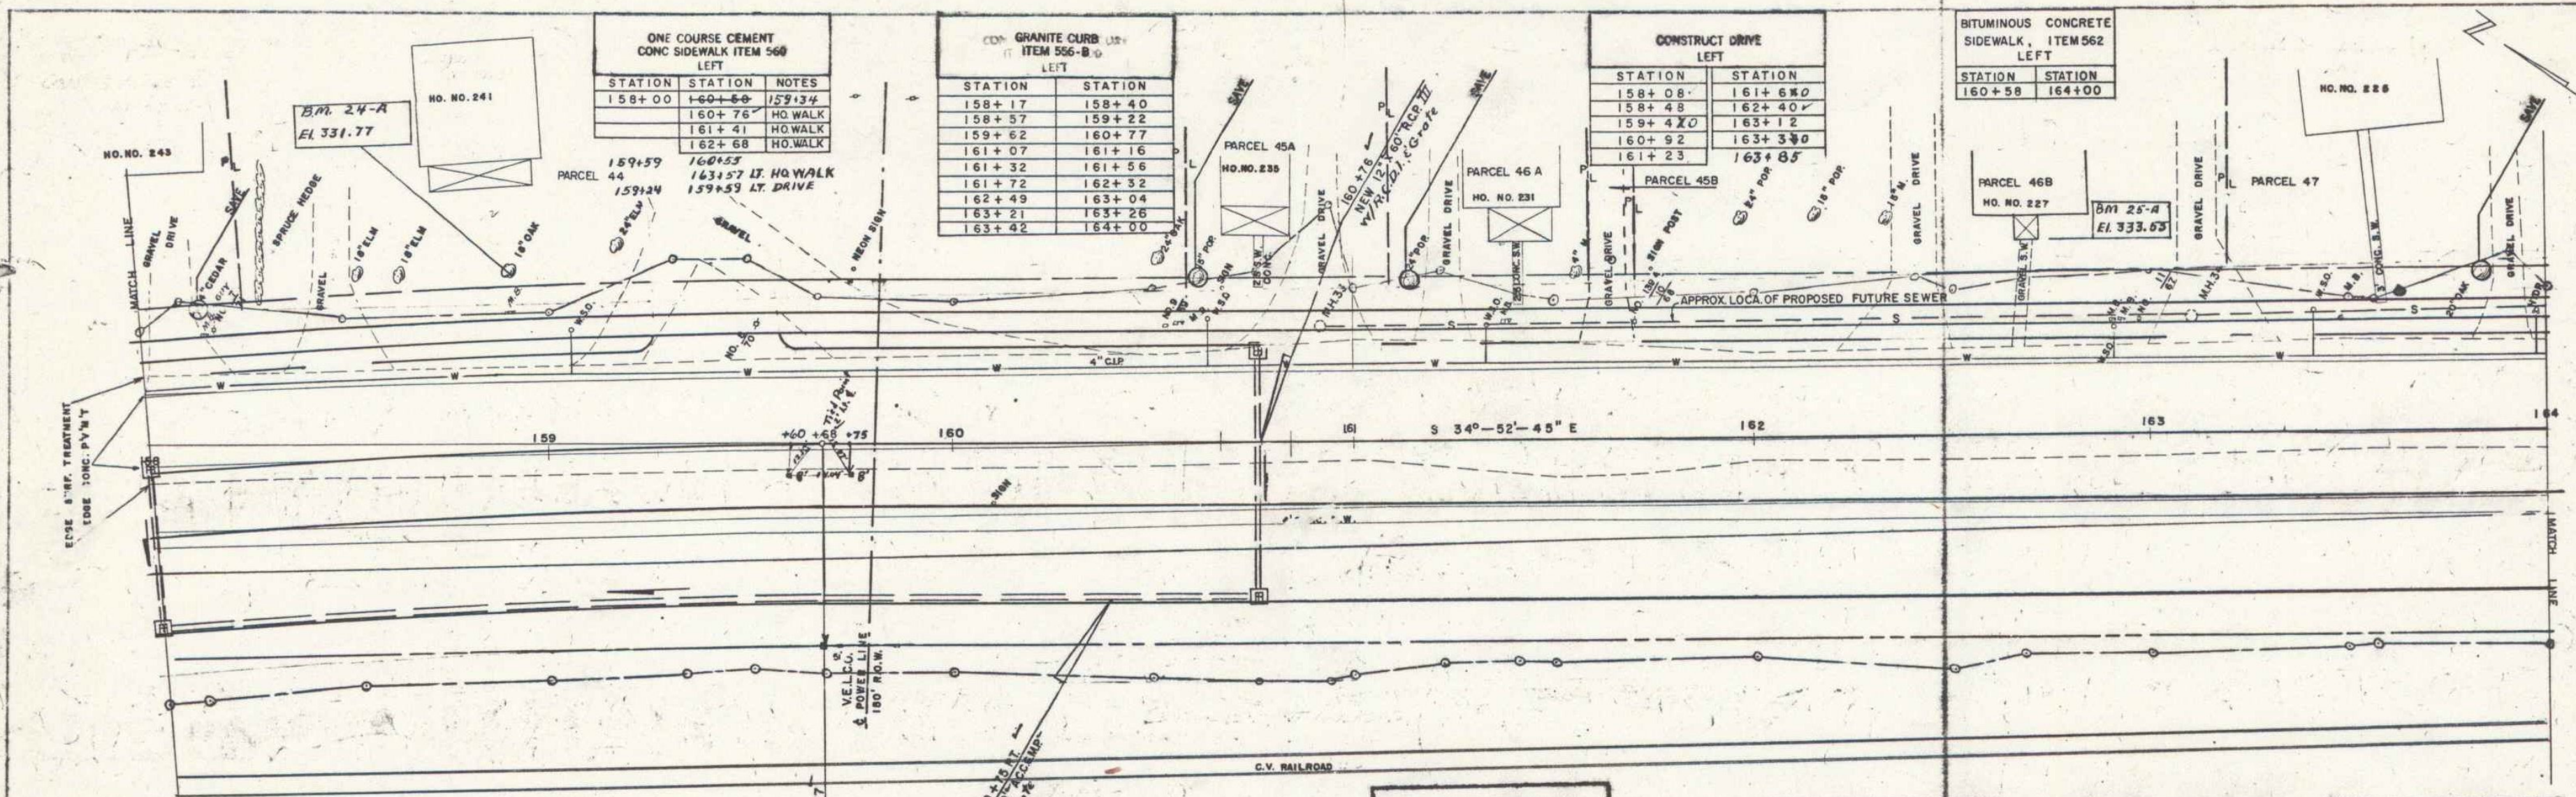

ONE COURSE CEMENT CONC SIDEWALK ITEM 560 LEFT

STATION	STATION	NOTES
158+00	160+60	15' WALK
160+76		HO. WALK
161+41		HO. WALK
162+68		HO. WALK

CONC GRANITE CURB ITEM 556-B LEFT

STATION	STATION
158+17	158+40
158+57	159+22
159+62	160+77
161+07	161+16
161+32	161+56
161+72	162+32
162+49	163+04
163+21	163+26
163+42	164+00

CONSTRUCT DRIVE LEFT

STATION	STATION
158+08	161+60
158+48	162+40
159+40	163+12
160+92	163+30
161+23	163+85

BITUMINOUS CONCRETE SIDEWALK ITEM 562 LEFT

STATION	STATION
160+58	164+00

CONC GRANITE CURB ITEM 556-B RIGHT

STATION	STATION
158+00	164+00

GRANITE SLOPE EDGING ITEM 556-A MEDIAN (L & RT)

STATION	STATION
158+00	164+00

TOPSOIL & SEEDING ITEMS 621 & 611

STATION	STATION
158+00	164+00

THREE CABLE GUARD RAIL WITH STEEL POSTS ITEM 540 RIGHT

STATION	STATION
158+00	164+00

CONSTRUCT MEDIAN RIGHT

STATION	STATION
158+00	164+00

STONE FILL FOR SLOPE PROTECTION ITEM 622 RIGHT

STATION	STATION
158+00	164+00

BM. 24-A S.I.T. 18" Oak 45' Lt. Sta. 158+90 El. 331.77

BM. 25-A Spot on S.E. Cor. Conc. Steps No. 227 55' Lt. Sta. 162+70 El. 333.85