

GRANITE CURB ITEM 556-B LEFT	
STATION	STATION
188+40	189+04
189+44	190+14
190+31	191+36
191+70	192+00
192+17	192+20
192+37	192+67
193+07	193+20
193+57	194+00

ONE COURSE CEMENT CONC SIDEWALK ITEM 560 LEFT		
STATION	STATION	NOTES
193+00	194+00	HO. WALK
191+84	191+84	
190+77	190+77	



TRANSPLANT SHRUBS ITEM 632 LEFT	
STATION	STATION
188+20	188+20
189+20	189+20
190+20	190+20
191+20	191+20
192+20	192+20
193+20	193+20
194+00	194+00

CONSTRUCT DRIVE LEFT	
STATION	STATION
188+20	188+20
189+20	189+20
190+20	190+20
191+20	191+20
192+20	192+20
193+20	193+20
194+00	194+00

PLANT TREE ITEM 631 LEFT	
STATION	STATION
190+61	191+71
190+71	193+80

BITUMINOUS CONCRETE SIDEWALK ITEM 562 LEFT	
STATION	STATION
188+00	193+20

CONSTRUCT APPROACH LEFT	
STATION	STATION
193+46	193+46

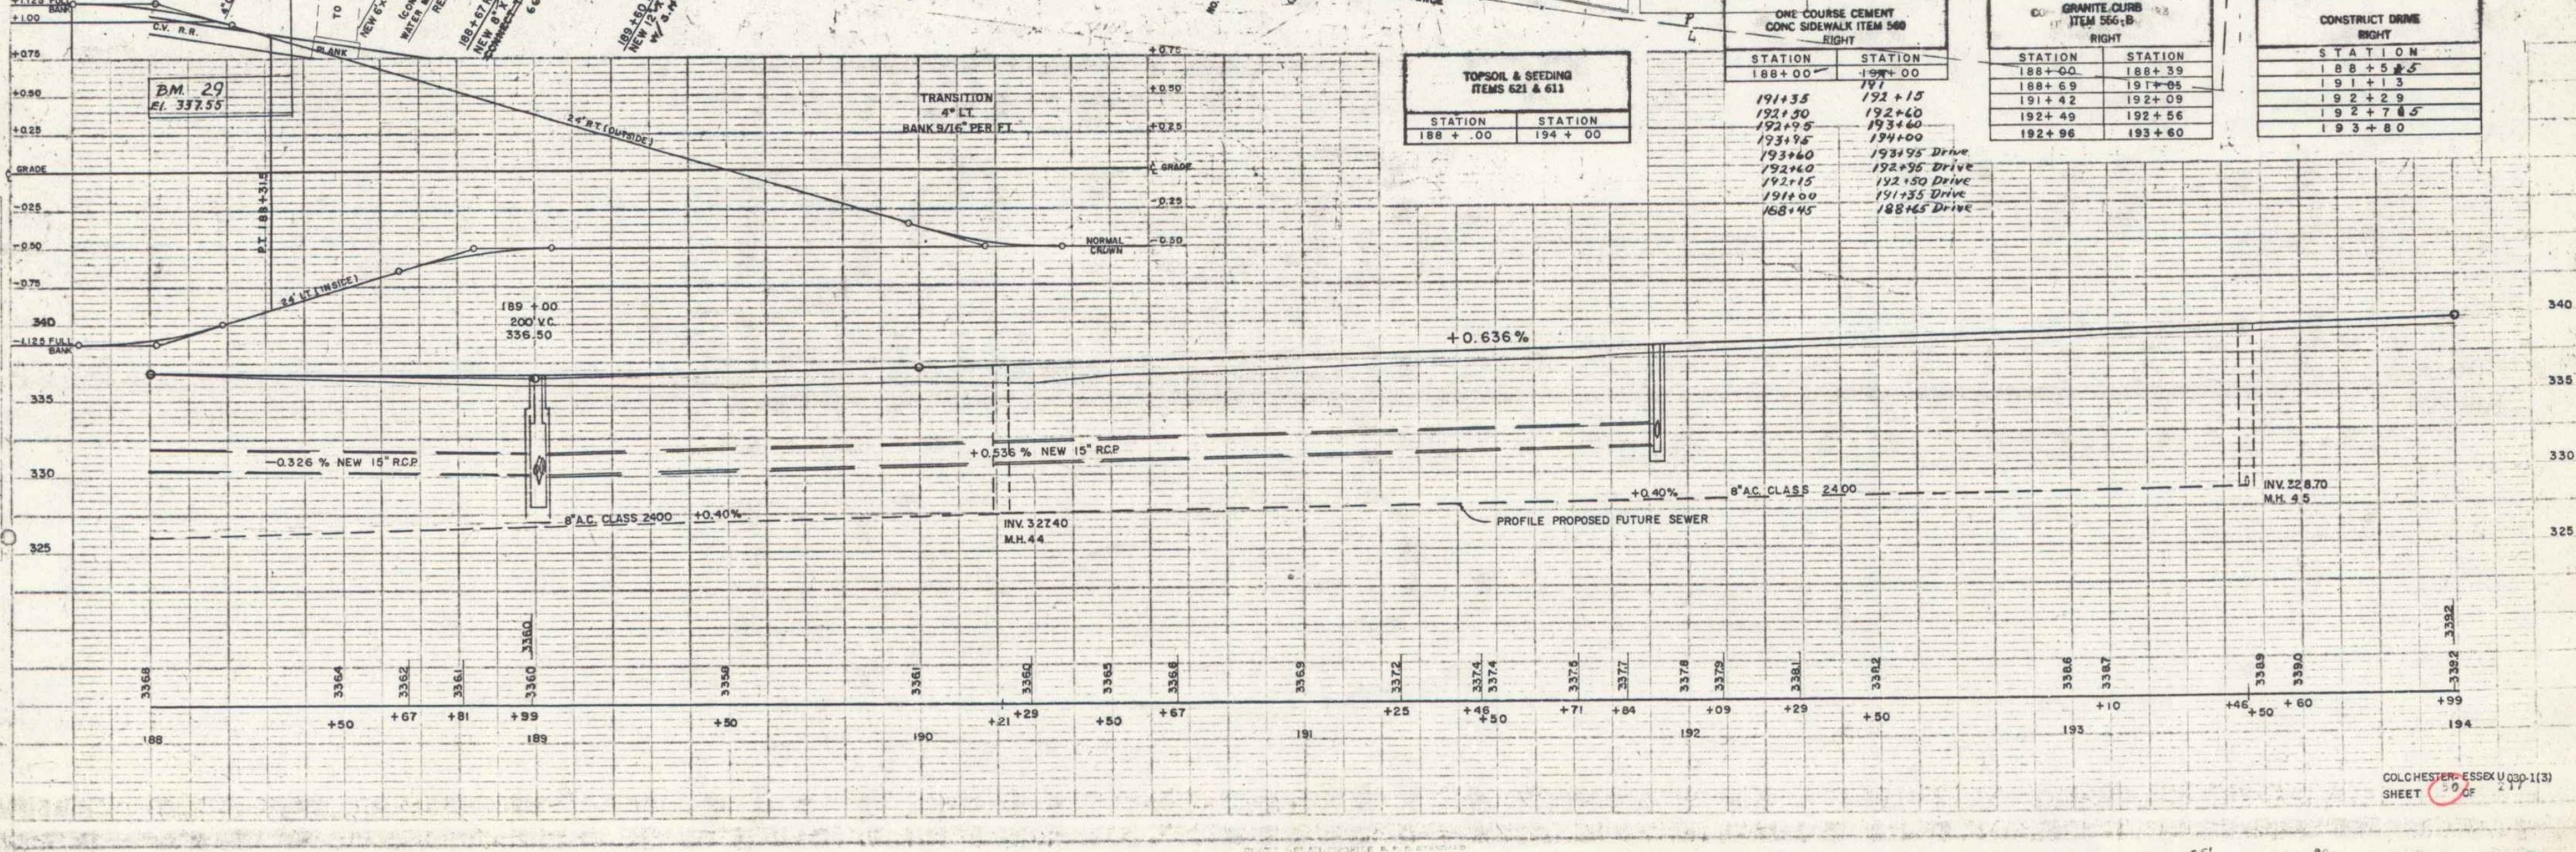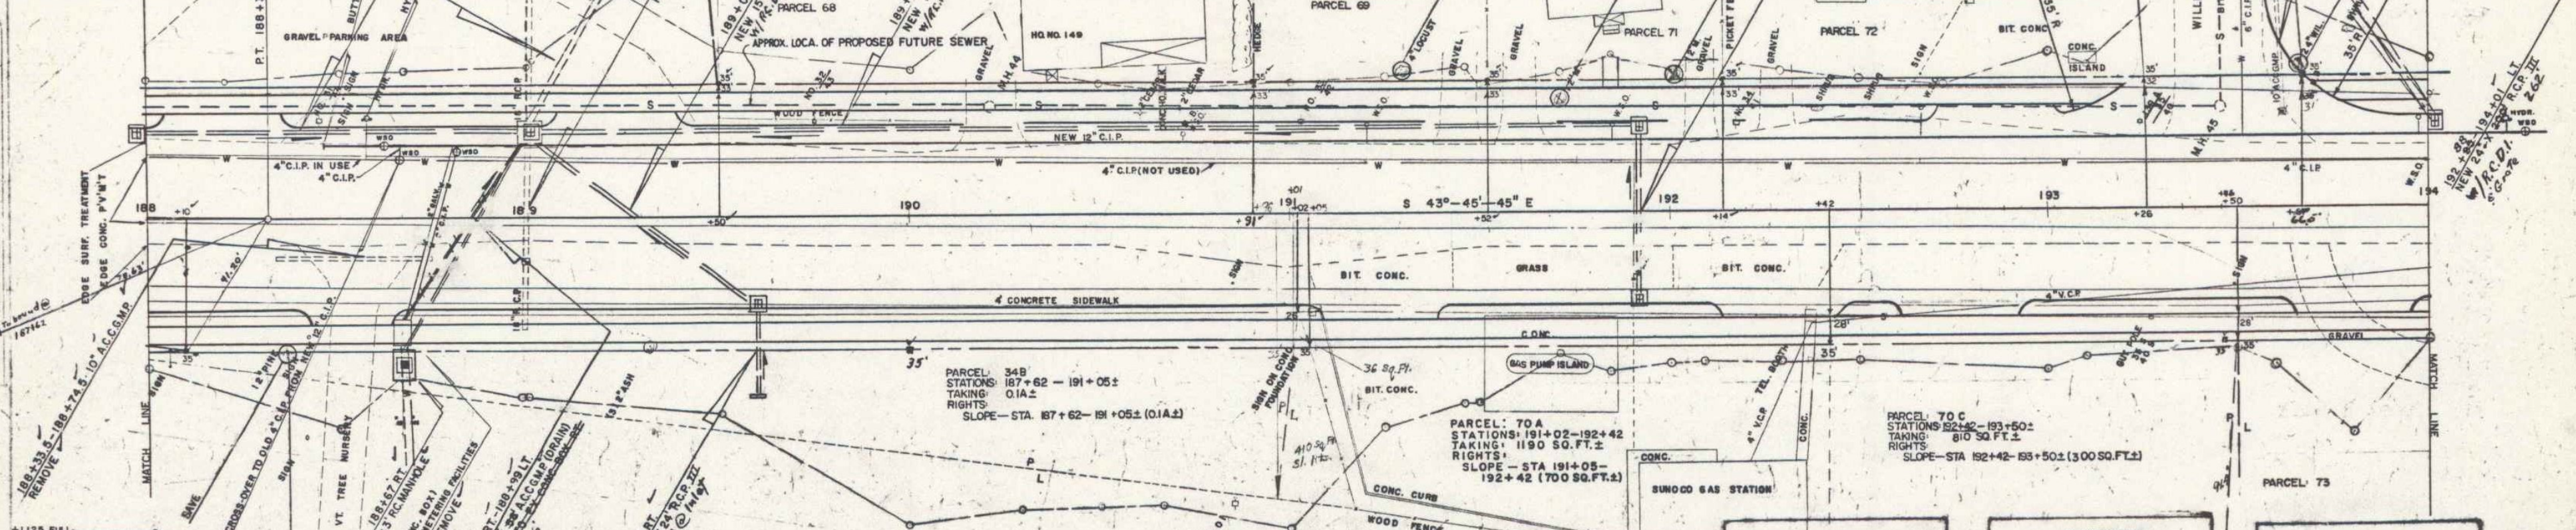

WEINSTEIN-MARTIN INC. 4-87  
 1000 W. 10th St. St. Paul, MN 55102  
 TEL: 651-222-1111

WEINSTEIN-MARTIN INC. 4-87  
 1000 W. 10th St. St. Paul, MN 55102  
 TEL: 651-222-1111

B.M. 29 S.I.T. 12" Pine 35' Rt. Sta. 188+35 EL. 337.55

B.M. 30 CHISELED SQ. ON CONC. AIRHOSE FOUNDATION MOBILGAS STATION 58' LT. STA. 192+75.5 ELEV. 339.68'