


B.M. 32 SIR 36' POP 39.5' RT. STA. 207+63 ELEV 344.90

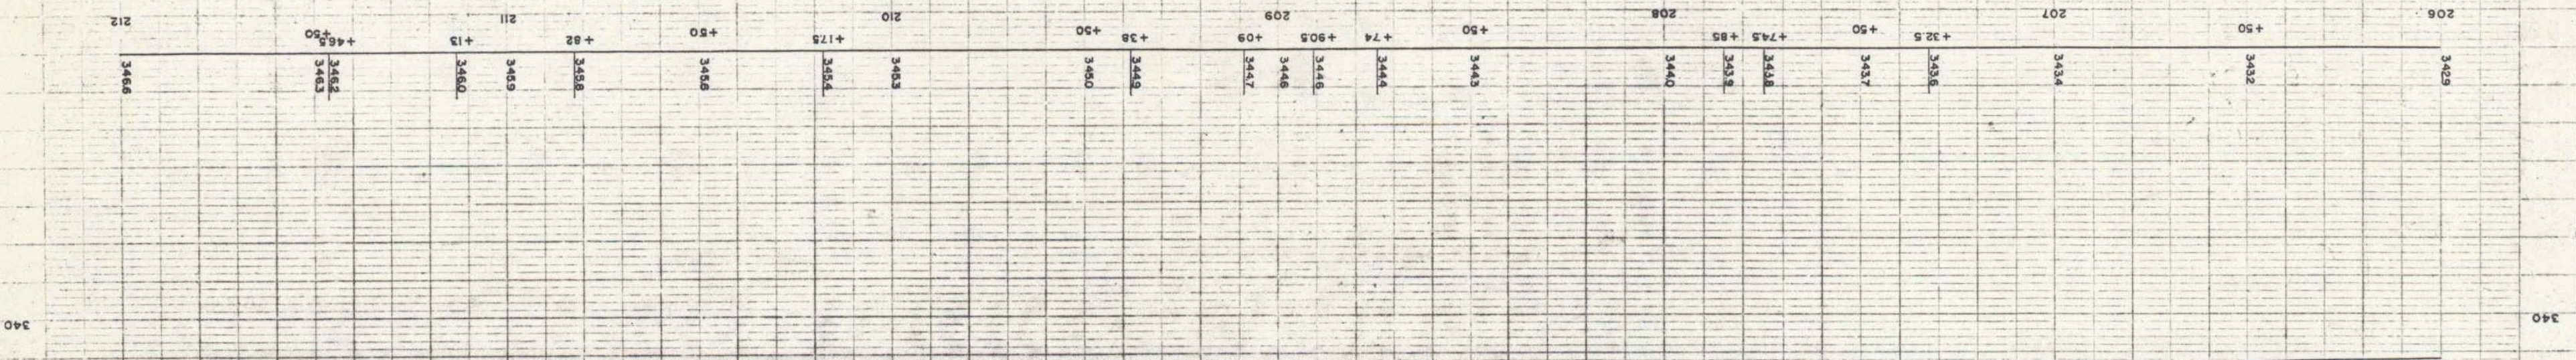

STA 206+50
END APPROACH
CONSTRUCTION

CONSTRUCT DRIVE
STATION
RIGHT
206+03

PEOPLES USED CARS
NO. 100

STATION
206+00
206+50
TOPSOIL & SEEDING
ITEMS 621 & 611


BIT CONC.
PARCEL 87

EDGE SURF TREATMENT
E1 & CONC. P/W/FT

STATION
206+00
206+50
ONE COURSE CEMENT
CONC SIDEWALK ITEM 560

STATION
206+00
206+45
LEFT
ITEM 556-B
GRANITE CURB

CONSTRUCT DRIVE
LEFT
206+60

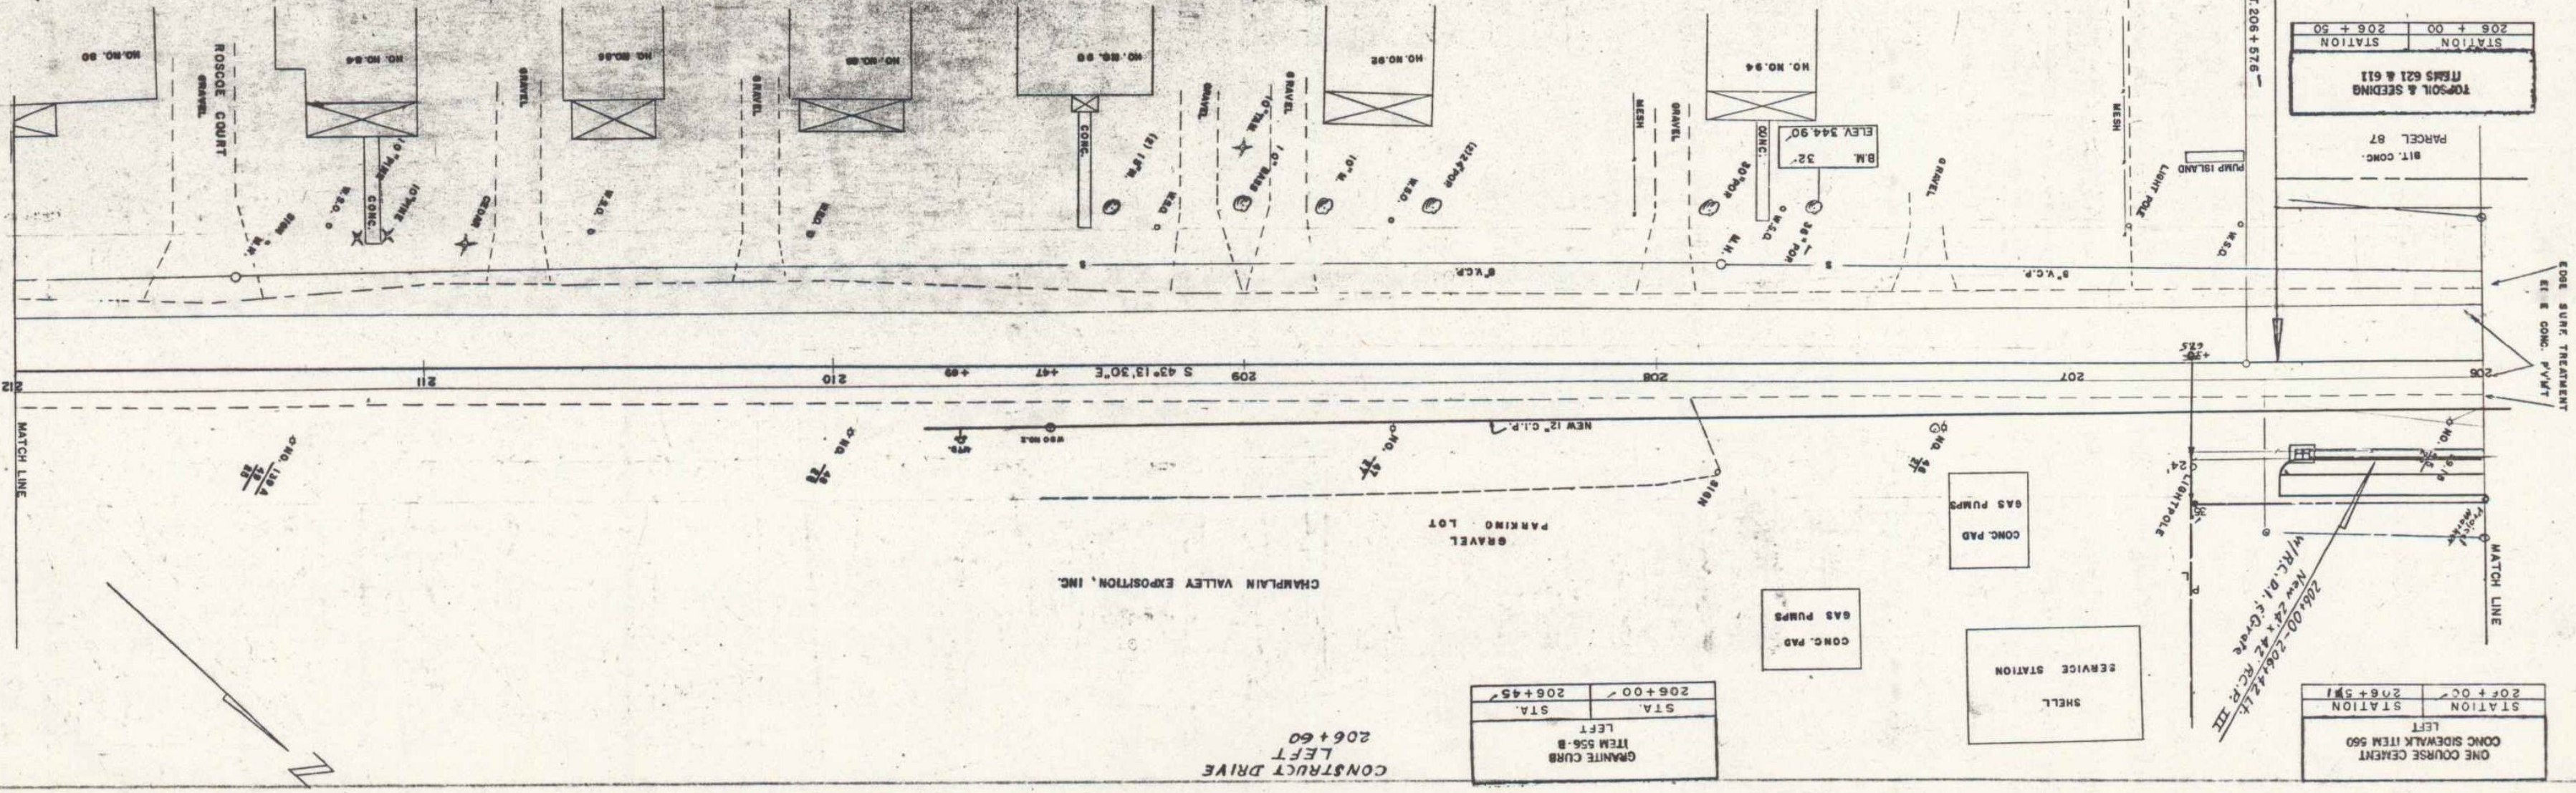

WESTER-MARTIN INC. 5-87
WESTER-MARTIN INC. 7-87

WESTER-MARTIN INC. 5-87
WESTER-MARTIN INC. 7-87

206+00-206+45
NEW 12\"/>