

PC	PVI	PT	VC	STATION	PC	PVI	PT	VC	STATION	PC	PVI	PT	VC	STATION
127	127.5	128	300	127.5	128	128.5	300	128.5	129	129	129.5	200	129.5	130

FORT ETHAN ALLEN RESERVATION

"SUSIE WILSON" ROAD
STA. 127 + 05 2/22/56

DR. HILL

T. PARIZO

O.B. FLEURY

Stone Bound
DROP INLET


NEW VILLAGE LINE 2/22/56

FROM STATION 127 TO STATION 130 NOT INCLUDED IN PROPOSED

VC. 300'

VC. 300'

VC. 200'

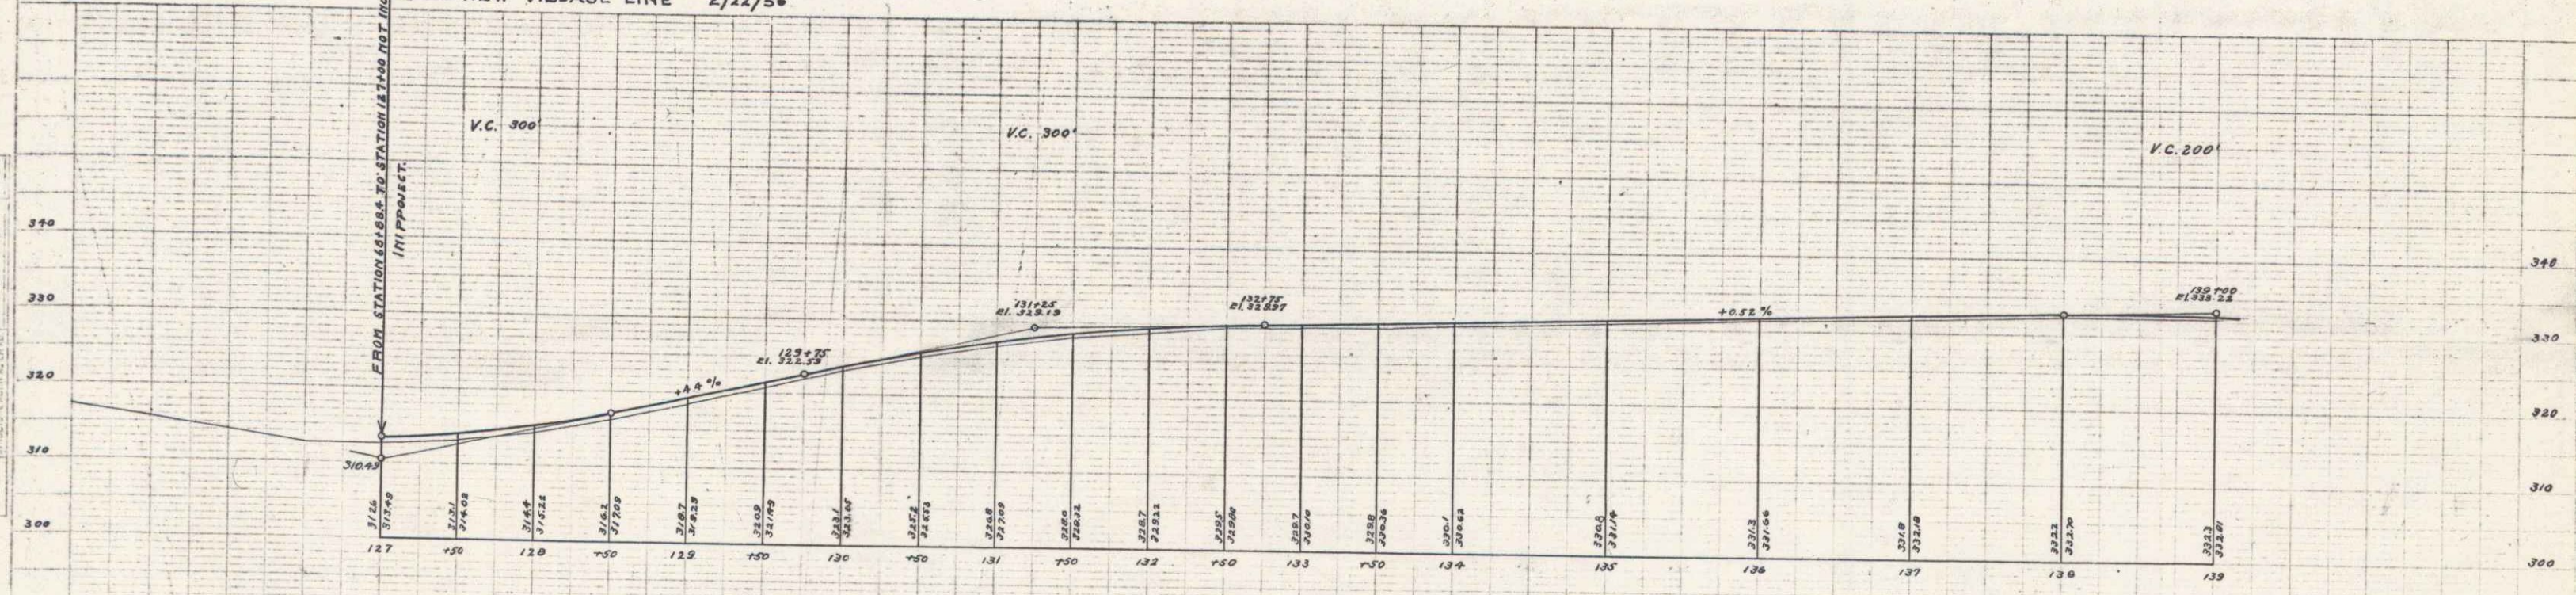

B.M. On Sill of House opposite Sta 127.7 E. by Corner Elm. 110.62
B.M. On Spike in White Birch near Sta 127.00 Elev. 100.00
32/55

Series of Maps
Sheet No. 6
1/24/56

5