



9.65
 9.45
 9.25
 0.00
 -0.20
 -0.40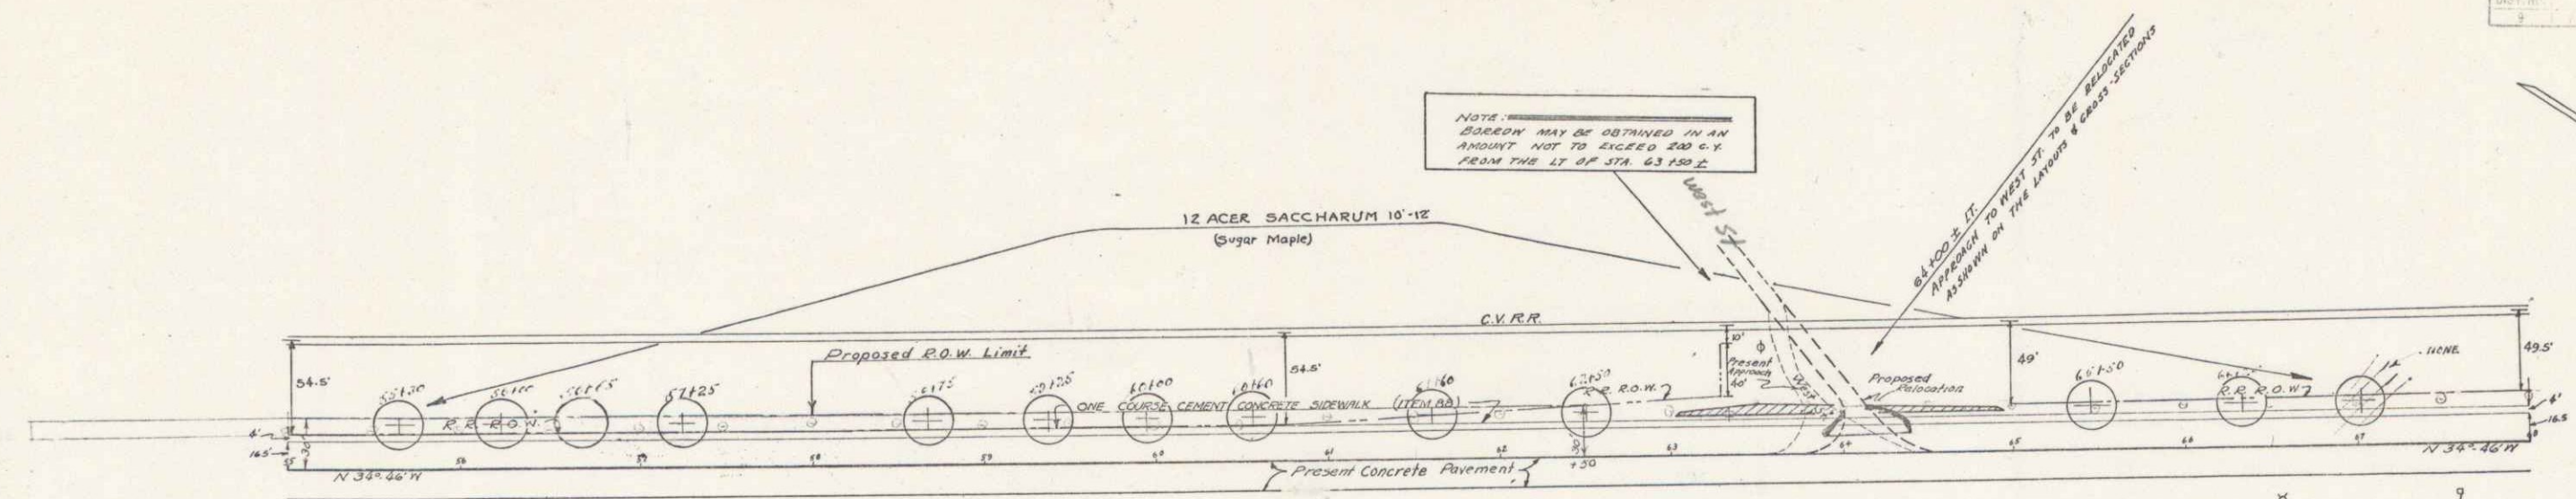
NOTE:
 BUREAU MAY BE OBTAINED IN AN
 AMOUNT NOT TO EXCEED 250 C.Y.
 FROM THE LT. OF STA. 63+00.0

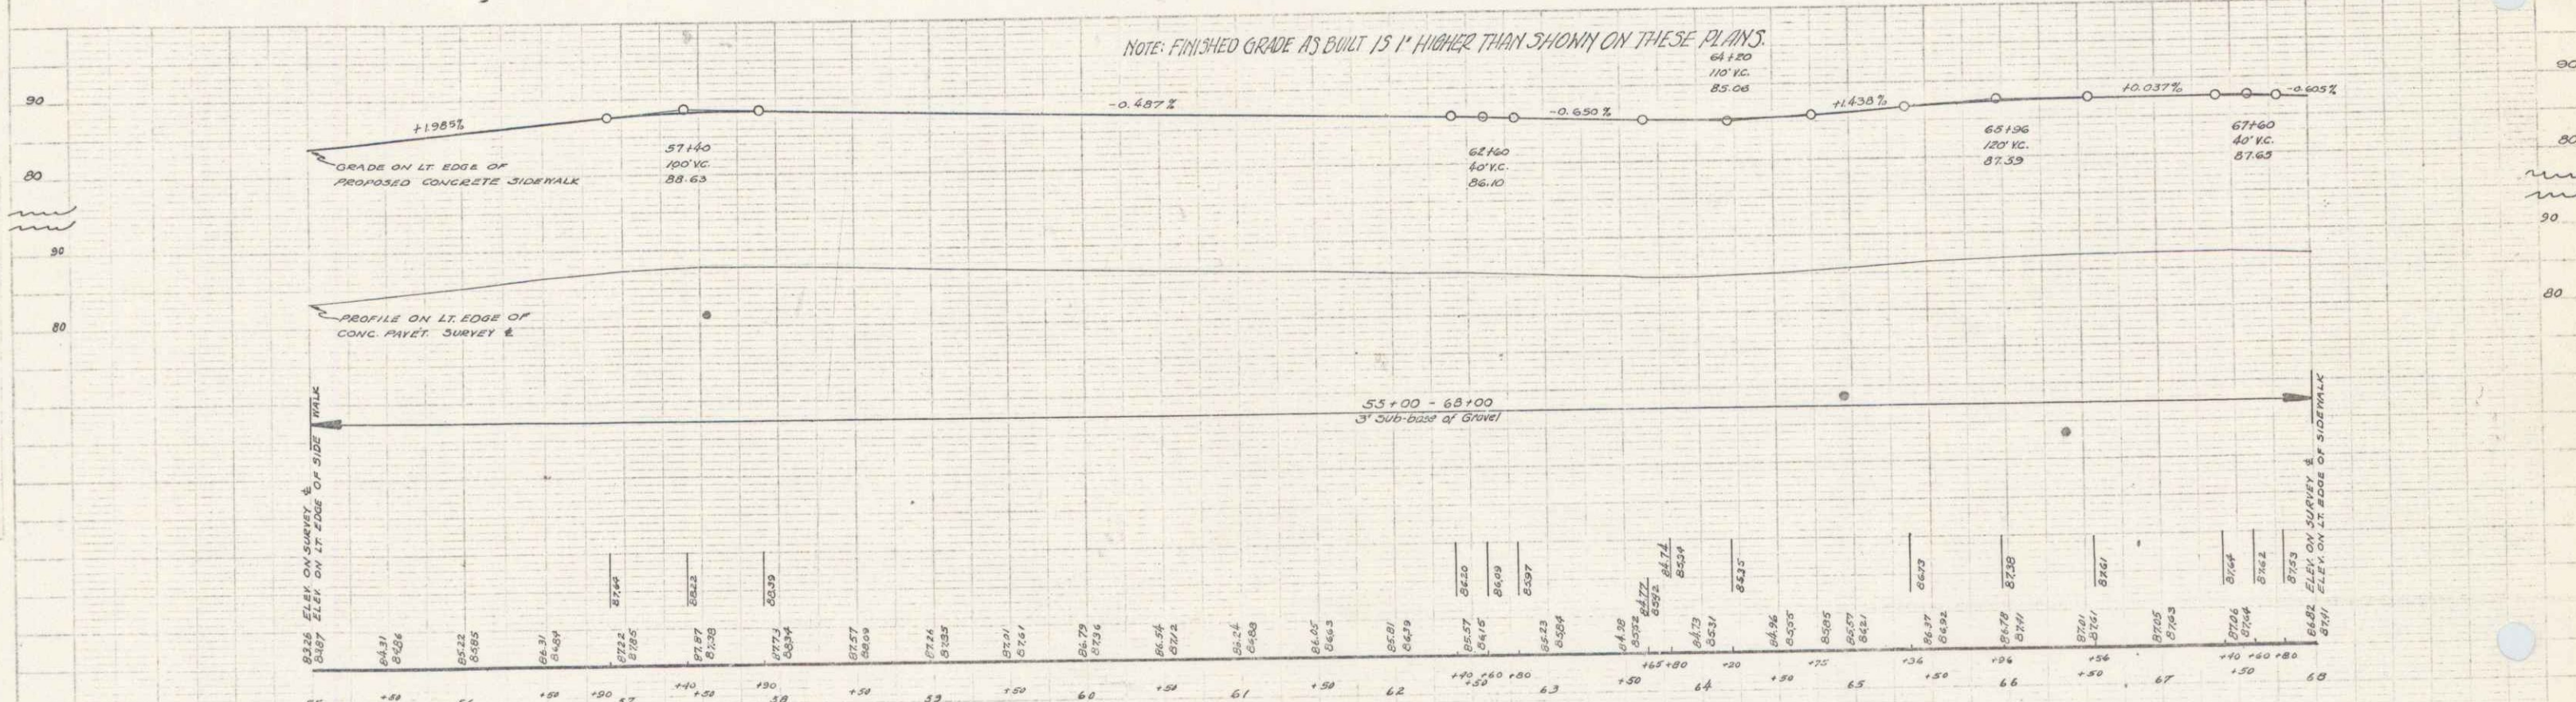

NOTE: FINISHED GRADE AS BUILT IS 1' HIGHER THAN SHOWN ON THESE PLANS.

B.M. #9 SPOT ON CONCRETE SIDEWALK 25 FEET OF STA. 59+94 ELEV. 87.40
 B.M. #10 SPOT ON CONC. PDM. ESSO SIGN 27 FT. RT. OF STA. 67+60 ELEV. 87.34