

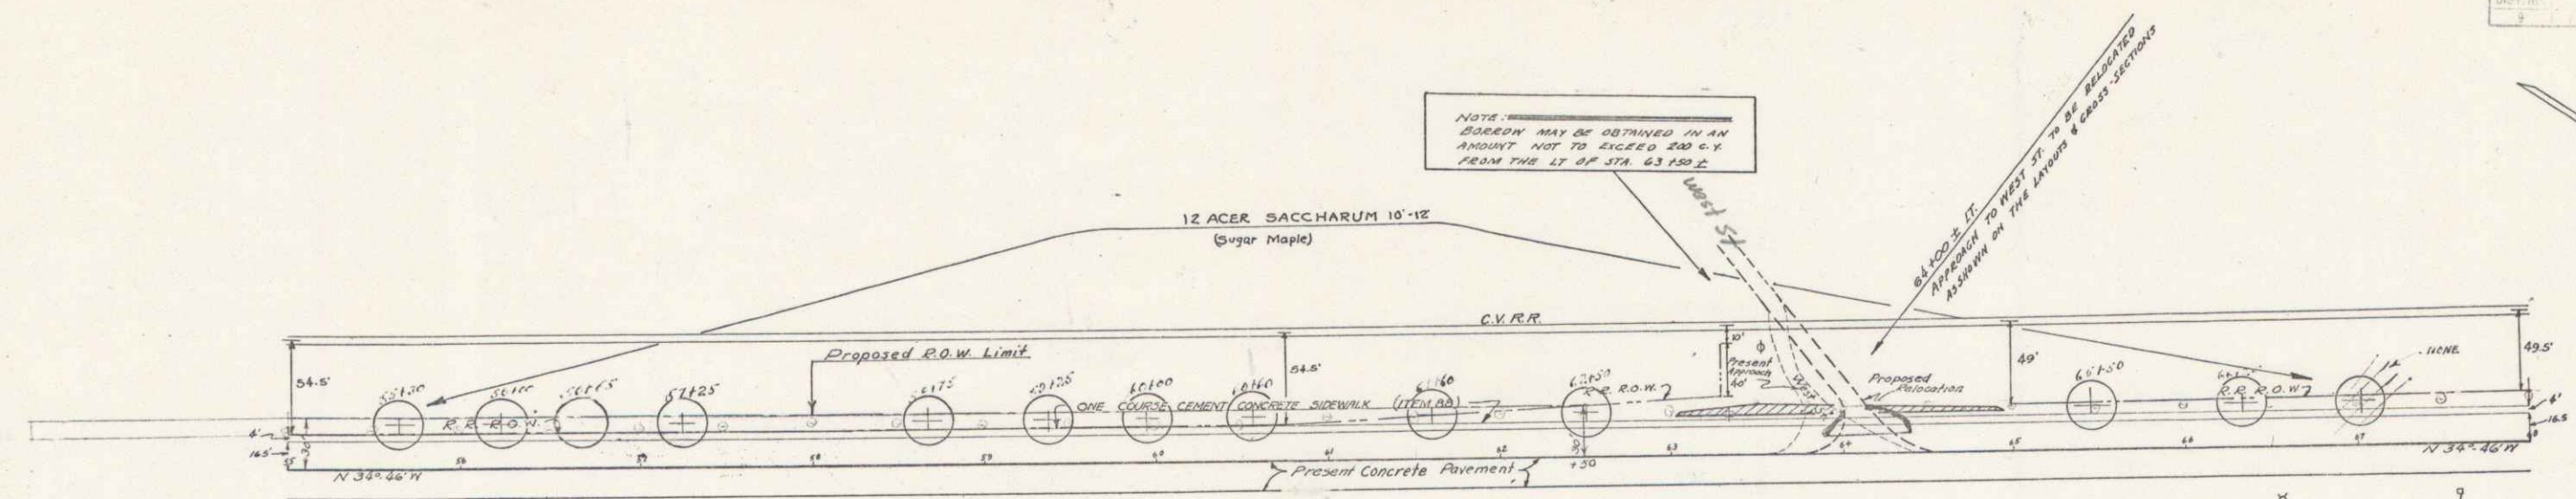


D.M. #8 PAINT SPOT ON CONC. STEP 25 FT. STA. 53+73 EL. 86.18

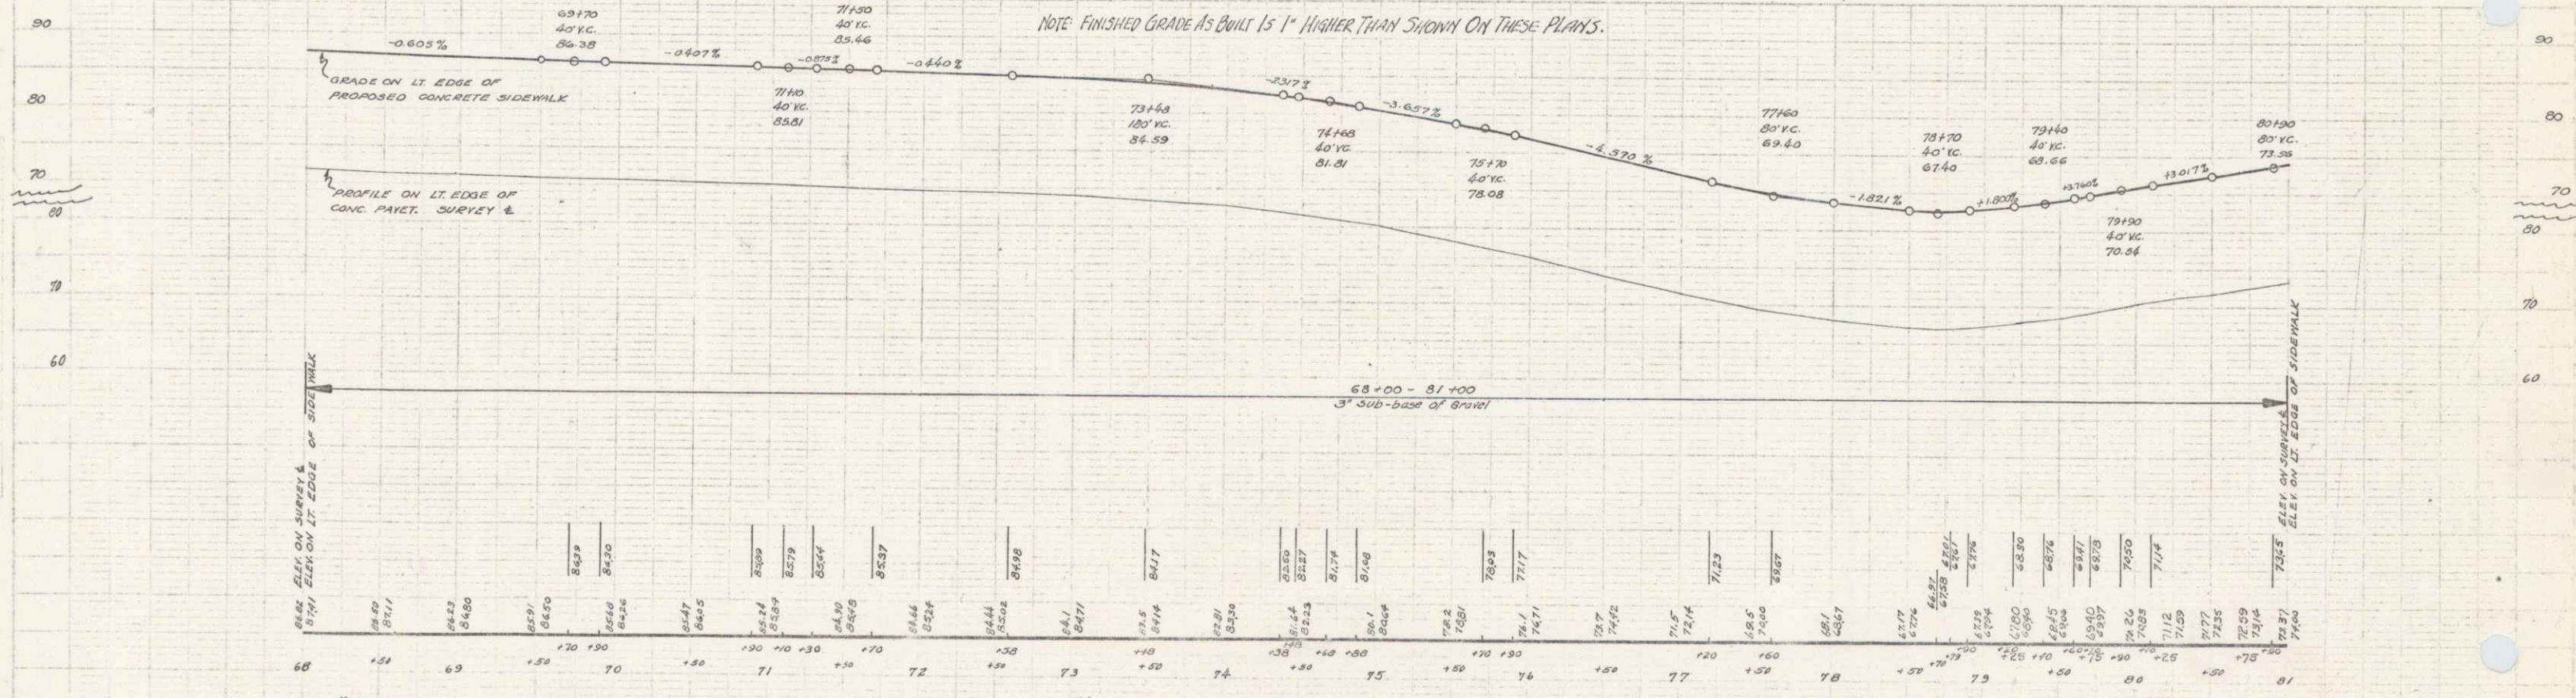


NOTE:
 BUREAU MAY BE OBTAINED IN AN
 AMOUNT NOT TO EXCEED 250 C.Y.
 FROM THE LT. OF STA. 63+00.0

9.65
 9.44
 9.23
 0.00
 -0.21
 -0.42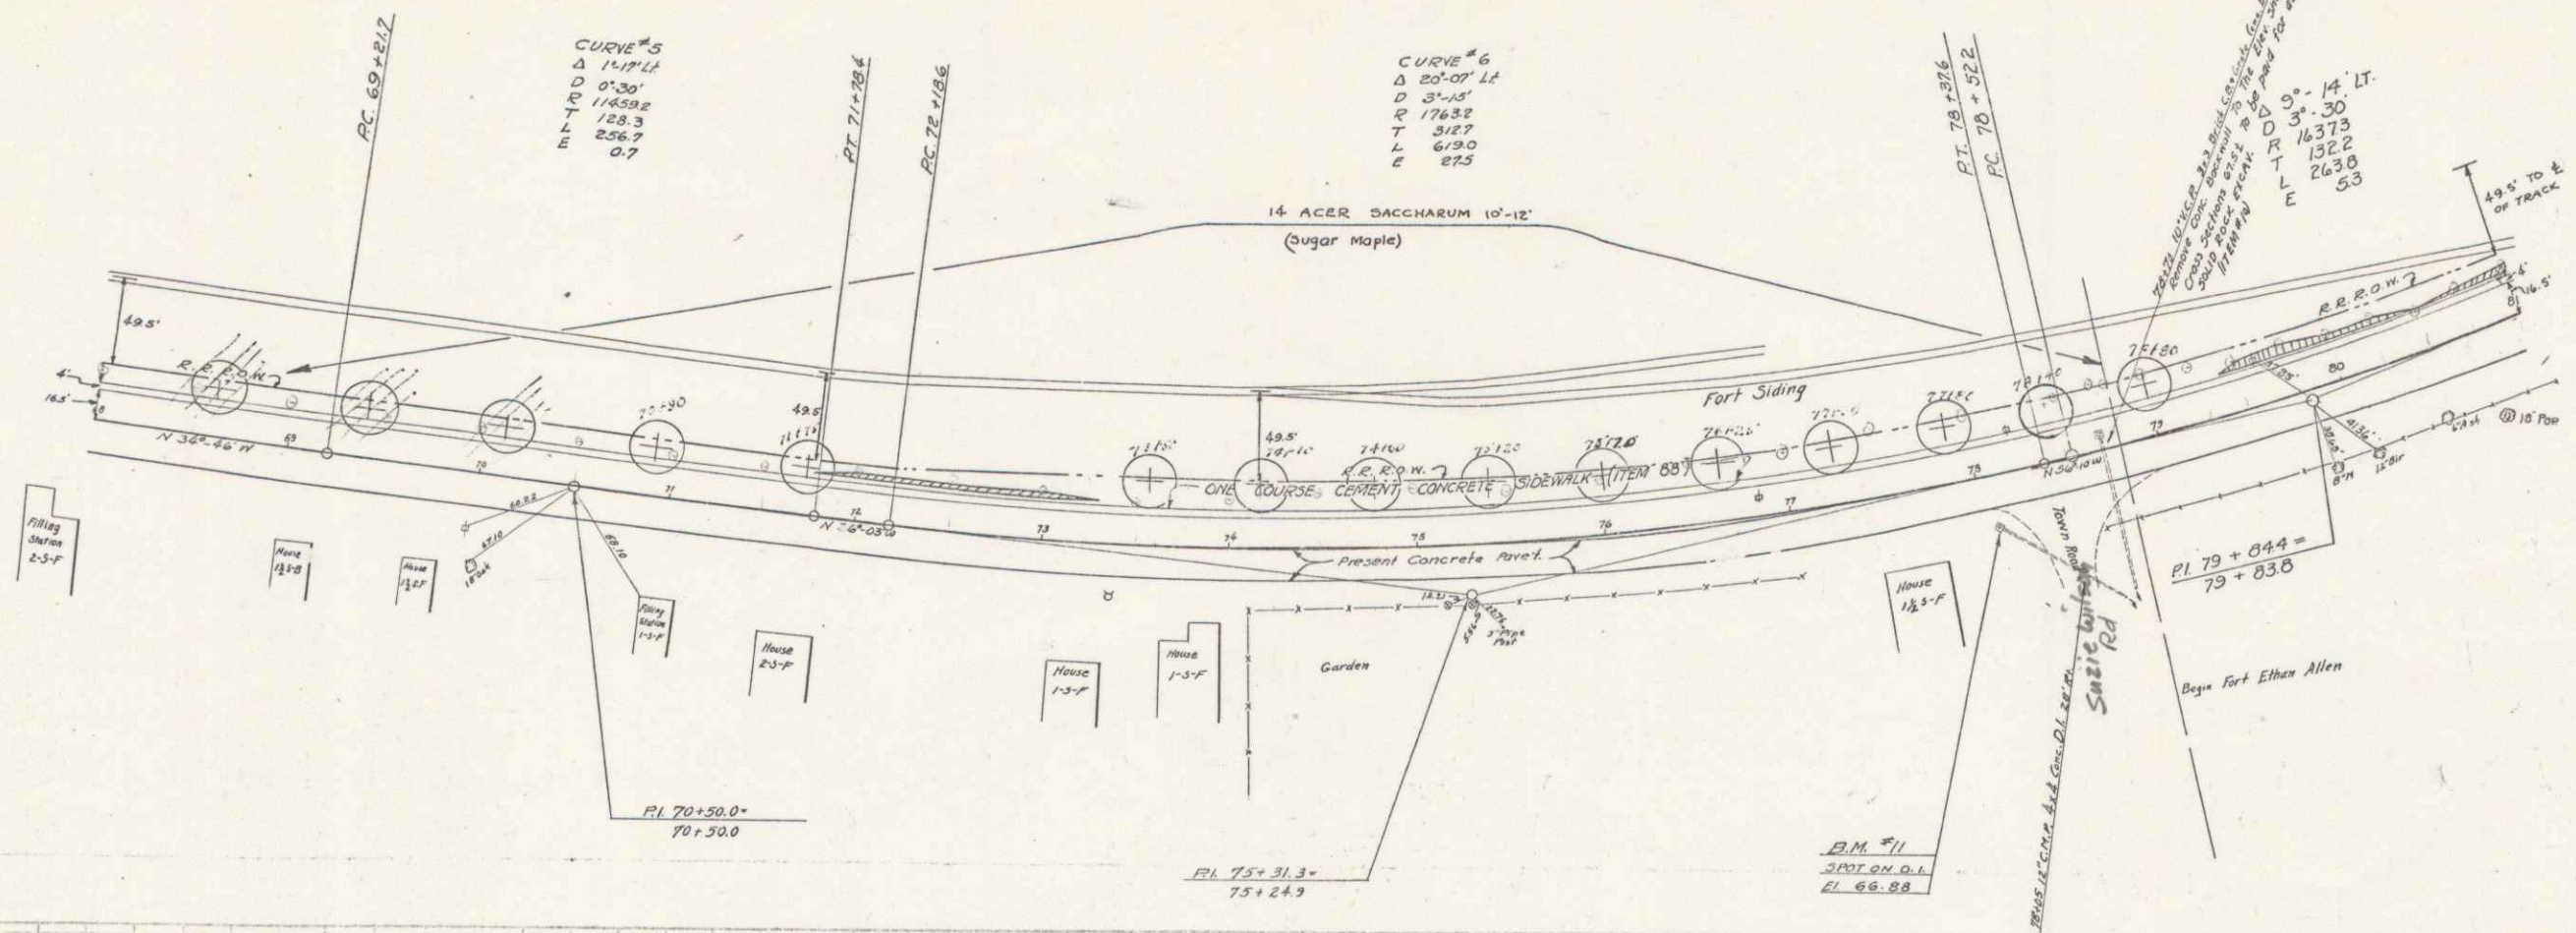
3-14
SHERKETT
LINTINE

3-16
SHERKETT
LINTINE

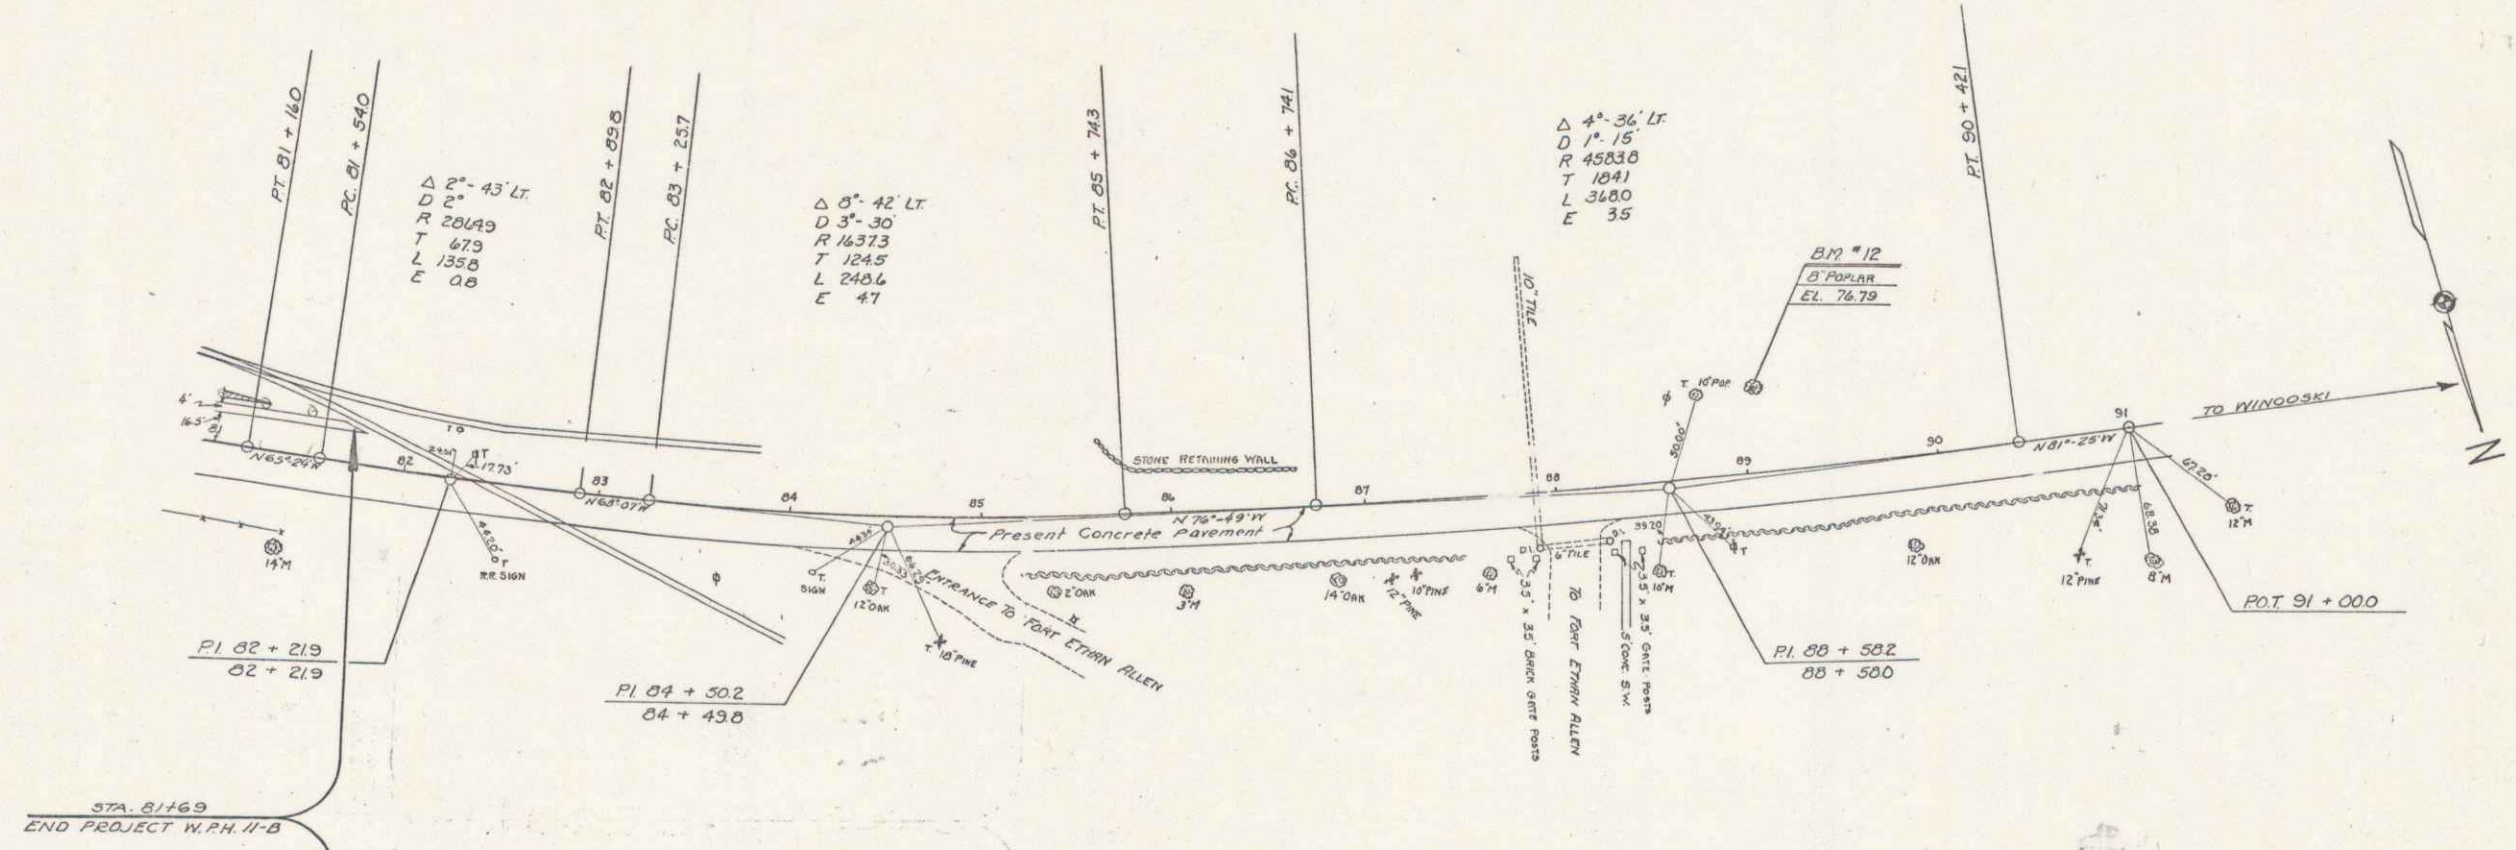

STA. 8169
END PROJECT W.P.H. 4-B

NOTE FINISHED GRADE AS
SHOWN IS 1" HIGHER THAN
SHOWN ON THESE PLANS.

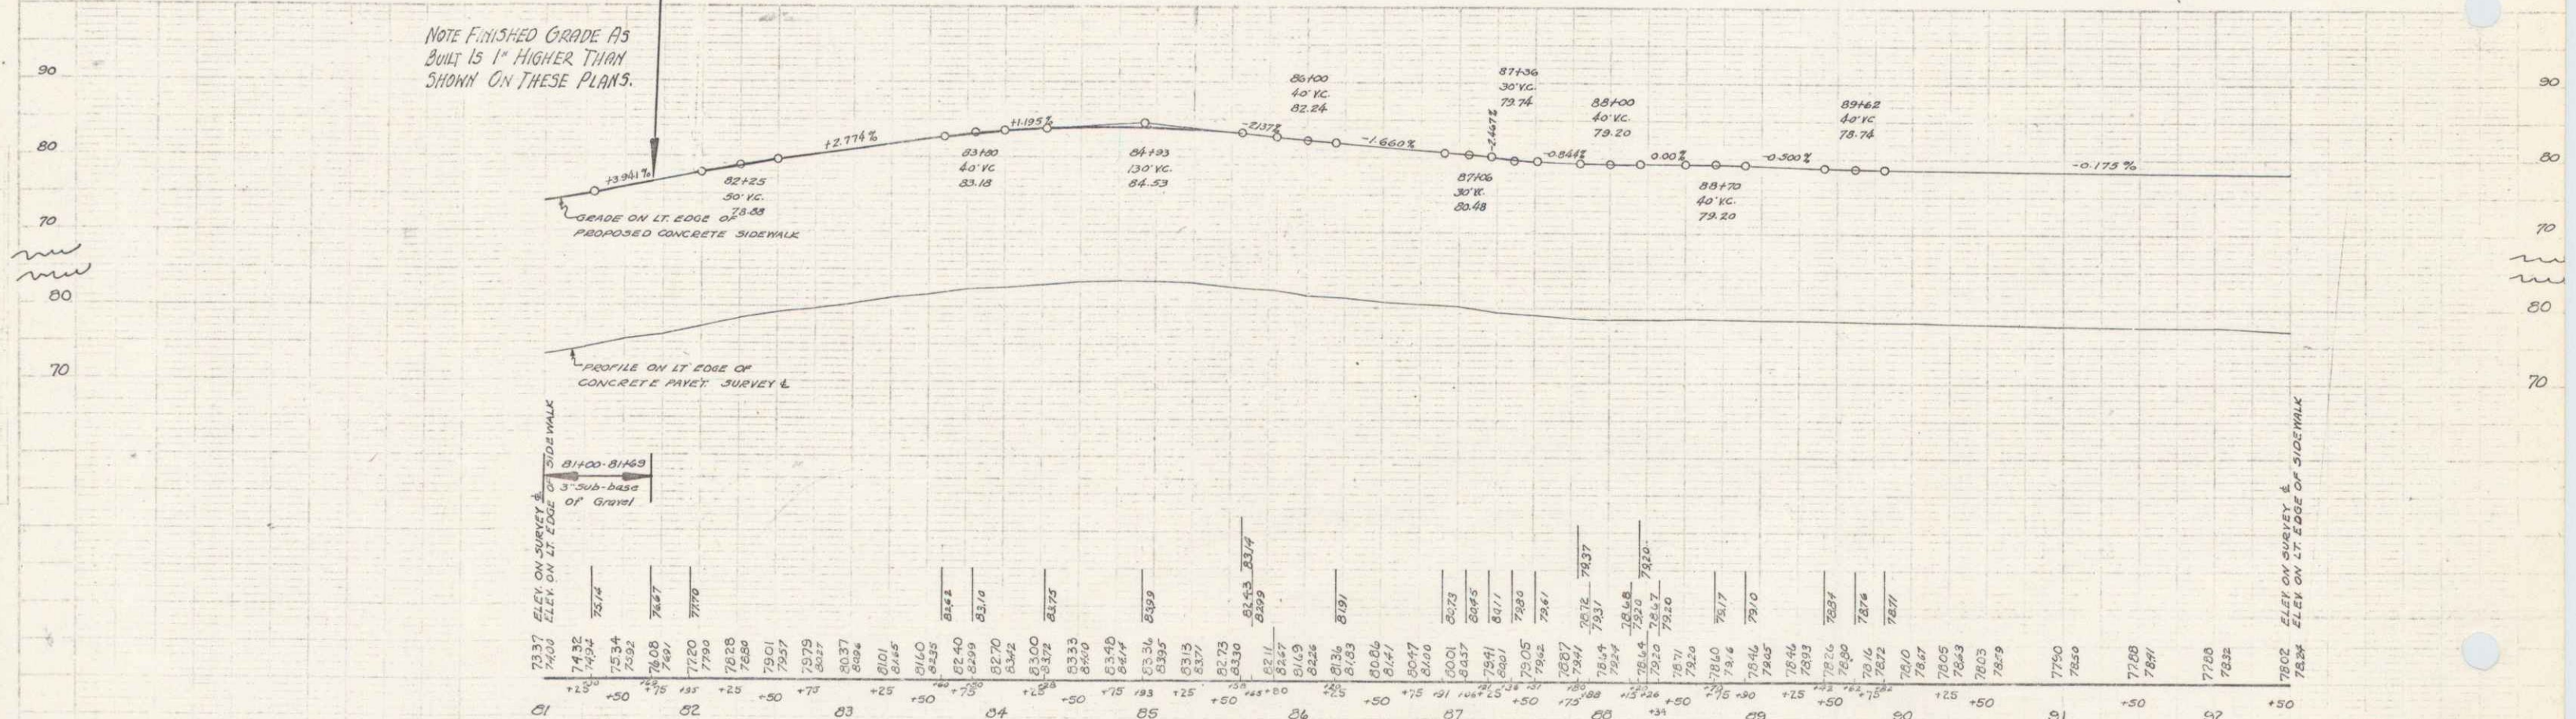

B.M. #12; Spike in root of Poplar Sta. 89+07 El. 76.79

5