
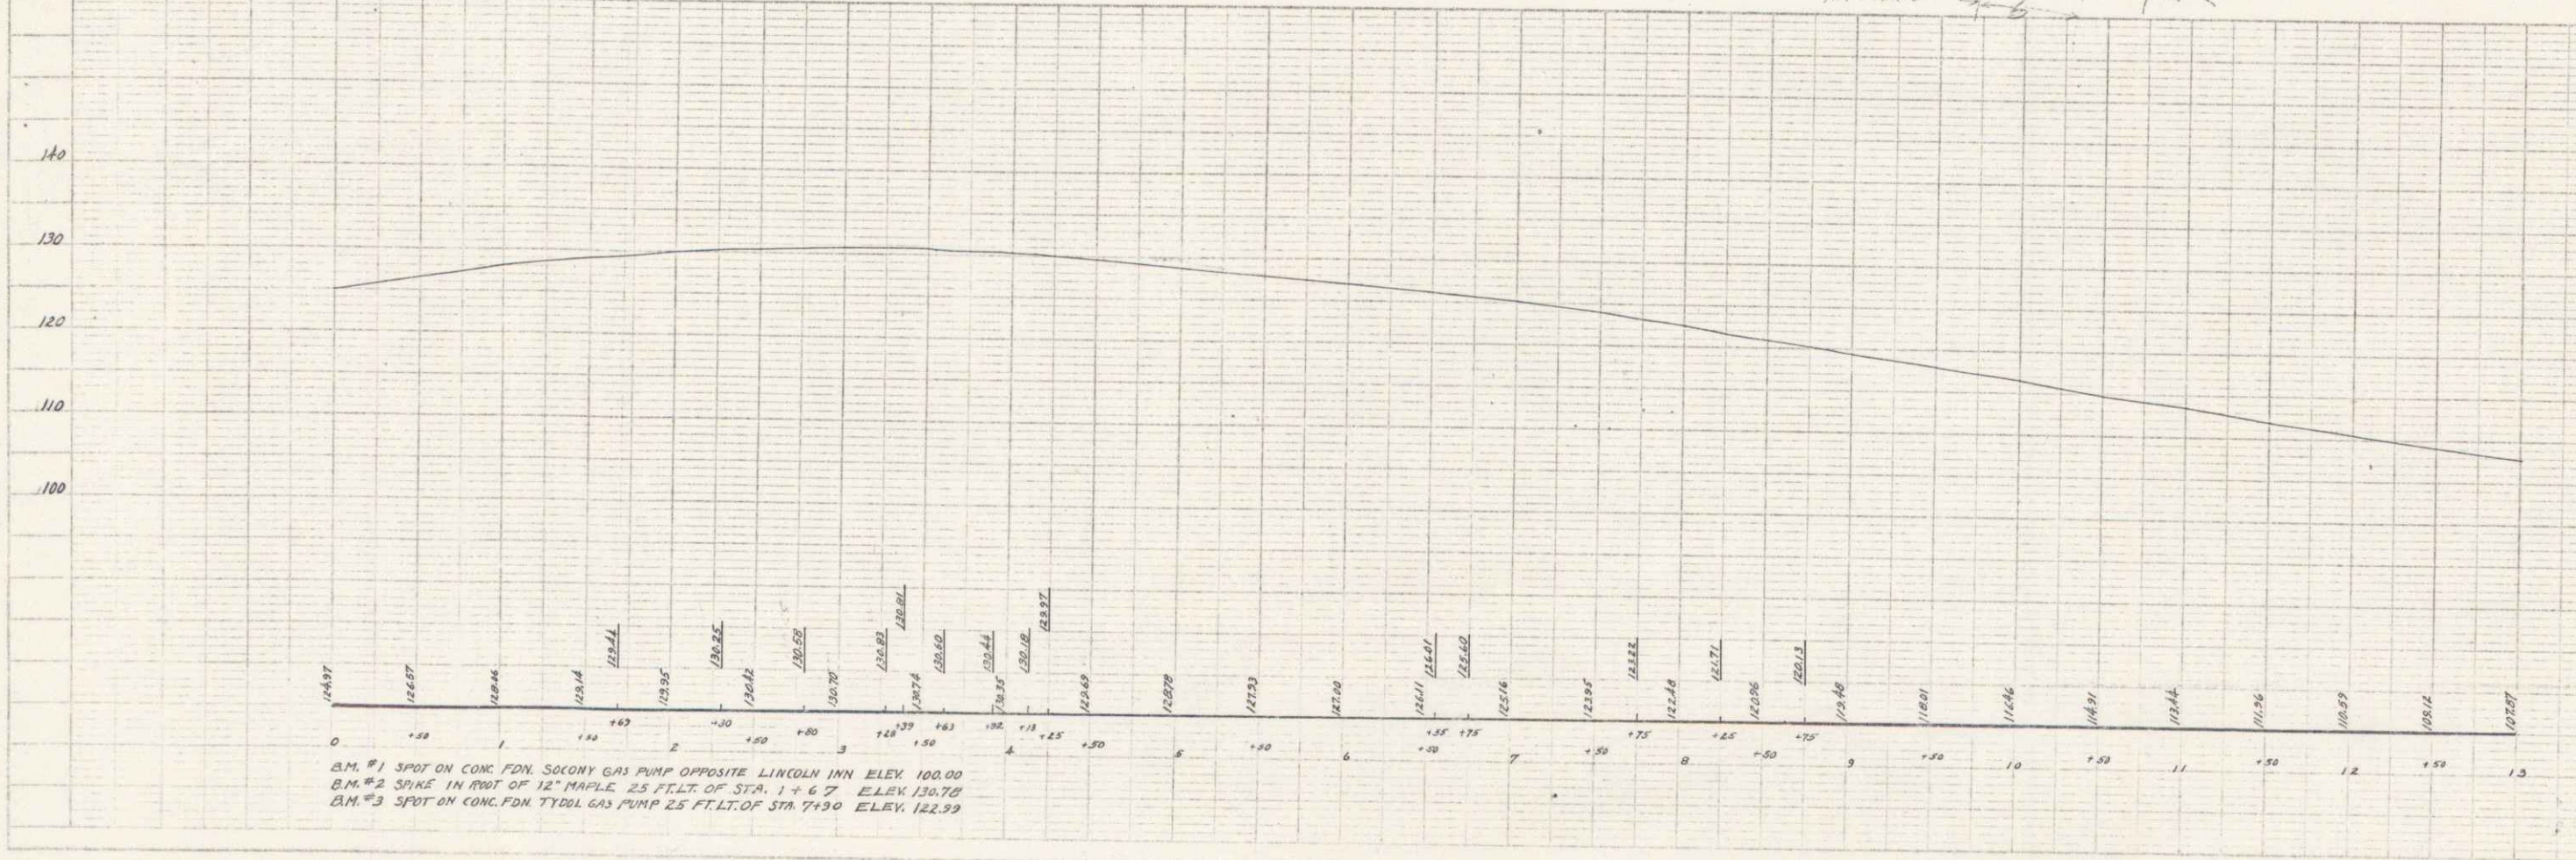


PLAN  
 1/4" = 1'-0"  
 1/8" = 1'-0"  
 1/16" = 1'-0"  
 1/32" = 1'-0"  
 1/64" = 1'-0"  
 1/128" = 1'-0"  
 1/256" = 1'-0"  
 1/512" = 1'-0"  
 1/1024" = 1'-0"  
 1/2048" = 1'-0"  
 1/4096" = 1'-0"  
 1/8192" = 1'-0"

PLAN  
 1/4" = 1'-0"  
 1/8" = 1'-0"  
 1/16" = 1'-0"  
 1/32" = 1'-0"  
 1/64" = 1'-0"  
 1/128" = 1'-0"  
 1/256" = 1'-0"  
 1/512" = 1'-0"  
 1/1024" = 1'-0"  
 1/2048" = 1'-0"  
 1/4096" = 1'-0"  
 1/8192" = 1'-0"

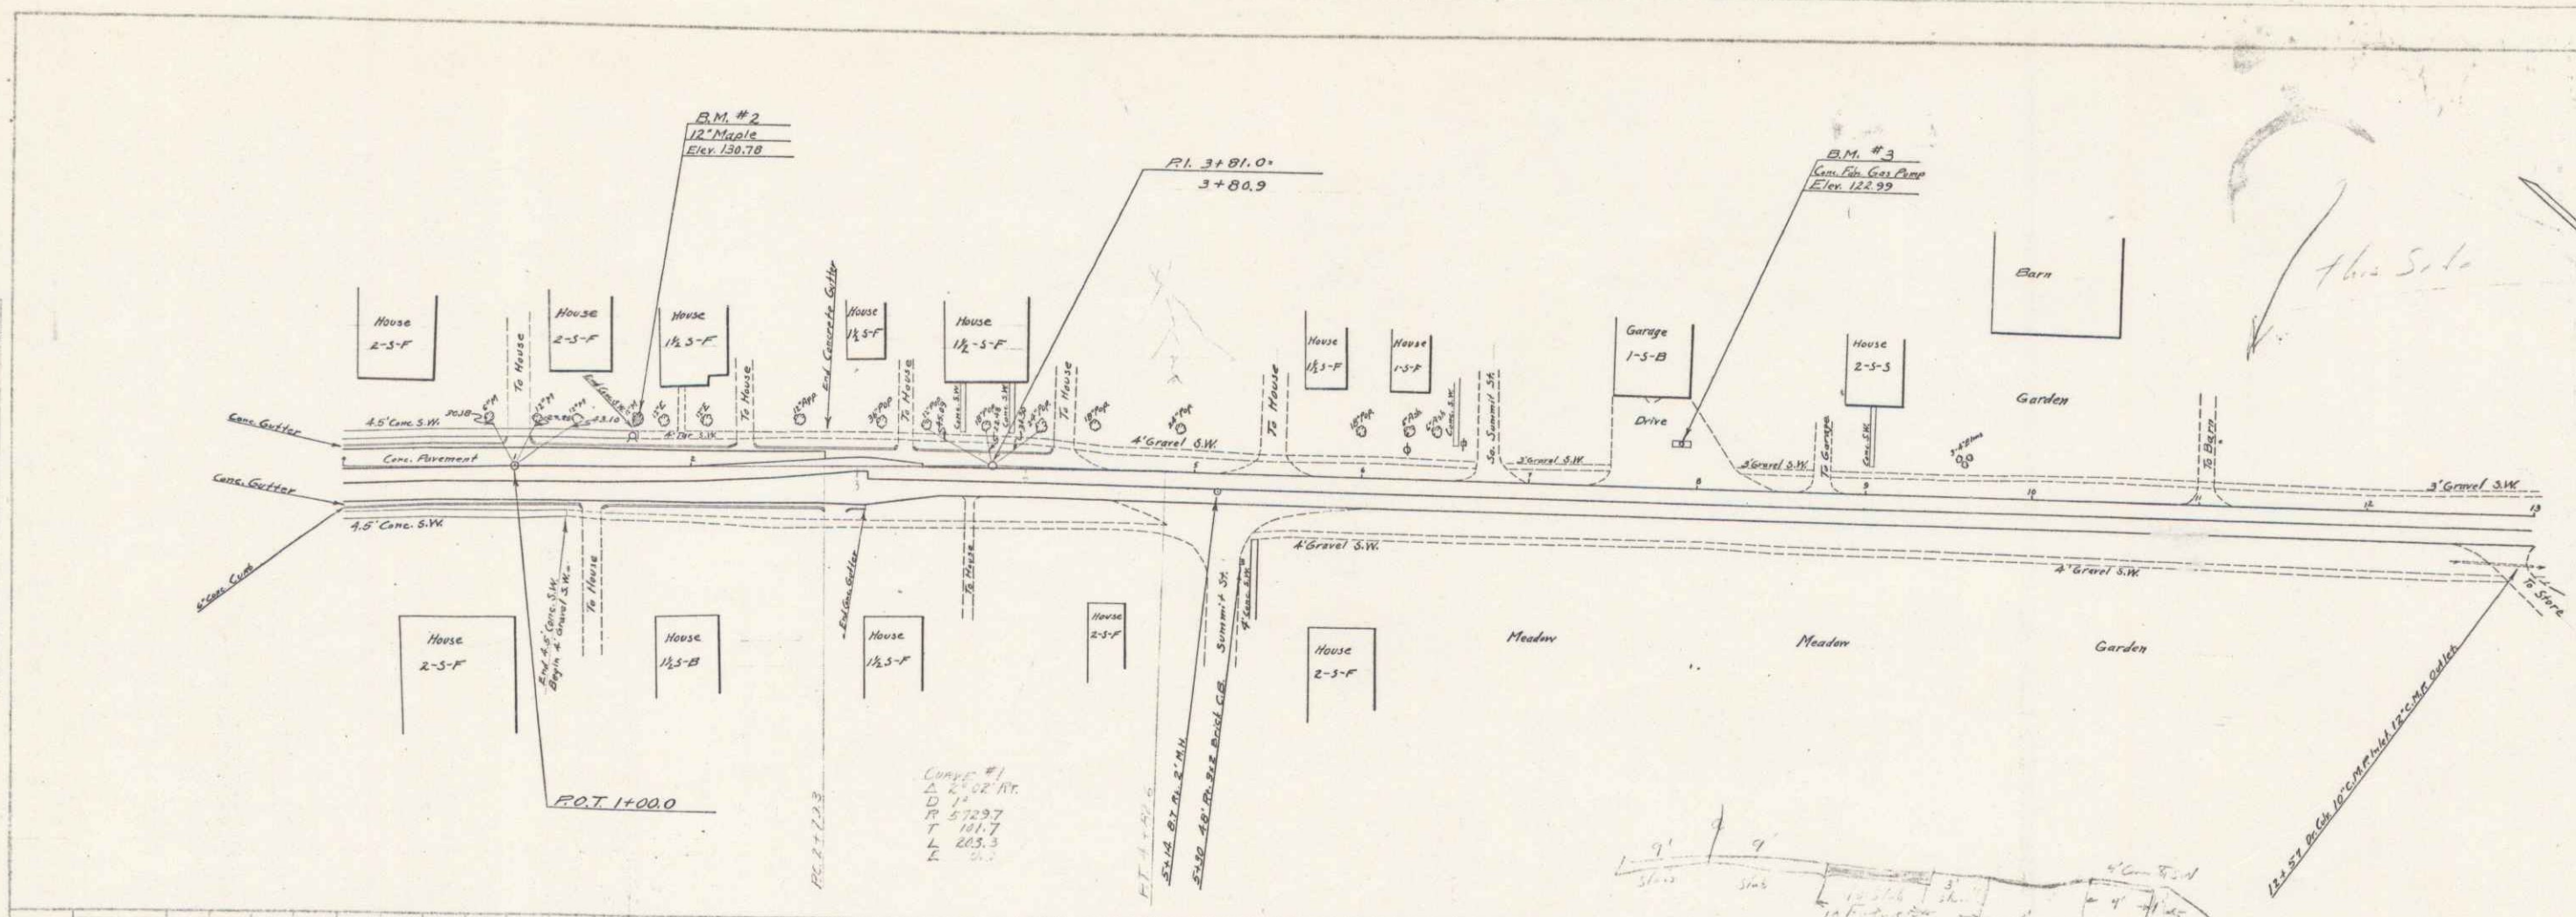

B.M. #1 SPOT ON CONG. FDN. SOCONY GAS PUMP OPPOSITE LINCOLN INN ELEV. 100.00  
 B.M. #2 SPIKE IN ROOT OF 12" MAPLE 25 FT. LT. OF STA. 1+67 ELEV. 130.78  
 B.M. #3 SPOT ON CONG. FDN. TYROL GAS PUMP 25 FT. LT. OF STA. 7+30 ELEV. 122.99