
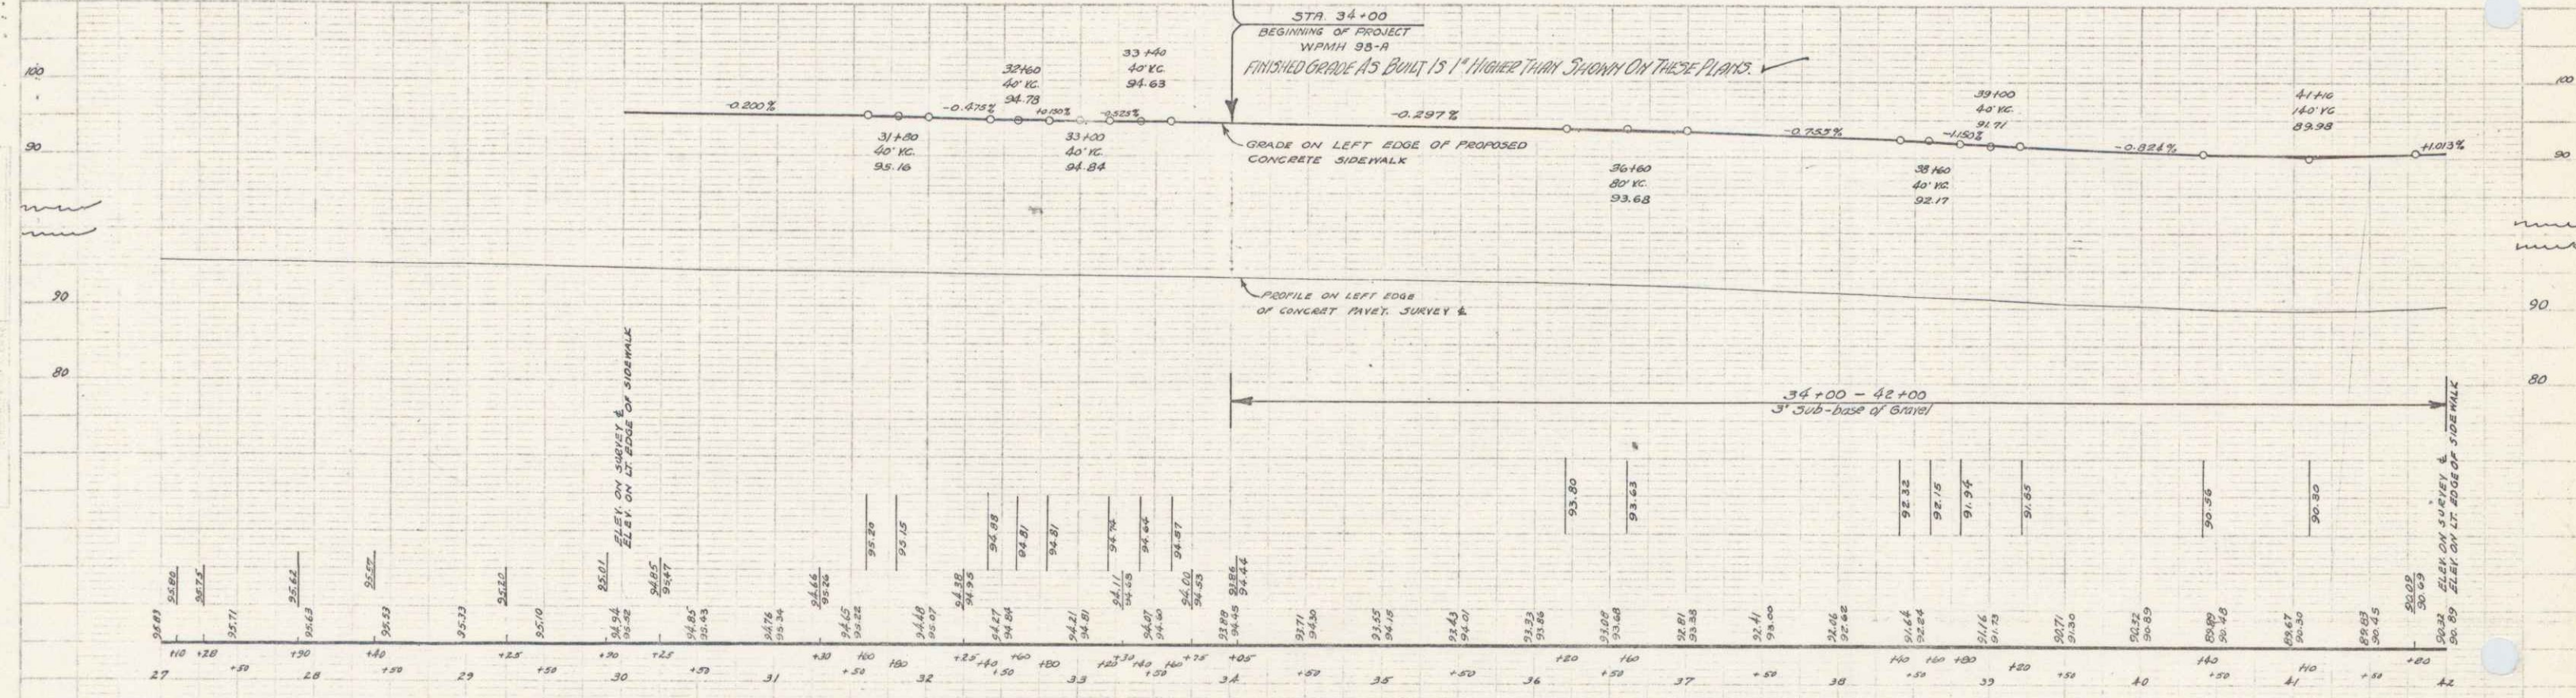


STA. WPMH 98-A  
 324 1236 3 12

PLAN  
 CONE  
 TRACED

PLAN  
 CONE  
 TRACED

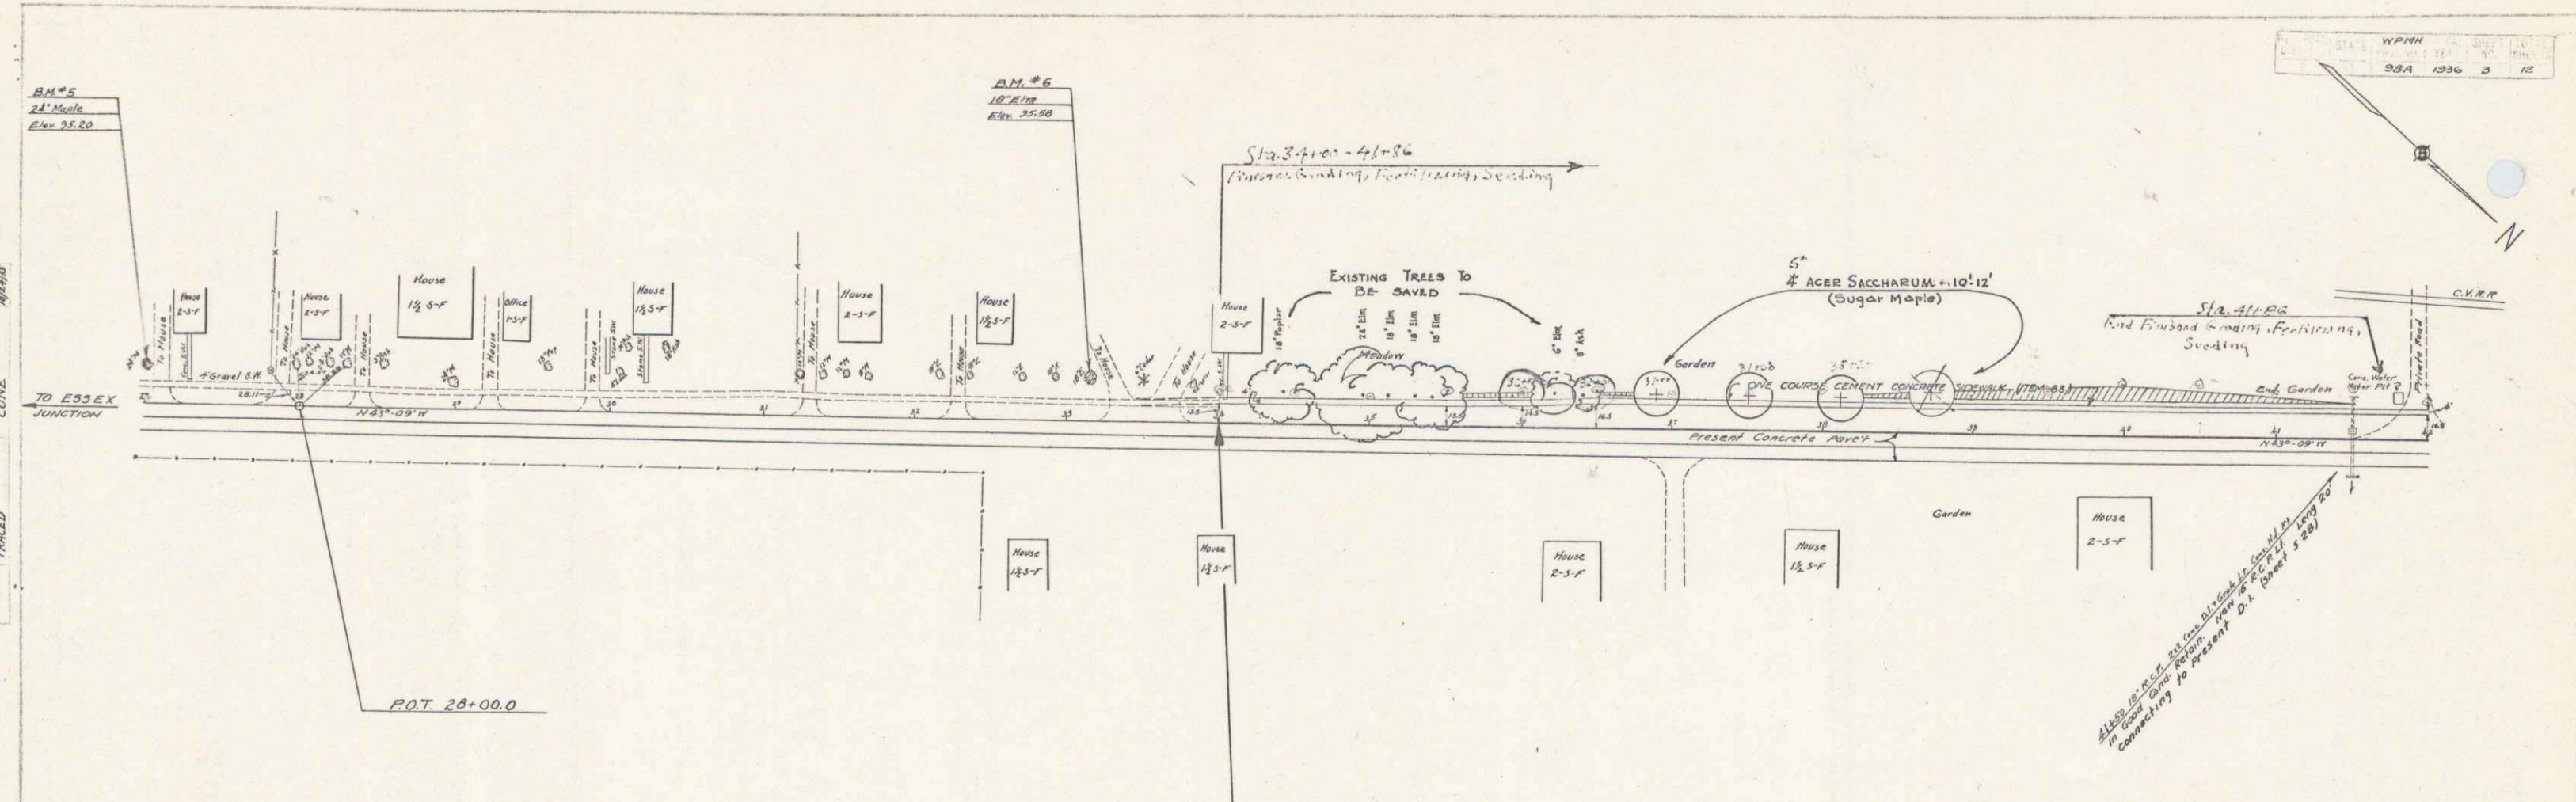

B.M. #5 SPIKE IN ROOT OF 24" MAPLE 22 FT. LT. OF STA. 27+00 ELEV. 95.20  
 B.M. #6 SPIKE IN ROOT OF 18" ELN 25 FT. LT. OF STA. 33+14 ELEV. 95.58

SERIES WPMH NO 98-A  
 SHEET 3 OF 12

4