
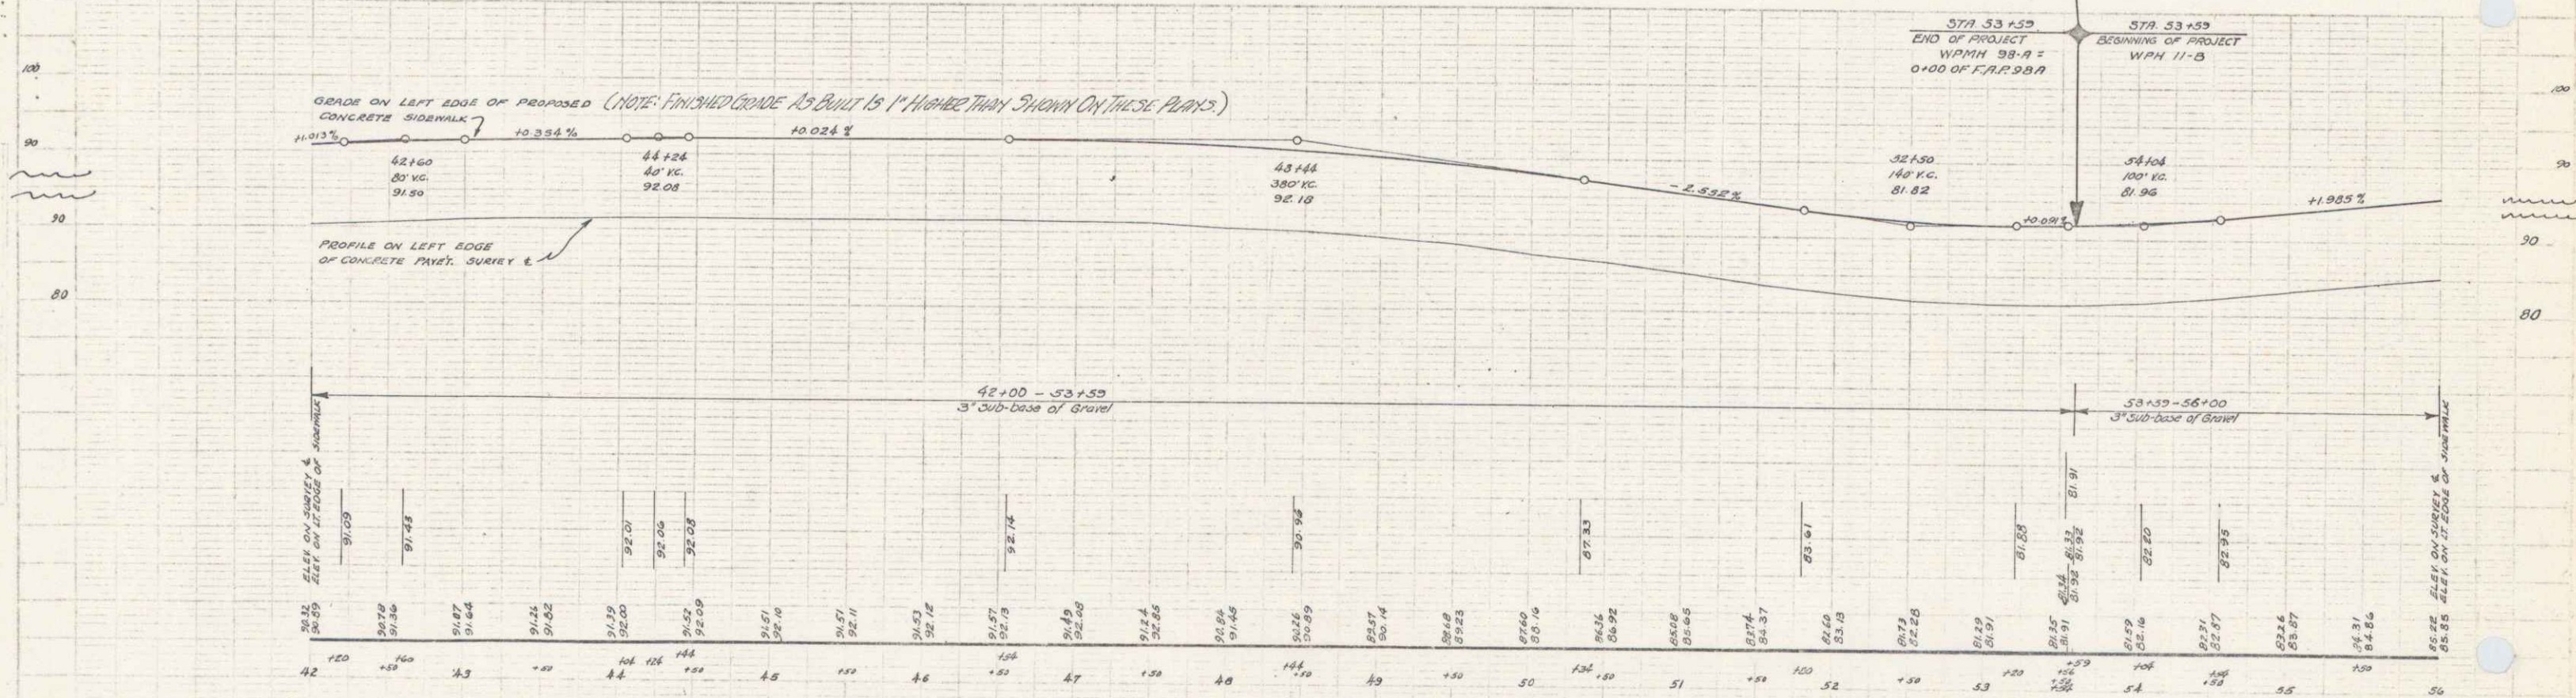


0.440 acres  
Inc. 98-A & 11-B

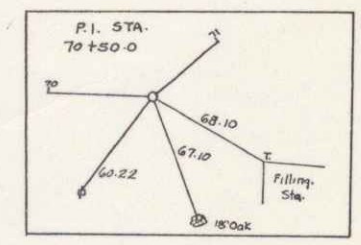

BM #7 SPIKE IN ROOT OF THIN 4' ELMS 22 FT. LT. OF STA. 42+12 ELEV. 89.14  
 BM #8 SPOT ON CONC. STEPS 25 FT. RT. OF STA 50+73 ELEV. 86.18

5