


Parcel 41
 Kind of Release
 Date of Release 10-12-35
 County Lena Varney
 Grantee St. of W. Cal. Sta. 378+00
 Remarks

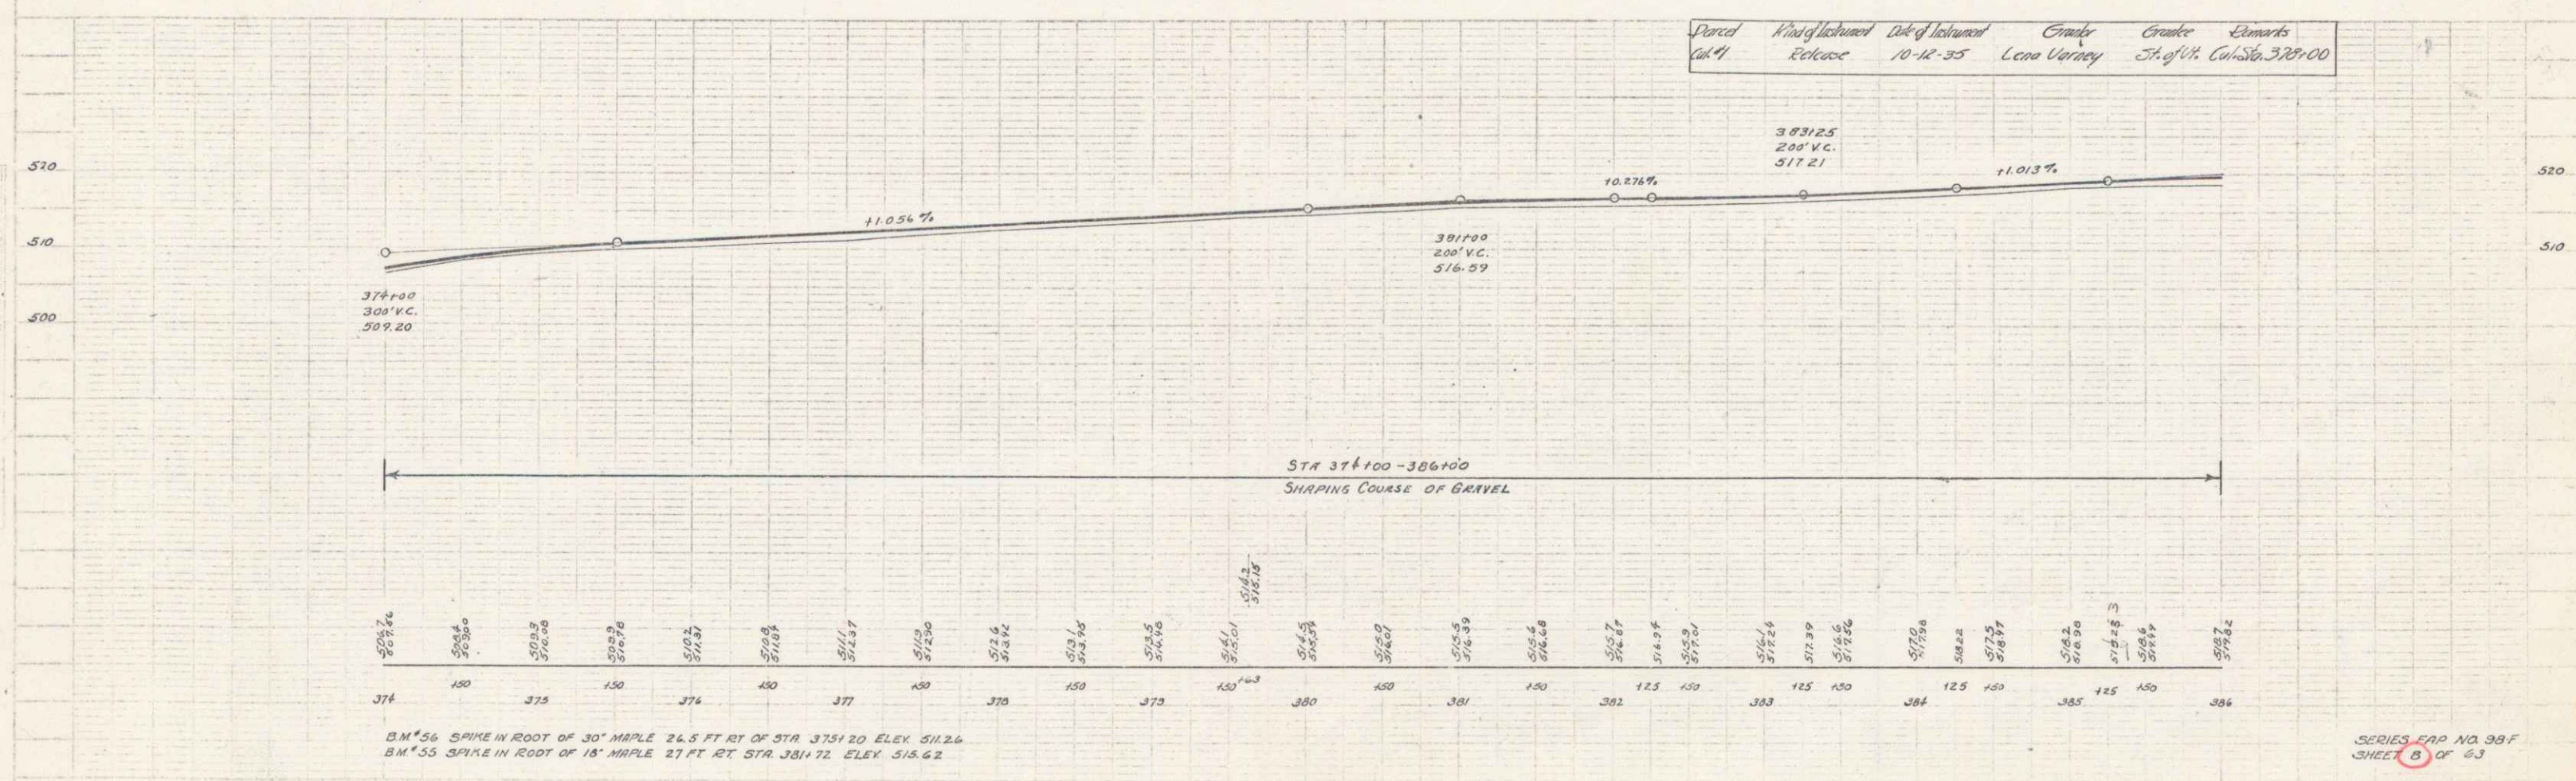

BM #56 SPIKE IN ROOT OF 30' MAPLE 26.5 FT RT OF STA. 375+20 ELEV. 511.26
 BM #55 SPIKE IN ROOT OF 18' MAPLE 27 FT RT STA 381+72 ELEV. 515.62

6