


Parcel	Kind of Instrument	Date of Grant	Grantor	Grantee	Recorded	Remarks
Lot #1	Return	10-11-35	N.E. Bogue	J. J. H.	Cal Sta 28140	

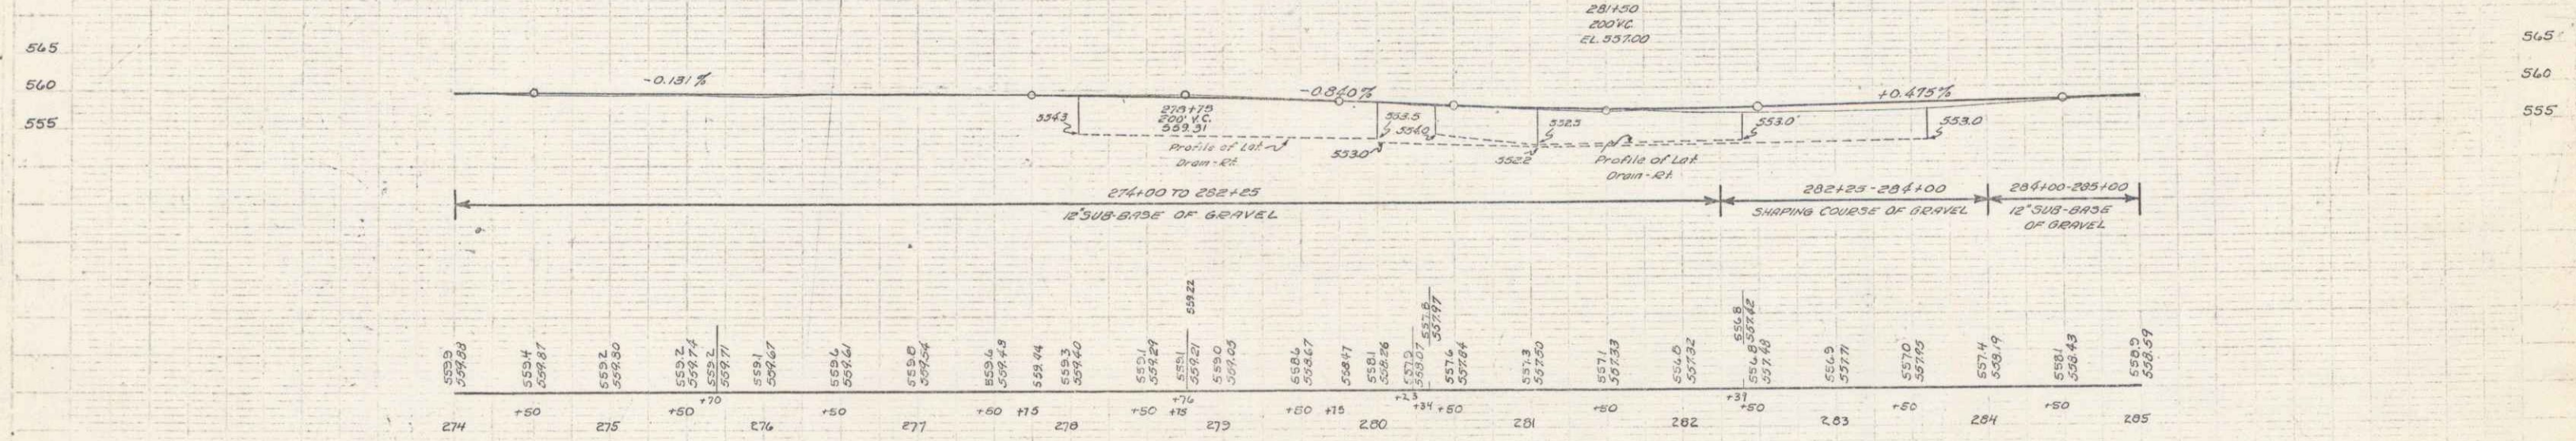

B.M. *39 - Spike in roof 30' Elm 310 Lt Sta 275 + 17 - Elev. 560.37
 B.M. *39-A - PAINT SPOT ON SCHOOL HOUSE STEP 710 RT Sta 275 + 00 ELEV. 560.62
 B.M. *40 - Spike in roof 12' Elm 240 Lt Sta 282 + 00 Elev. 556.95
 B.M. *40-A - Paint Spot On Conc. Gas Pump Found 235 Rt. Sta 280 + 34 Elev. 558.19