

FED. ROAD DIST. NO.	STATE	PROJ. NO.	SHEET NO.	TOTAL SHEETS
3	VT	127-CARL	1	1

INDEX OF SHEETS

1	TITLE PAGE	
2	TYPICAL SECTIONS OF IMPROVEMENTS	GRAVEL
3	SINKING & WIDENING TABLES	PAVED IN PLACE SURFACE
4-61	PLAN & PROFILE SHEETS	
62	STRUCTURE SHEET	5-20 PIPE CULVERTS
63	"	5-21 BOX CULVERTS
64	"	5-22 GUARD RAIL
65	CULVERT	5C-1 BOX CULVERTS 5FT. SPAN & OVER
66	BRIDGE EXTENSION	455+70
67	"	461+30
68	"	"
69	"	510+05
70	"	"
71	"	651+90
72-74	CROSS SECTIONS	

TOWNS OF
WILLIAMSTOWN-BROOKFIELD-RANDOLPH Pin # 00R720


BARRE-WHITE RIVER JCT. ROAD
 FROM THE END OF THE CONCRETE PAVEMENT
 IN WILLIAMSTOWN SOUTH 16.828 MILES TO THE
 NORTH END OF FAP 80-B
 LENGTH OF PROJECT 88356.2 FT. = 16.828 MILES

SCALES

PLAN	1 INCH = 50 FEET
PROFILE HORIZONTAL	1 " = 50 "
VERTICAL	1 " = 10 "
CROSS SECTIONS	1 " = 5 "

Project No. F129C/80-L
 Date: 4/16/32

RIGHT-OF-WAY DIVISION
 TOWN FILE
 PERPETUAL
 Town of VT 14
 (To Be Returned To R.O.W. Division)

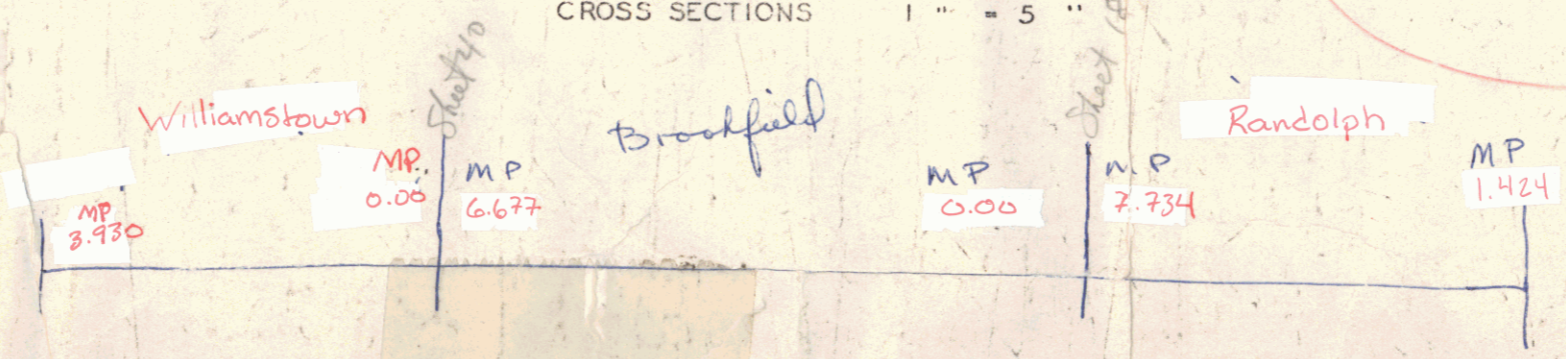

Randolph
 MM ~~0100~~ ~~0100~~

Checked by	
Designed by	
Drawn by	
Typed by	
Checked by	