

CABLE GUARD RAIL REQUIRED

STATIONS	LT.	RT.	CONSTANT	RAIL LENGTH
305+00-306+00	40	184	40	184
305+20-308+00	RT.	276	40	316

WOOD GUARD RAIL REQUIRED



CLAY STATION	LT.	RT.
297+53	24'	24'
299+39	24'	24'

VIEW BEING CONSIDERED FOR CONCRETE RETAINING WALLS

STATION	CHINA	LENS	CONC. B	CONC. C	STEEL
297+25	18"	4"	7.2 CY	8.5 CY	100 lbs
299+30	18"	4"	7.2 CY	8.5 CY	100 lbs
Chelsea Rd	16"	3L	2.0 CY	1.5 CY	120 lbs

STATE	YEAR	SHEET NO.	TOTAL SHEETS
VT.	1880	131	141

Parcel	Kind of Instrument	Date of Instrument	Grantor	Grantee	Ac. Contained	W/Grantee	Remarks
A	G.C.D.	8-18-31	J.E. & N. Martin	St. of H.	30	409	8-24-31
A'	"	8-18-31	R.P. & E.A. Prescott	"	30	25	8-24-31
A''	"	8-18-31	P.M. & L.M. Goodrich	"	30	24	8-24-31
A'''	"	8-18-31	E.E. Burnham	"	30	40	8-24-31

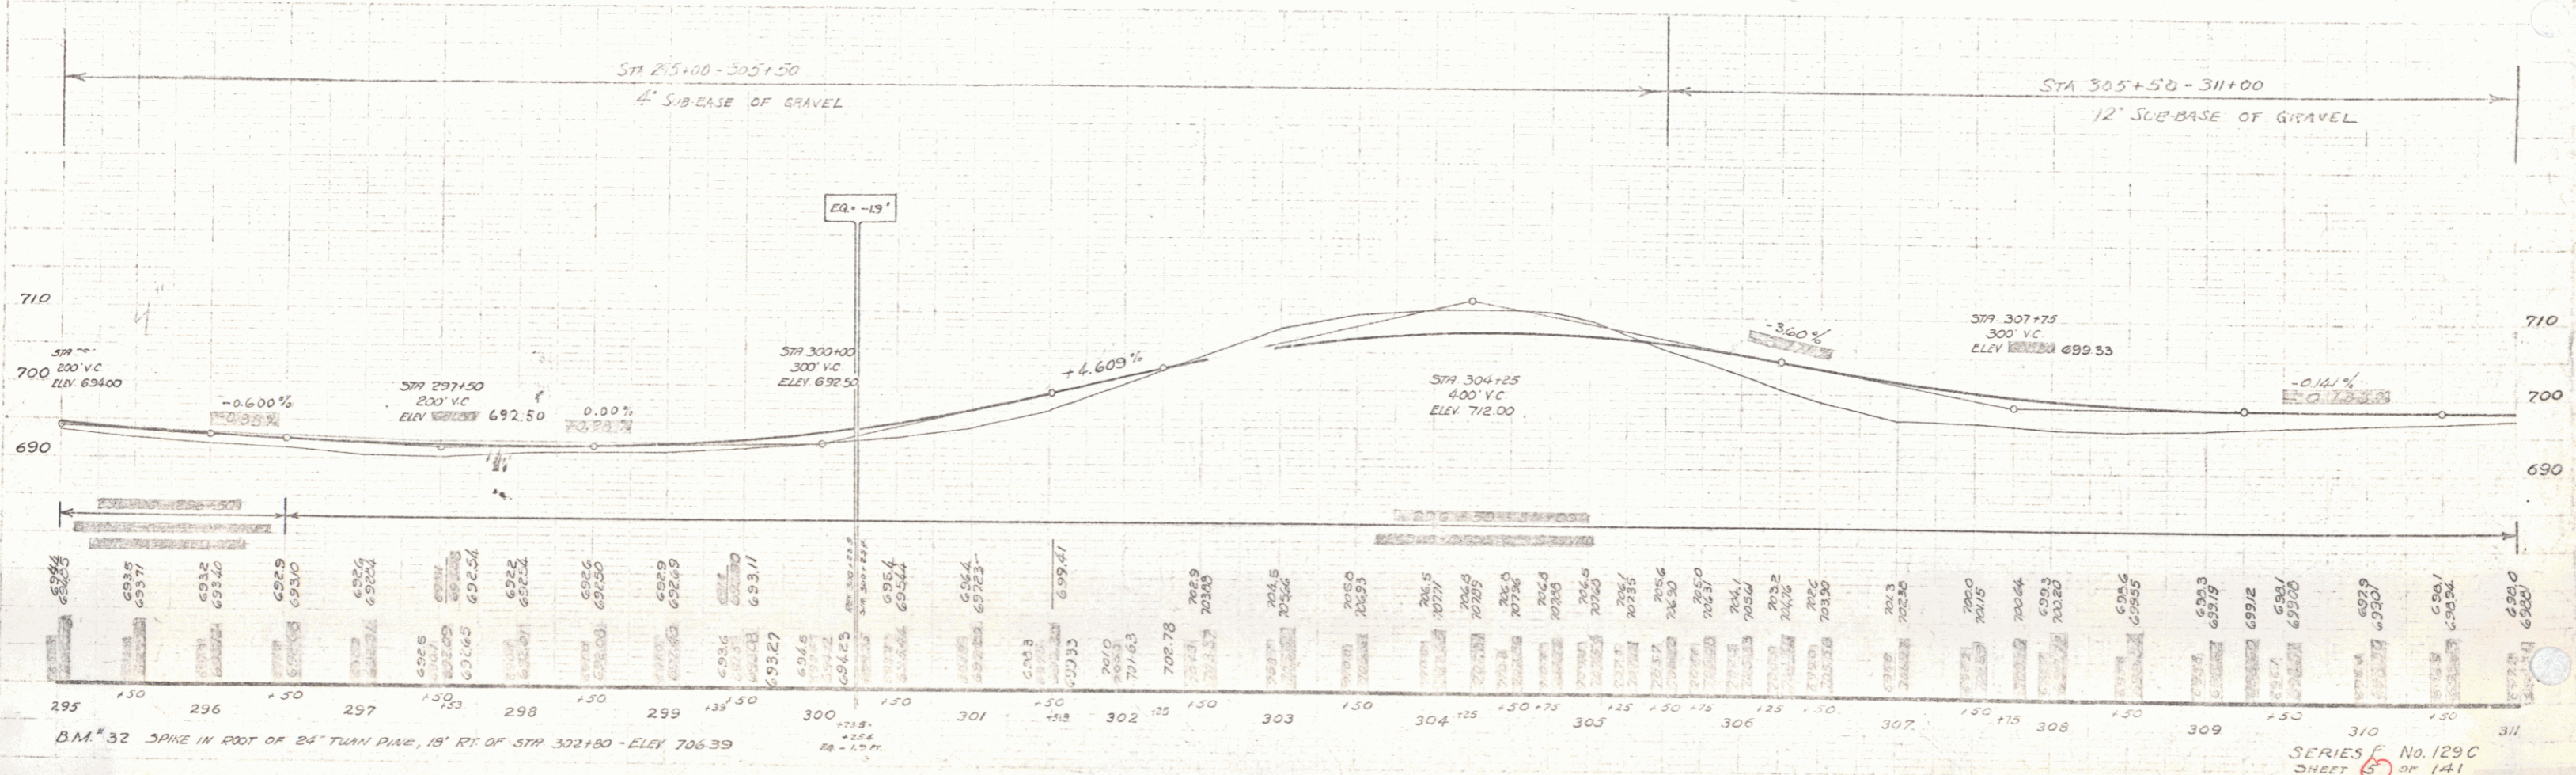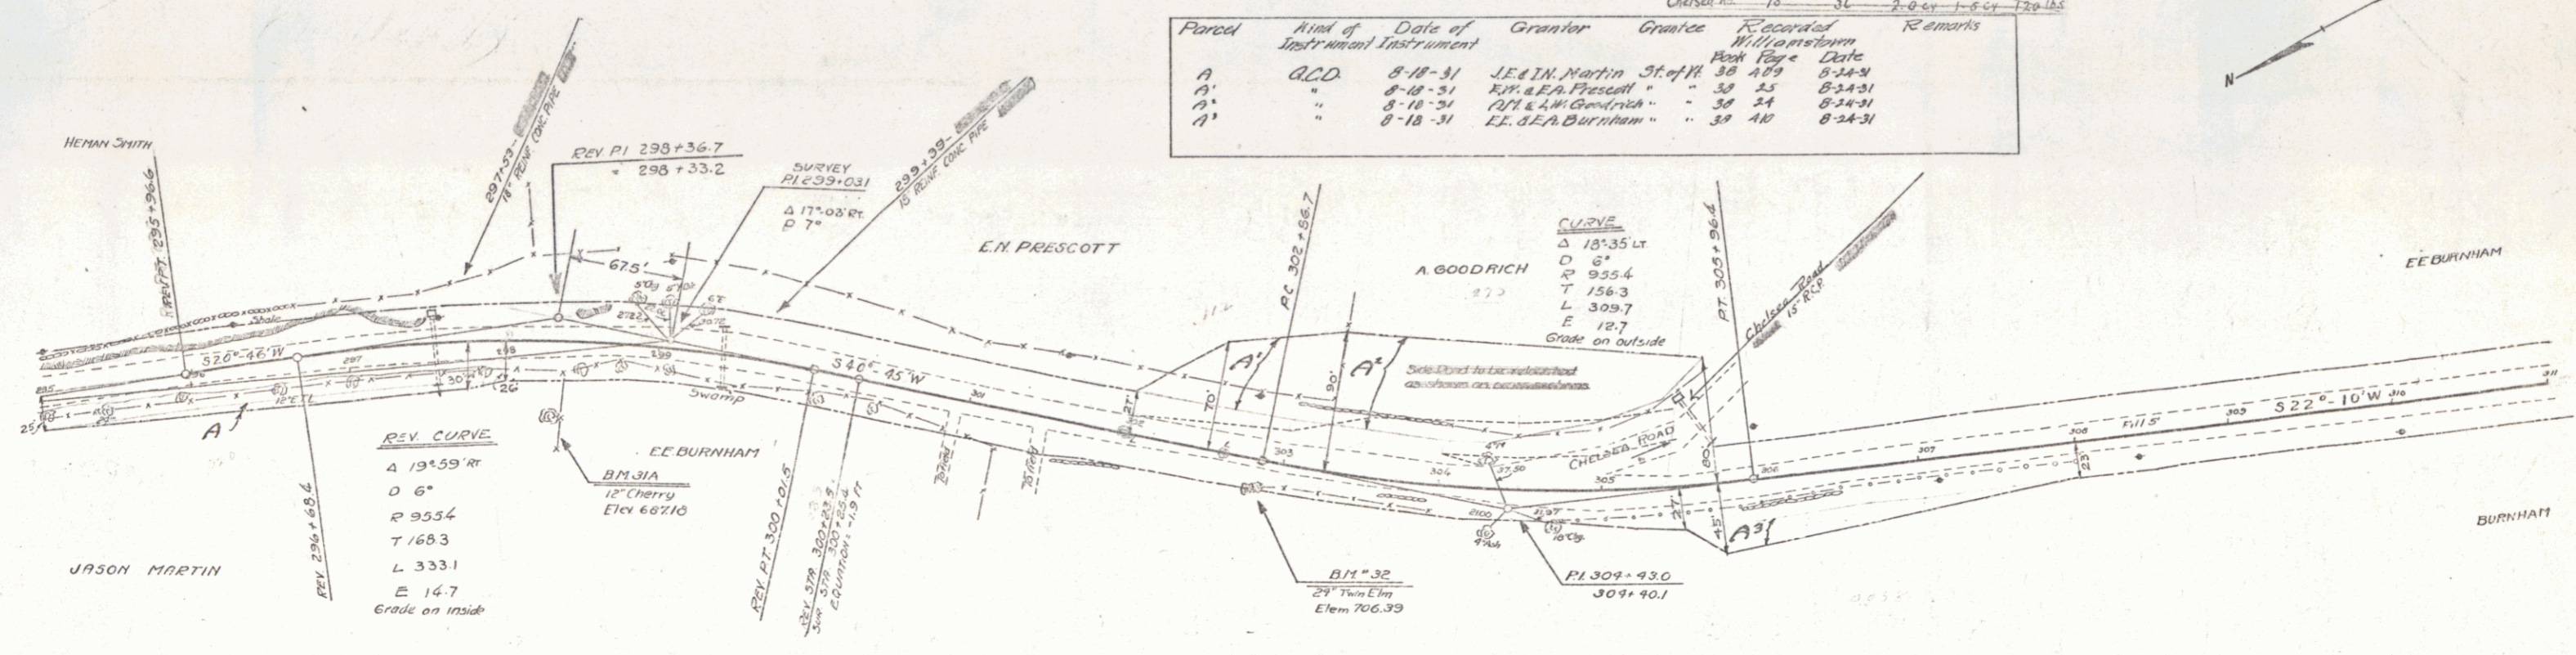

SERIES F No. 129 C
SHEET 5 OF 141