

CABLE GUARD RAIL REQUIRED  
30' BENCH L.V.S. LONG SPAN 7' 1/2"  
44010 44150 R. 410 40' 480"




STATION	DATE	RECORD	REMARKS
441+50	1	Parcel	Kind of Instrument
441+70	1	Parcel	Kind of Instrument
441+85	1	Parcel	Kind of Instrument
441+120	1	Parcel	Kind of Instrument
442+31	1	Parcel	Kind of Instrument

GUIDE POSTS REQUIRED

STATION	DATE	RECORD	REMARKS
441+50	1	Parcel	Kind of Instrument
441+70	1	Parcel	Kind of Instrument
441+85	1	Parcel	Kind of Instrument
441+120	1	Parcel	Kind of Instrument
442+31	1	Parcel	Kind of Instrument

RECORDING DATA

STATION	DATE	RECORD	REMARKS
441+65	10	44	1.5 1.2 10.9
441+85	15	54	1.5 1.2 5.6
441+125	10	55	1.5 1.2 1.74
442+31	10	56	1.5 1.2 1.74

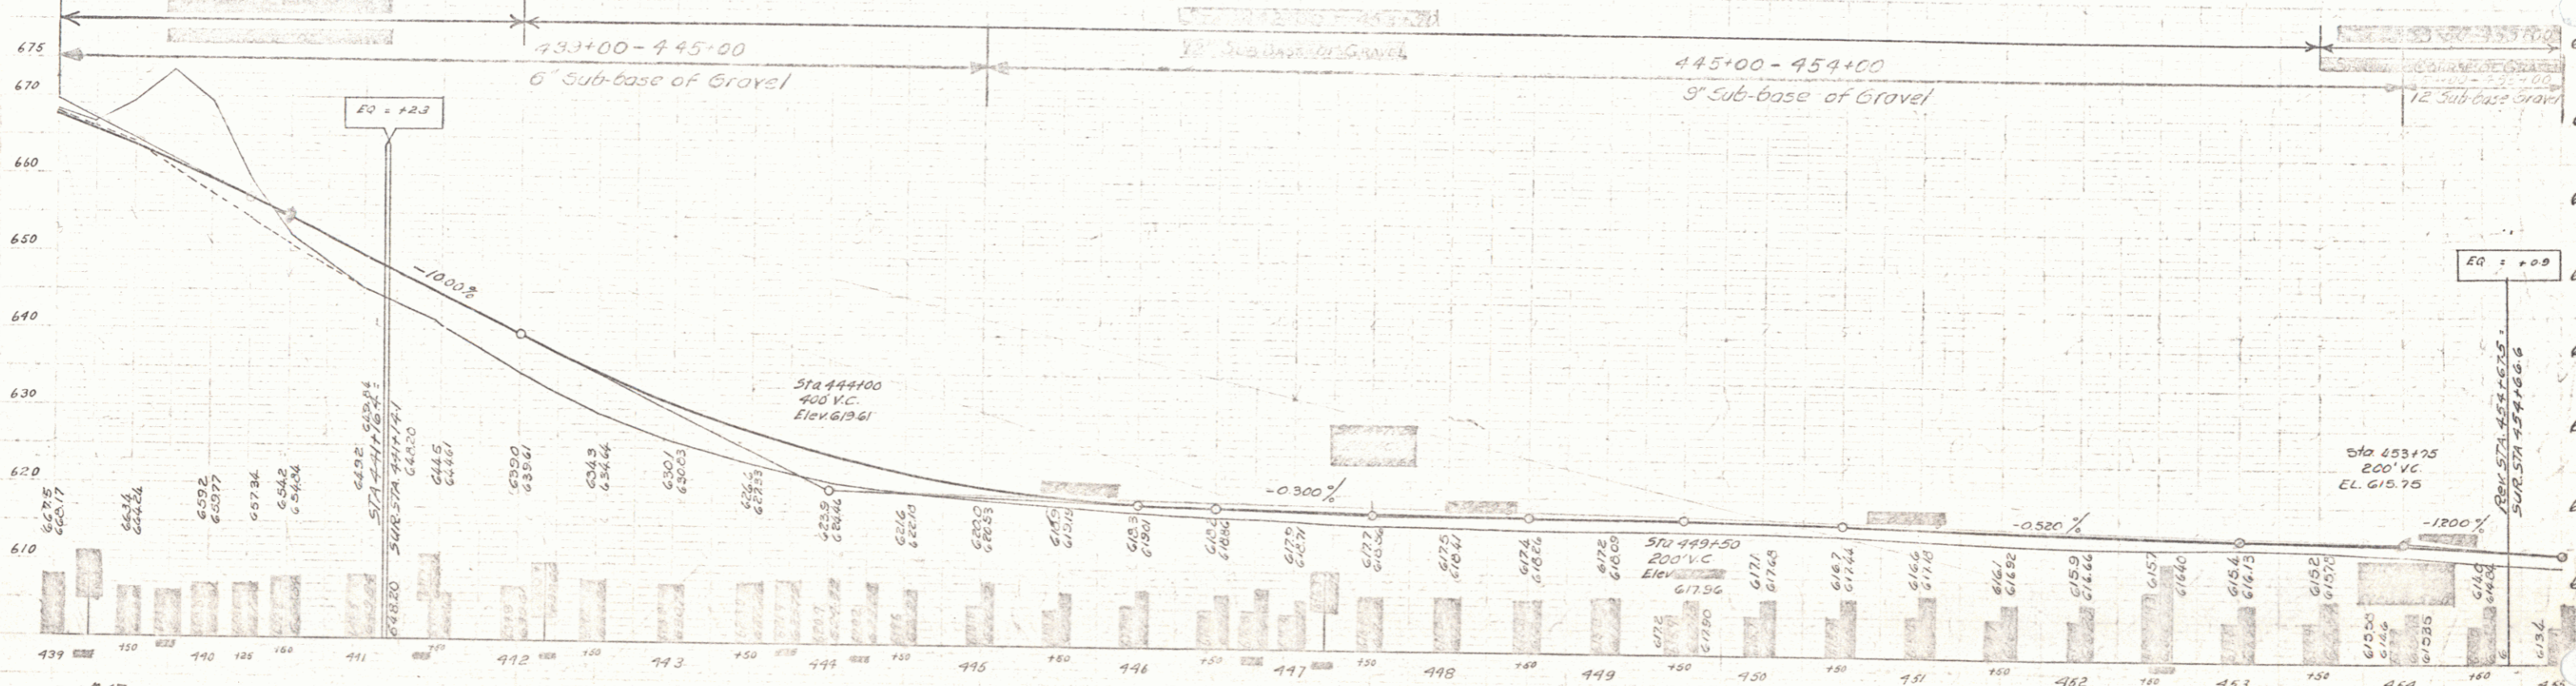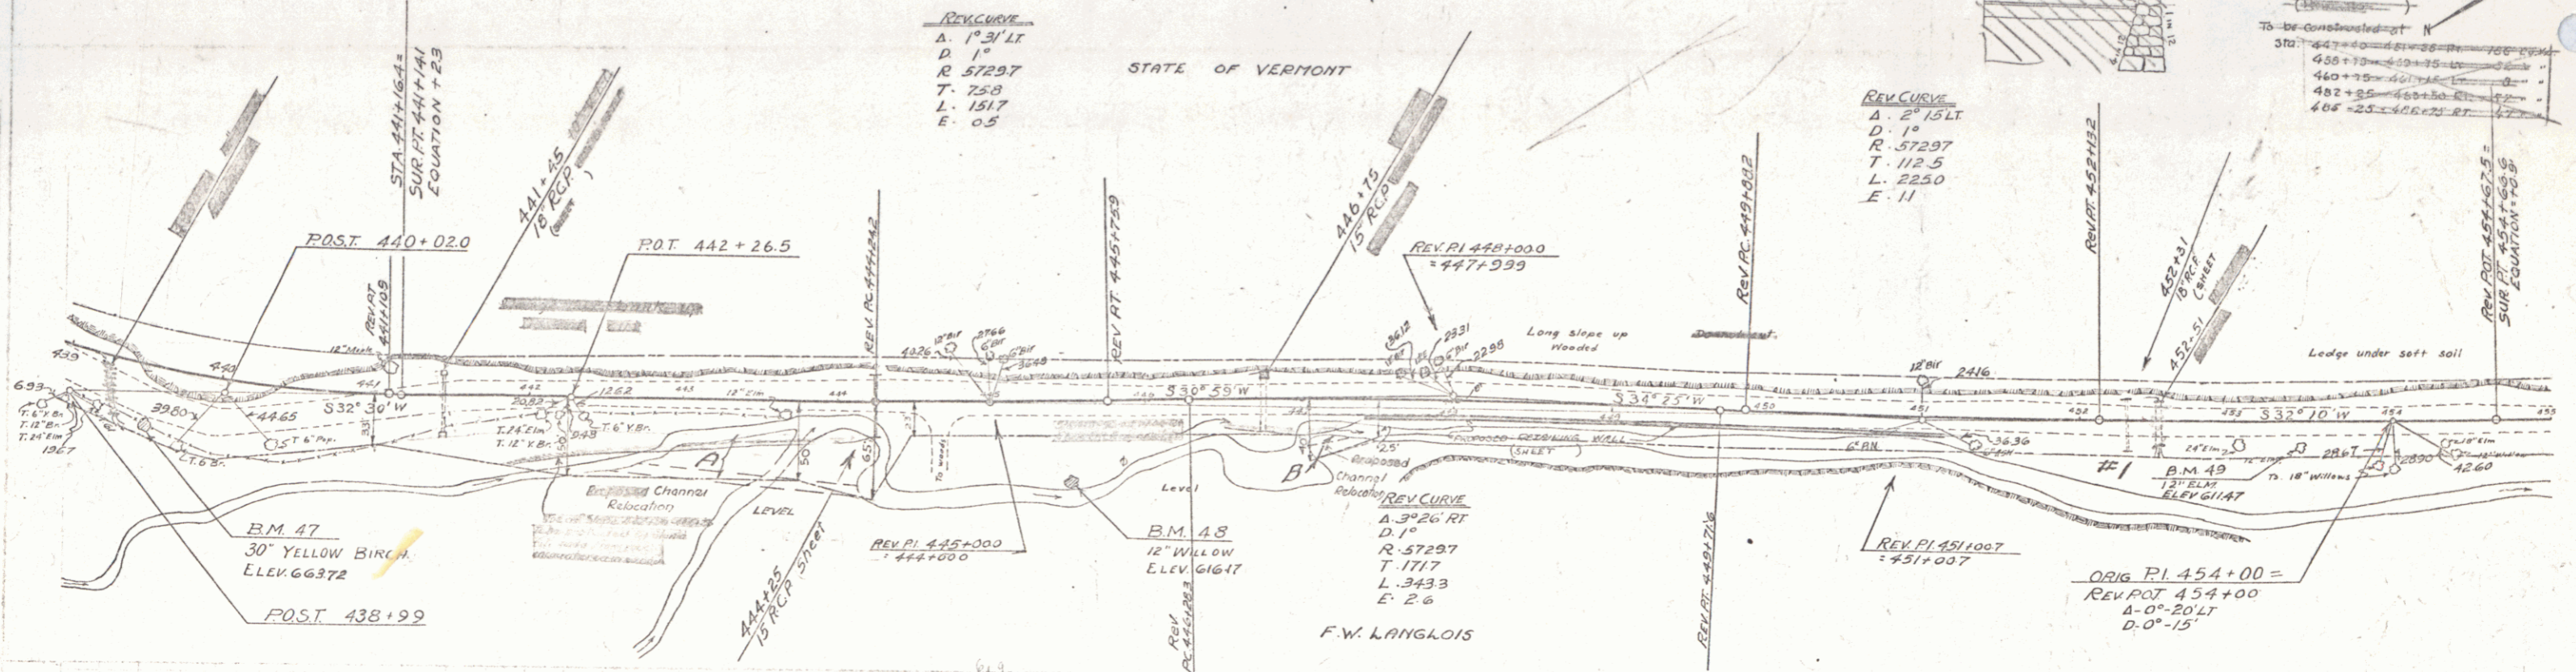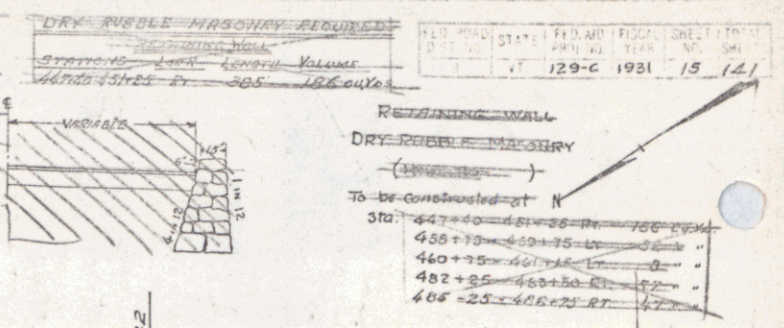

B.M. # 47 SPIKE IN CROTCH OF 30" Y. BIRCH, 38' RT OF STA. 439+55, ELEV. 663.72  
 B.M. # 48 SPIKE IN ROOT OF 12" WILLOW 49 RT OF STA. 445+50, ELEV. 616.17  
 B.M. # 49 SPIKE IN ROOT OF 12" ELM. 14 RT OF STA. 453+42, ELEV. 611.47

SERIES F. No. 129-C  
SHEET 15 OF 141

14