


CHUCK POSTS REQUIRED	CHUCK SECTION	LT	RP
470+25	1	1	
480+00	1	1	
472+14	1	1	
471+52	1	1	
474+30	1	1	
477+22	1	1	
480+13	1	1	
482+25	1	1	
486+25	1	1	


NEW RIGHT HAND CURVE DATA	NEW LEFT HAND CURVE DATA			
STATION	CHUCK	DATE	TYPE	REMARKS
472+44	10	02	3.0	3.3
474+30	10	02	3.0	3.3
477+22	10	02	3.0	3.3
480+13	10	02	3.0	3.3
482+25	10	02	3.0	3.3
486+25	10	02	3.0	3.3

NEW RIGHT HAND CURVE DATA	NEW LEFT HAND CURVE DATA			
STATION	CHUCK	DATE	TYPE	REMARKS
472+44	10	02	3.0	3.3
474+30	10	02	3.0	3.3
477+22	10	02	3.0	3.3
480+13	10	02	3.0	3.3
482+25	10	02	3.0	3.3
486+25	10	02	3.0	3.3

STATE OF VERMONT
 DIST. 9
 Vt. 129-C 1937 17 141

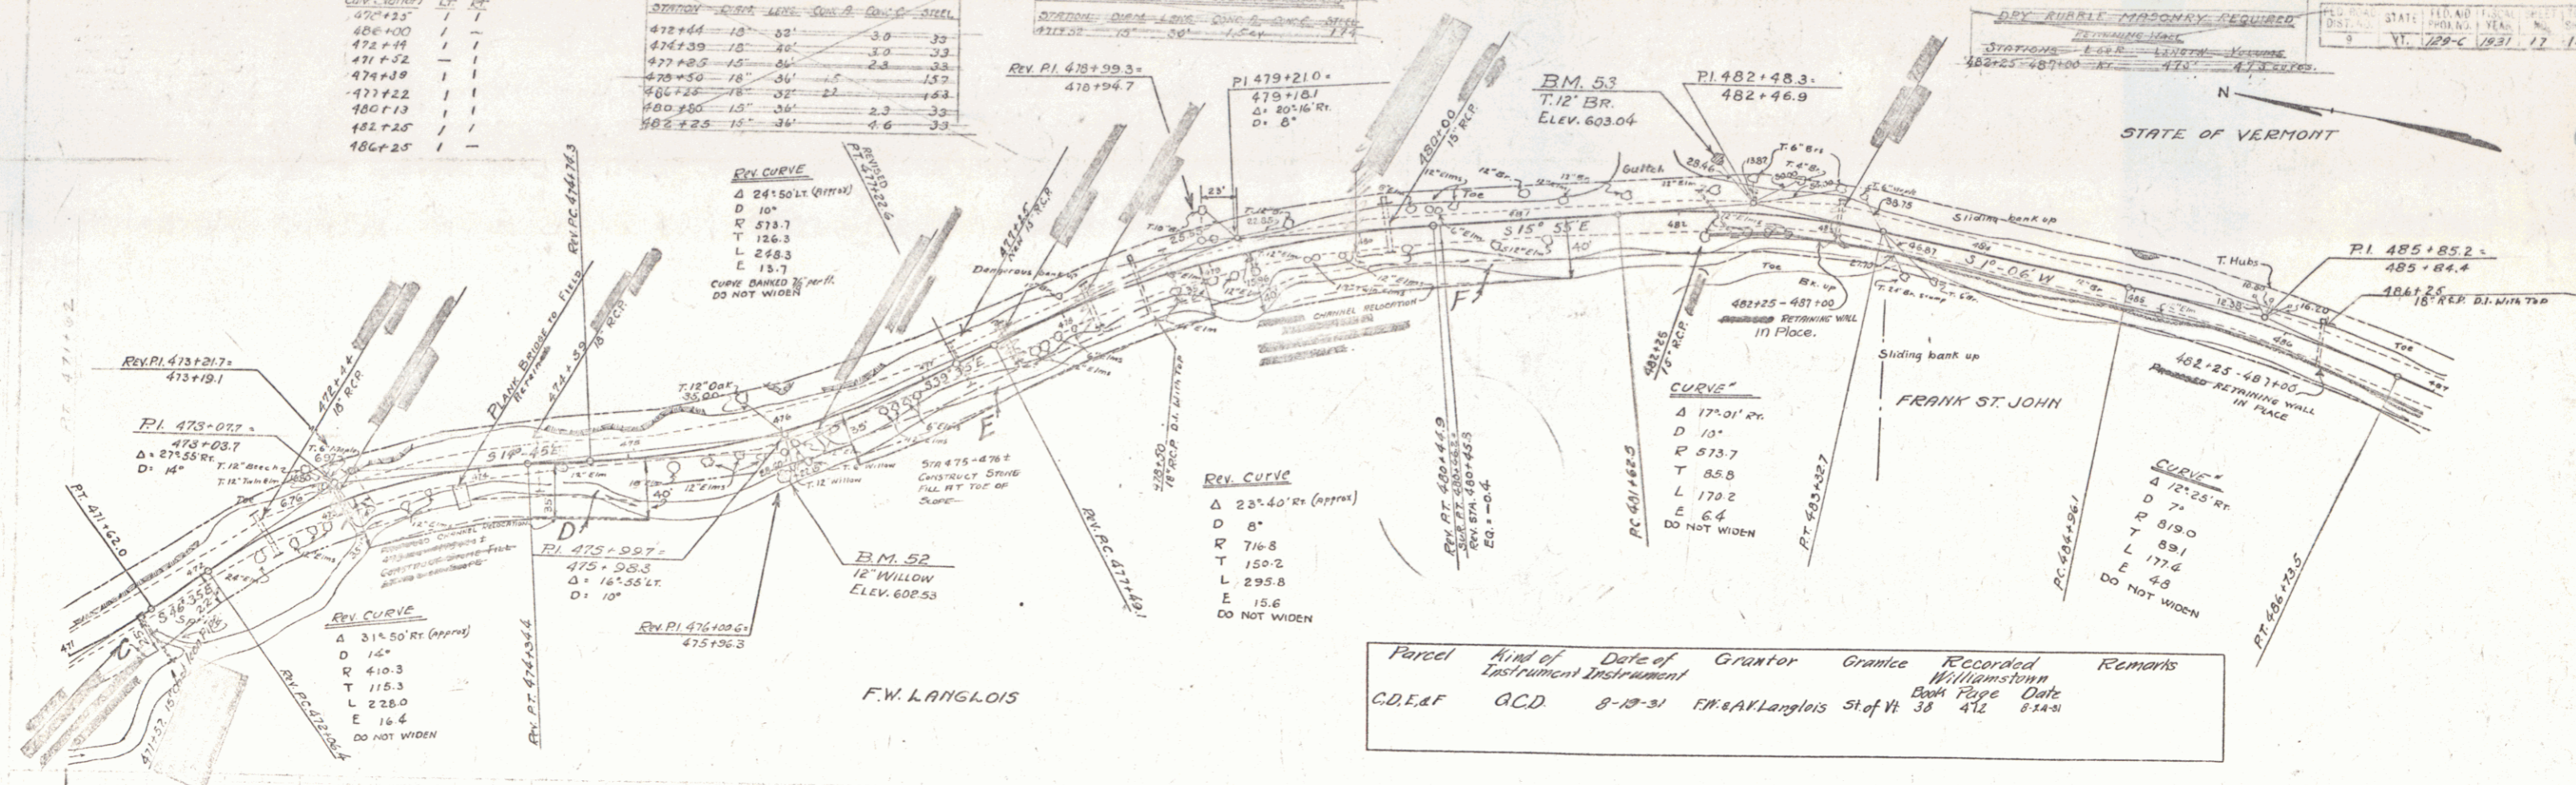

Parcel	Kind of Instrument	Date of Instrument	Grantor	Grantee	Recorded	Remarks
G.D.E.F	G.C.D.	8-10-31	F.W. Langlois	St of Vt	38 412	8-14-31

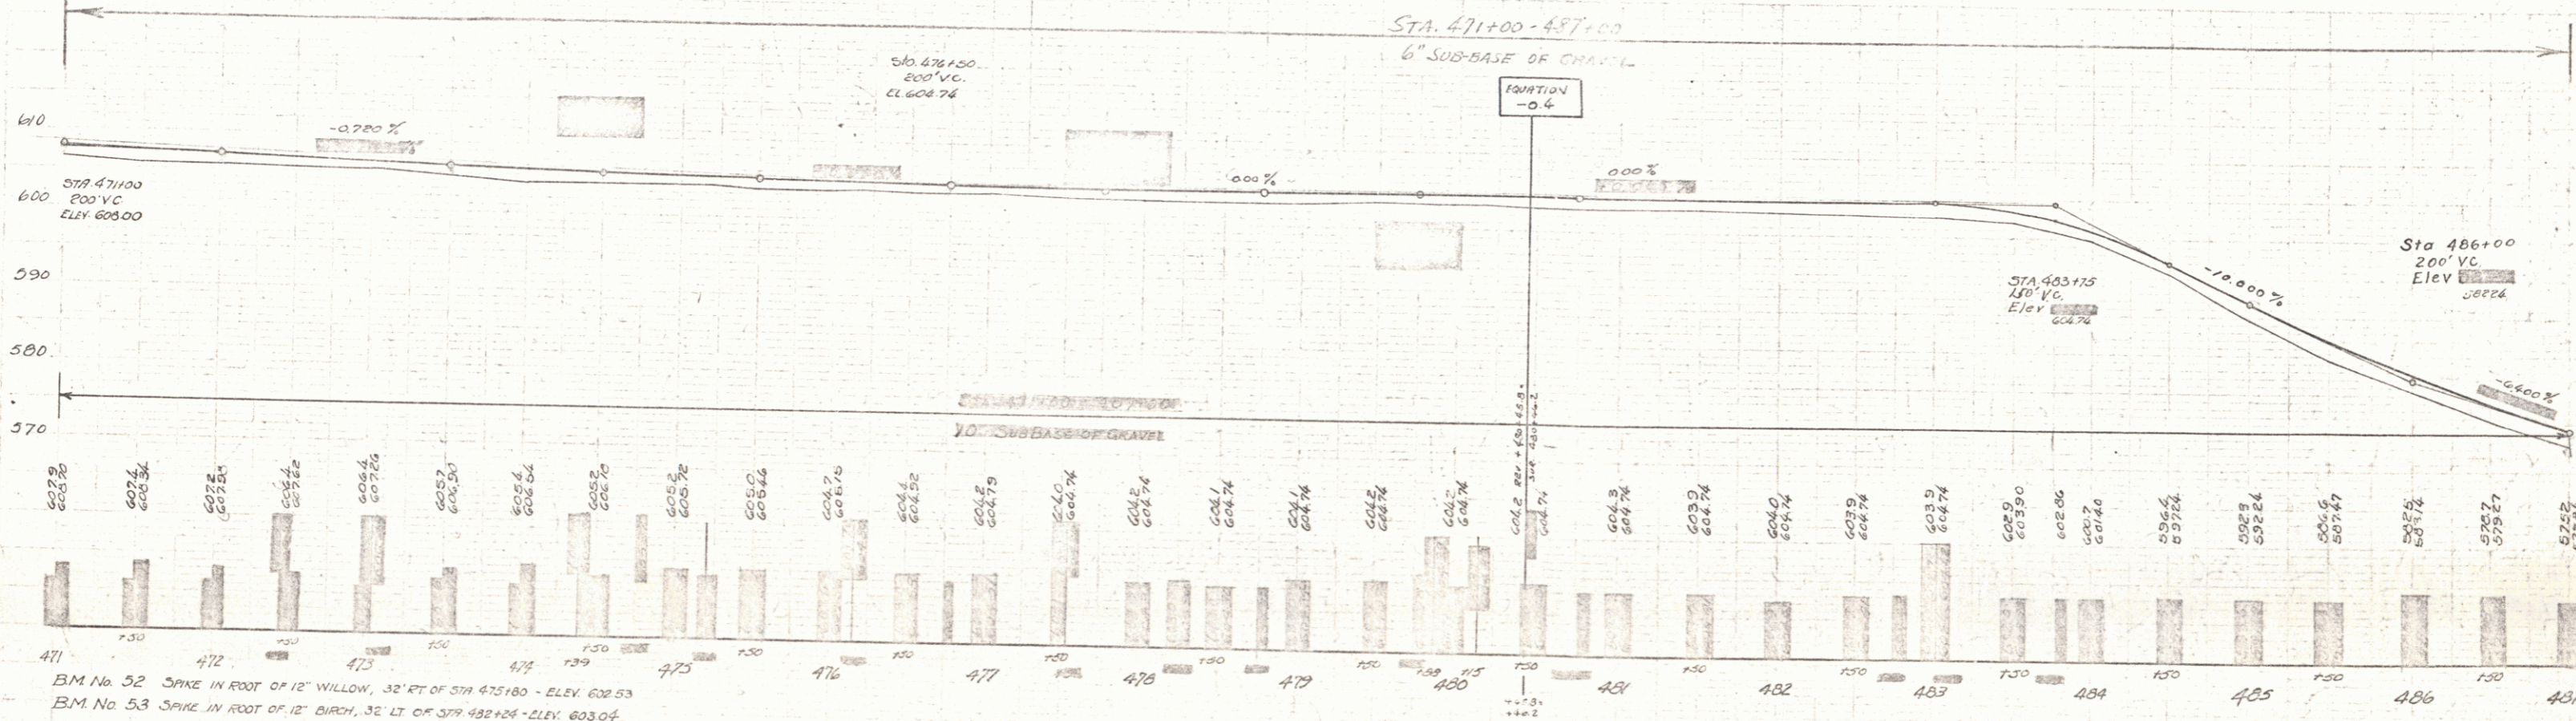

BM No. 52 SPIKE IN ROOT OF 12\" WILLOW, 30' RT OF STA 475+100 - ELEV. 602.53
 BM No. 53 SPIKE IN ROOT OF 12\" BIRCH, 32' LT OF STA 482+100 - ELEV. 603.04

SERIES F No 129C
 SHEET 17 OF 141