

CABLE GUARD RAIL REQUIRED

Sta	Loc	Length	Constant	By	Length
567+00	577+33	4' 33"	40'	10.73	
577+30	578+86	4' 56"	40'	17.6	


GUIDE POSTS REQUIRED

Sta	Loc	Length	Constant	By	Length
570+00					
573+20					
577+32					

REQUIREMENTS

Item	Quantity	Notes
STEEL	1	
WOOD	1	
CONCRETE	1	

Parcel	Kind of Instrument	Date of Instrument	Grantor	Grantee	Recorded Book Page Date	Remarks
B:5'40'	GCD	3-3-31	A. Dan Reed	Shelby	16 548-3 11-4-31	
A:8'	"	3-3-31	O. C. Hanson	"	16 548-7 11-4-31	

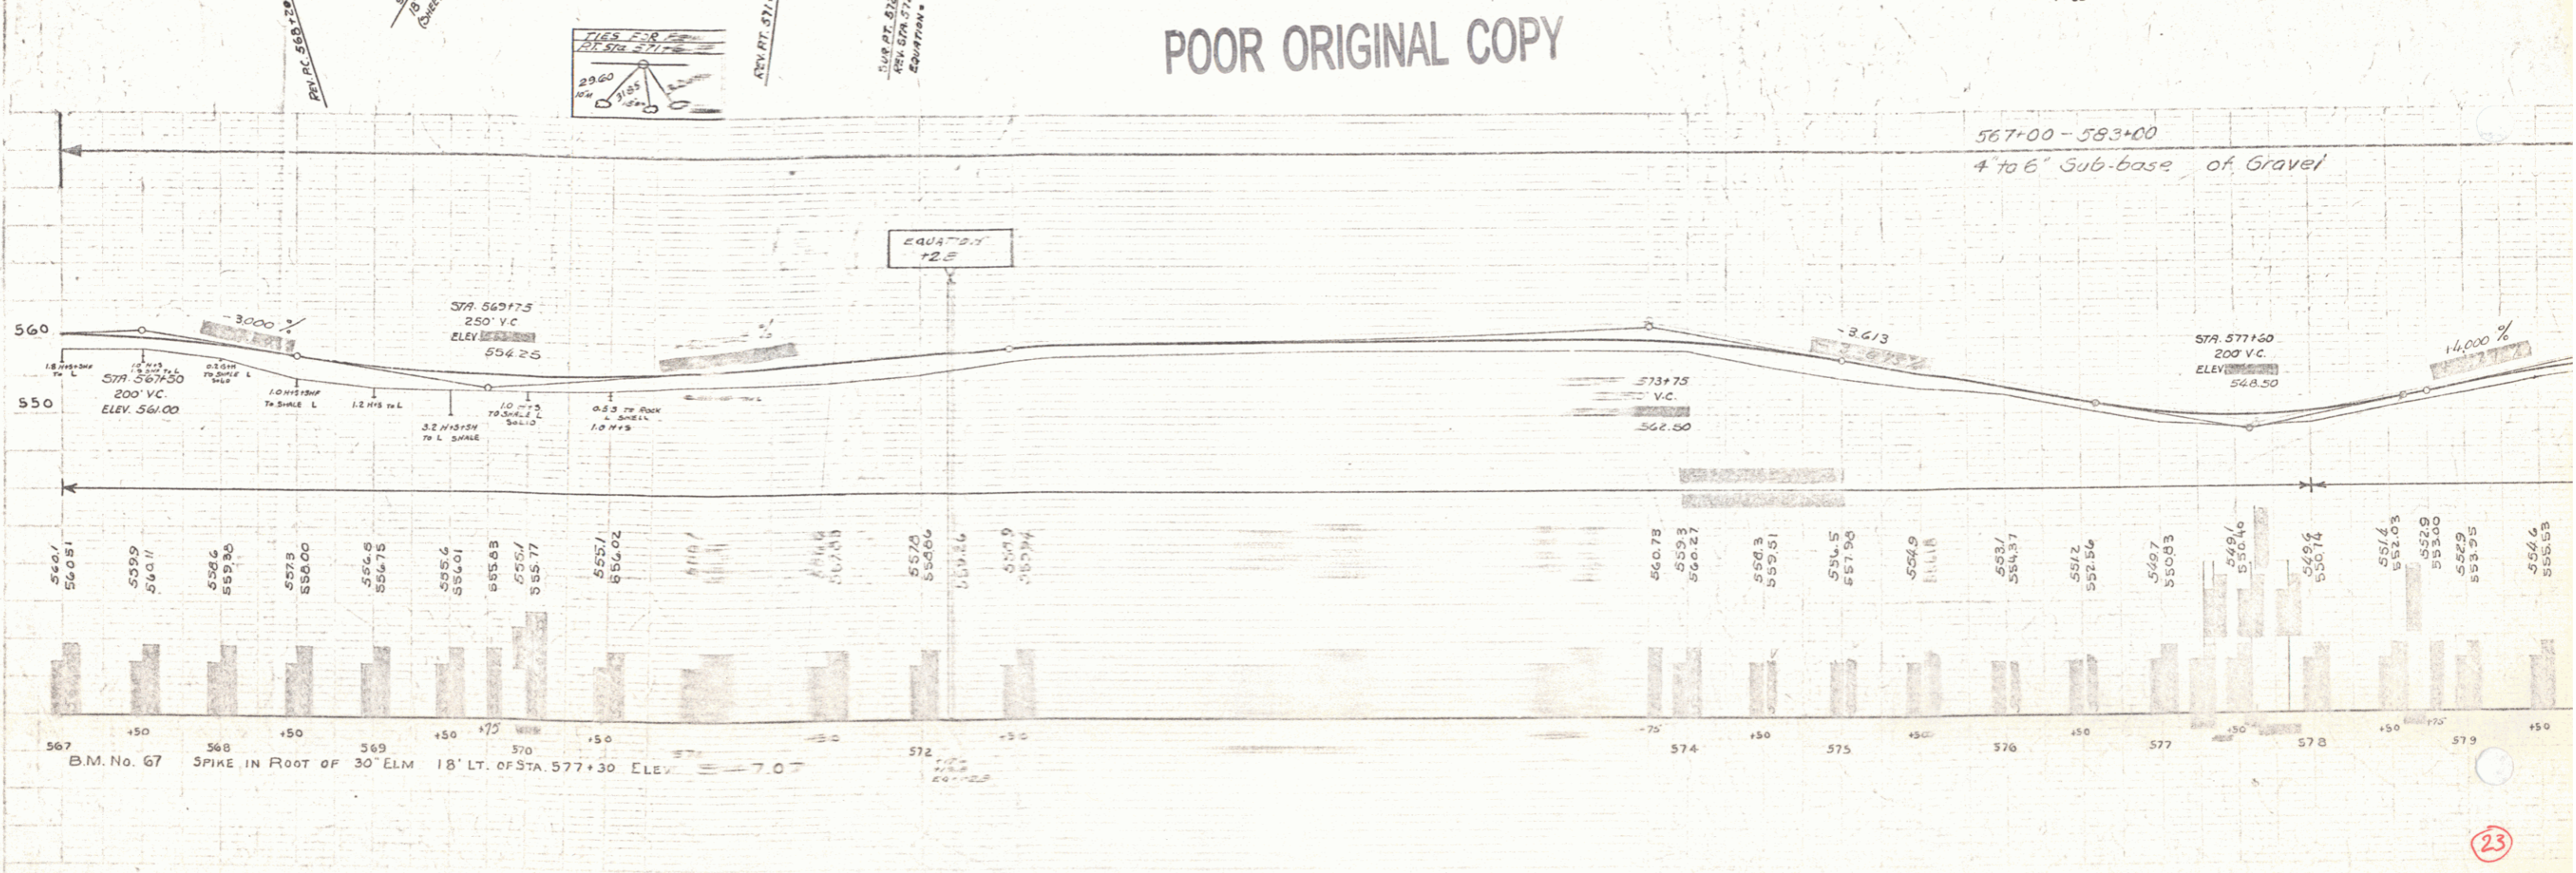

23