

GUIDE PIST OF HWY REQUIRED  
 City Station 12  
 613HC



NEW EXHAUST PIPE REPAIRS REQUIRED  
 STATION DIST. LENS CORR. DIST. STATION  
 612+4 15 32 11.41 612.31 127

FED. ROAD DIST. NO. STATE PROJ. NO. YEAR NO. SHEET  
 9 21 2 9-C 2937 26 127



DATE: 10/1/50  
 DRAWN BY: J.W. HARRISON  
 CHECKED BY: J.W. HARRISON

DATE: 10/1/50  
 DRAWN BY: J.W. HARRISON  
 CHECKED BY: J.W. HARRISON

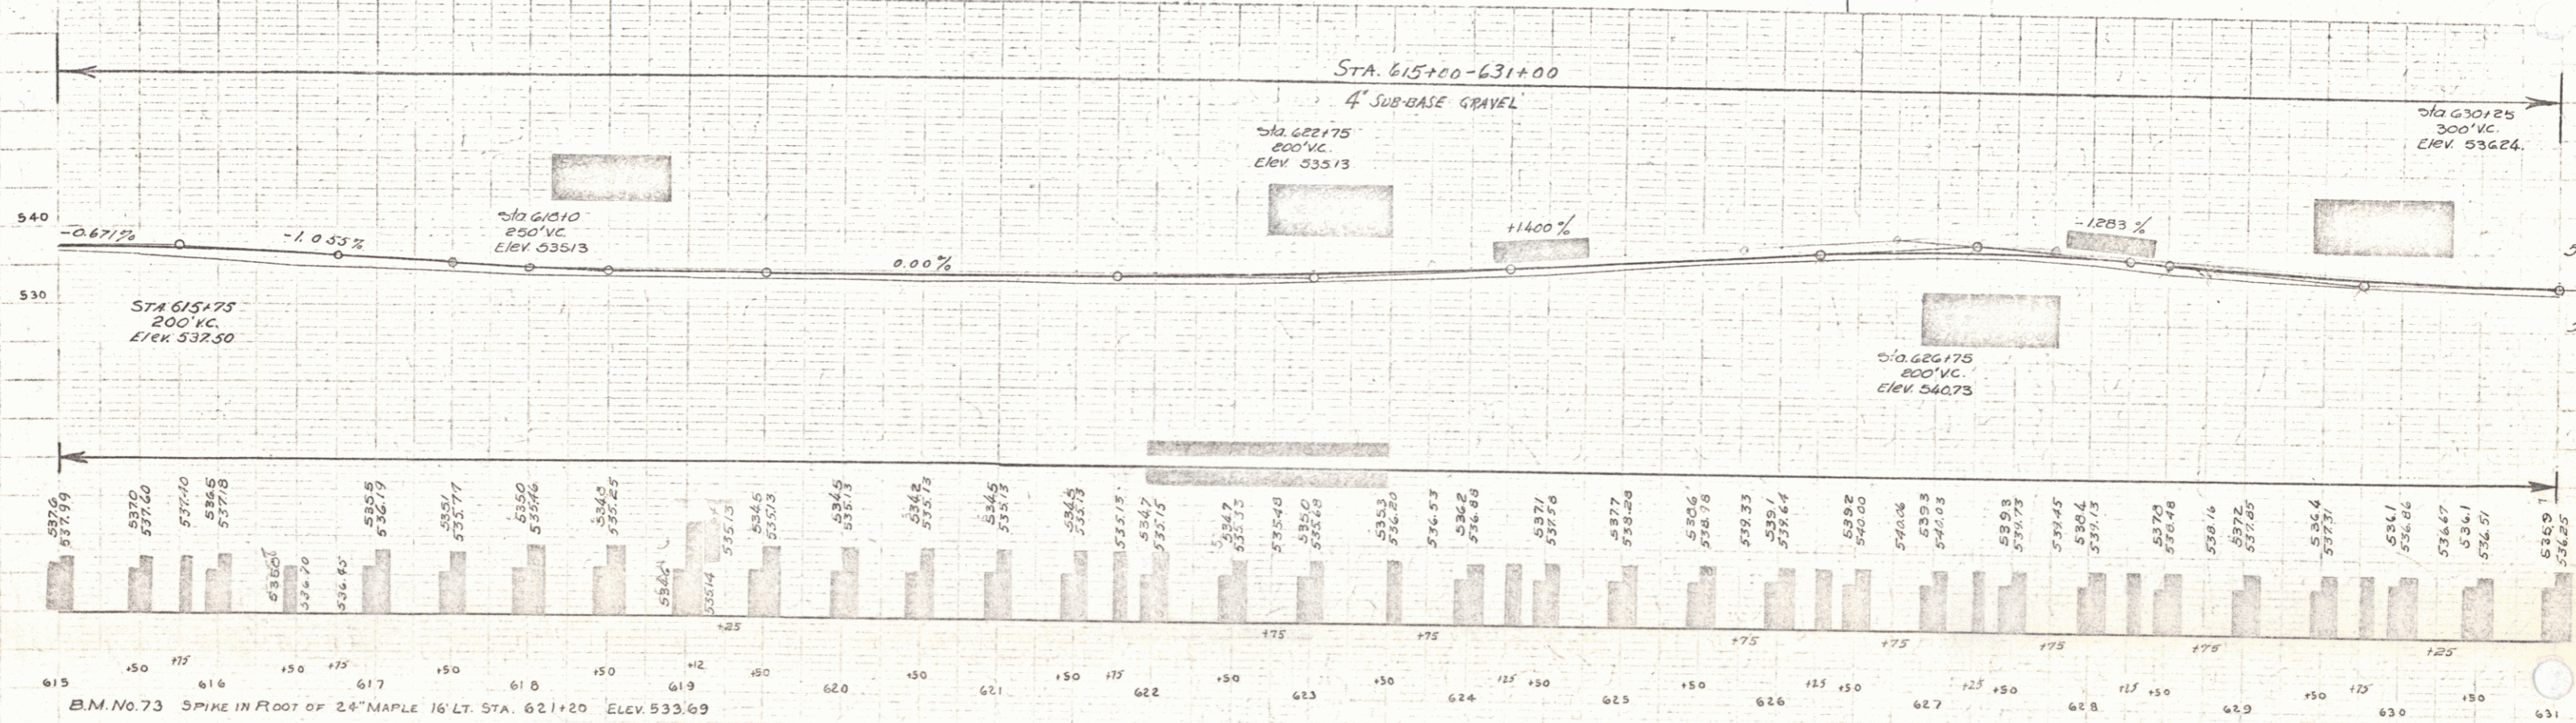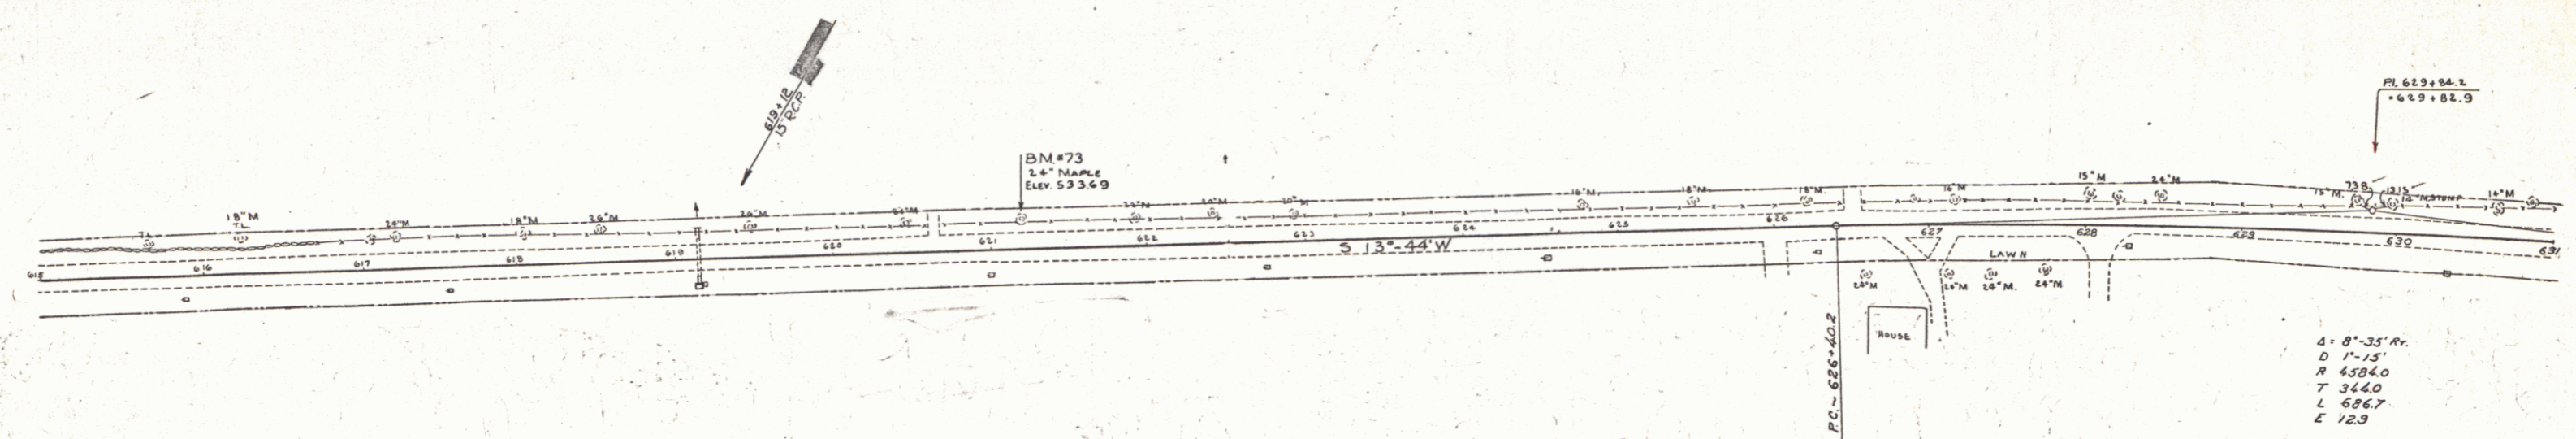

SERIES F No 129-C  
 SHEET 26 OF 141