
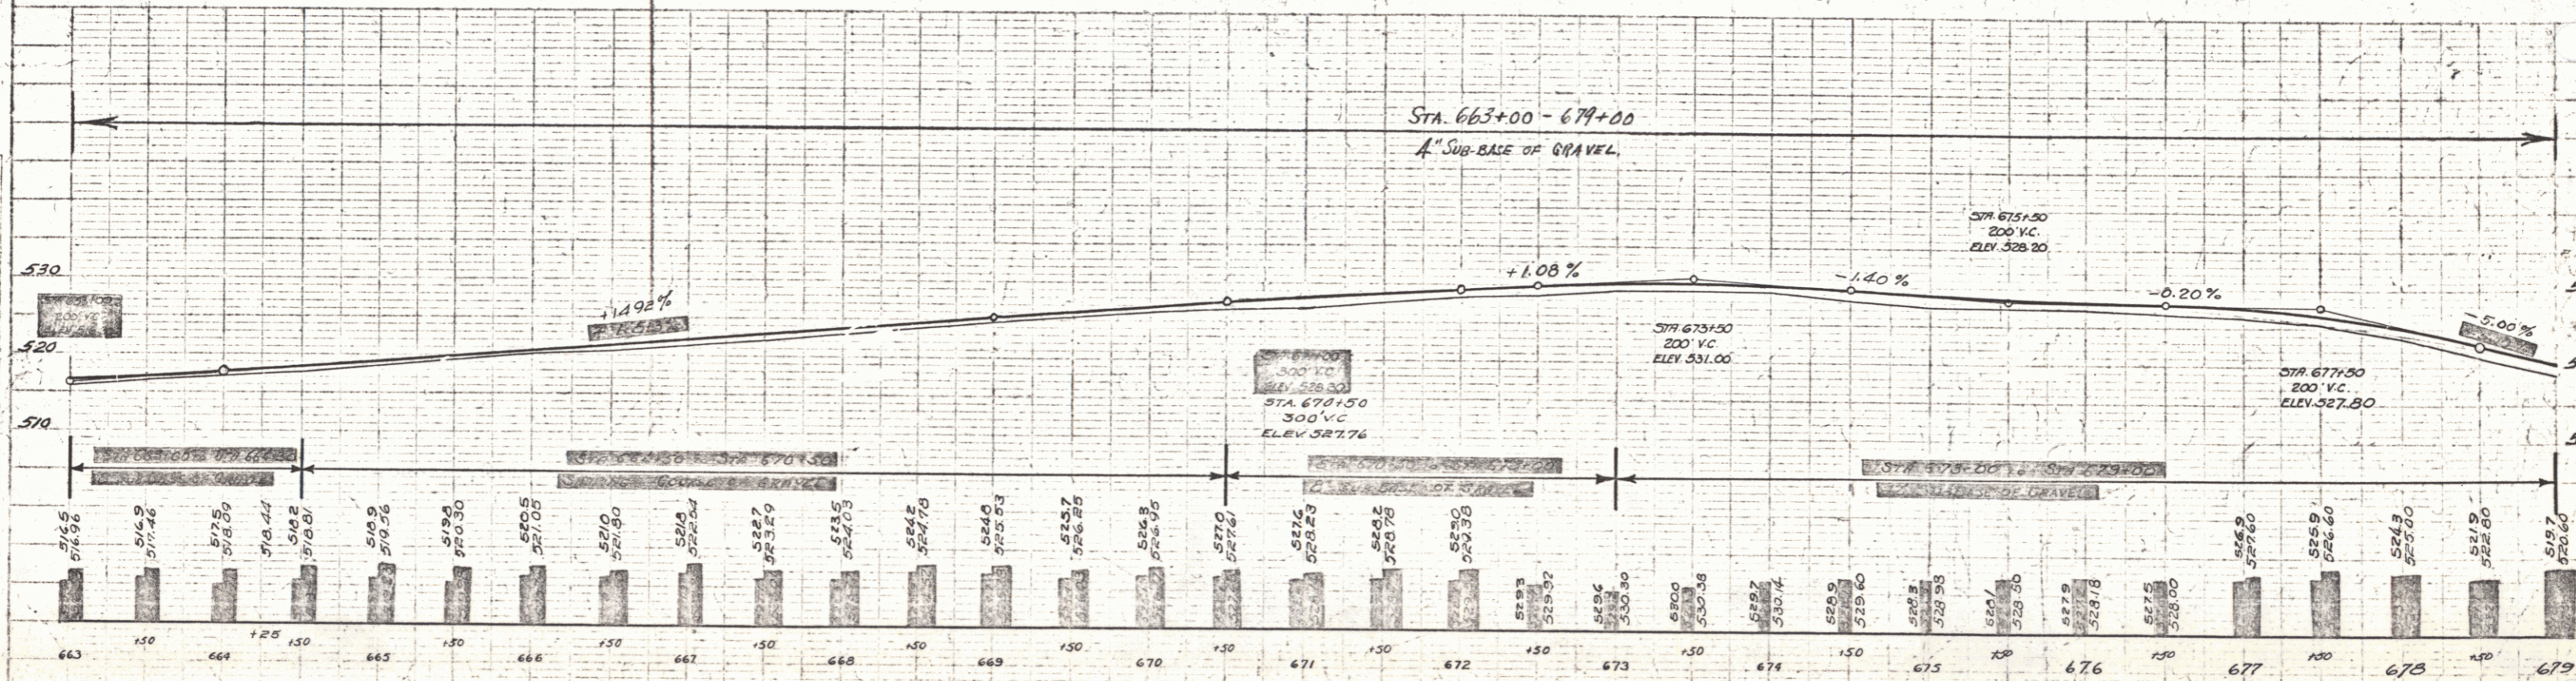


PLAN
 DATE 12/1/31
 DRAWN BY J. W. WILSON
 CHECKED BY J. W. WILSON

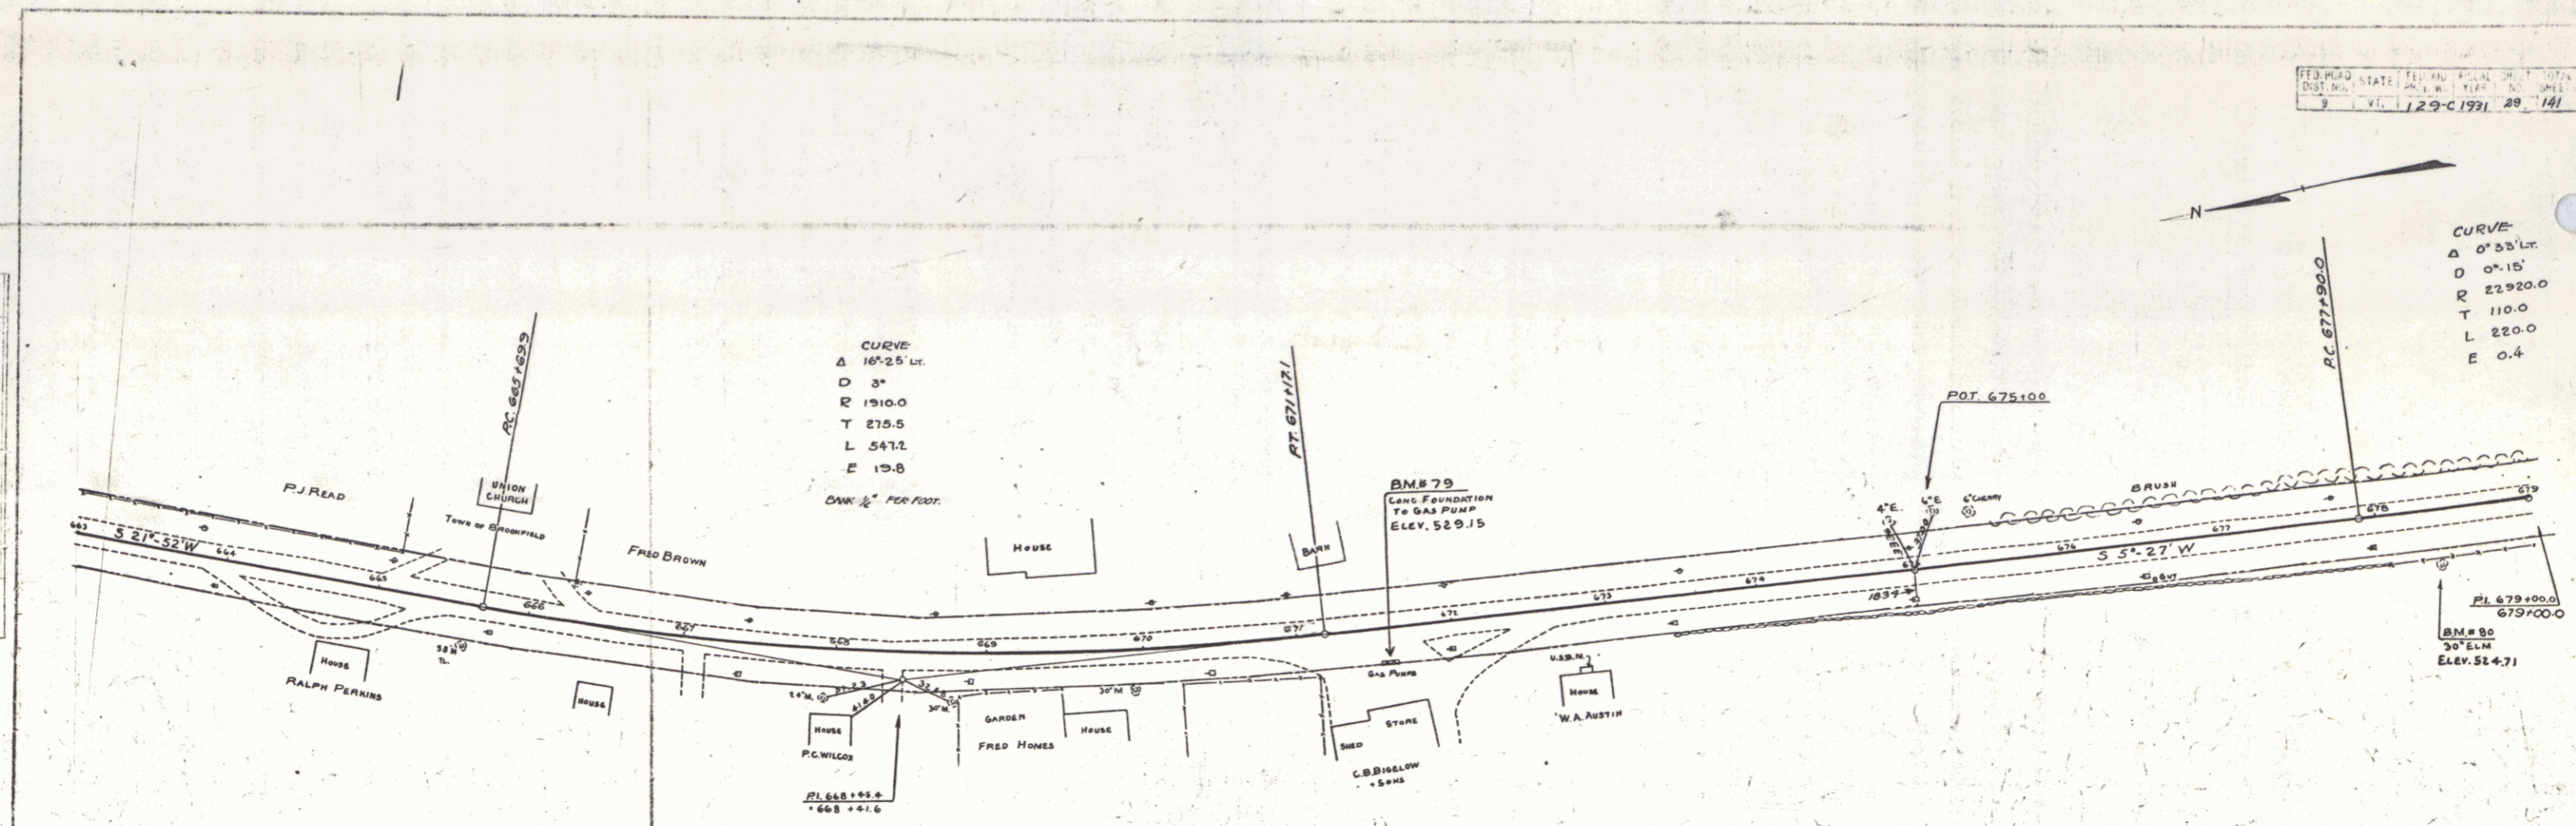

B.M. No. 79 SPOT ON CONC. FOUND. OF GULF GAS PUMP 22' RT. STA. 671+51 ELEV. 529.15
 B.M. No. 80 SPIKE IN FOOT OF 30" ELM. 32' RT. STA. 678+37 ELEV. 524.71