



WOOD GUARD RAIL REQUIRED		CABLE GUARD RAIL REQUIRED		GUIDE POSTS REQUIRED			
Curv. Station	LT	Sta - Sta	Loc. L	Loc. R	Curv. Station	LT	RT
710+20	28'	712+96-713+14	48'	40'	710+00	1	
725+12		719+44-719+92	48'	48'	725+12	1	

STATION	DIAM.	LENS	CONC. A	CONC. C	STEEL
715+20	10"	50"	3"	3-4 lbs	
719+05	10"	44"	2 1/2"	1 1/2"	110 lbs
720+12	10"	36"	1 3/4"	1 3/4"	110 lbs

STA TO STA	L OR R	LENGTH
7210 - 72510	LT	405'

VT. ROAD STATE PROJECT NO. 129-C 1931 31 141

Parcel	Kind of Instrument	Date of Instrument	Grantor	Grantee	Recorded Brookfield	Remarks
B	G.C.D.	9-24-31	Calvin Jackson Est. St. of H.		26 500-1 11-A-31	

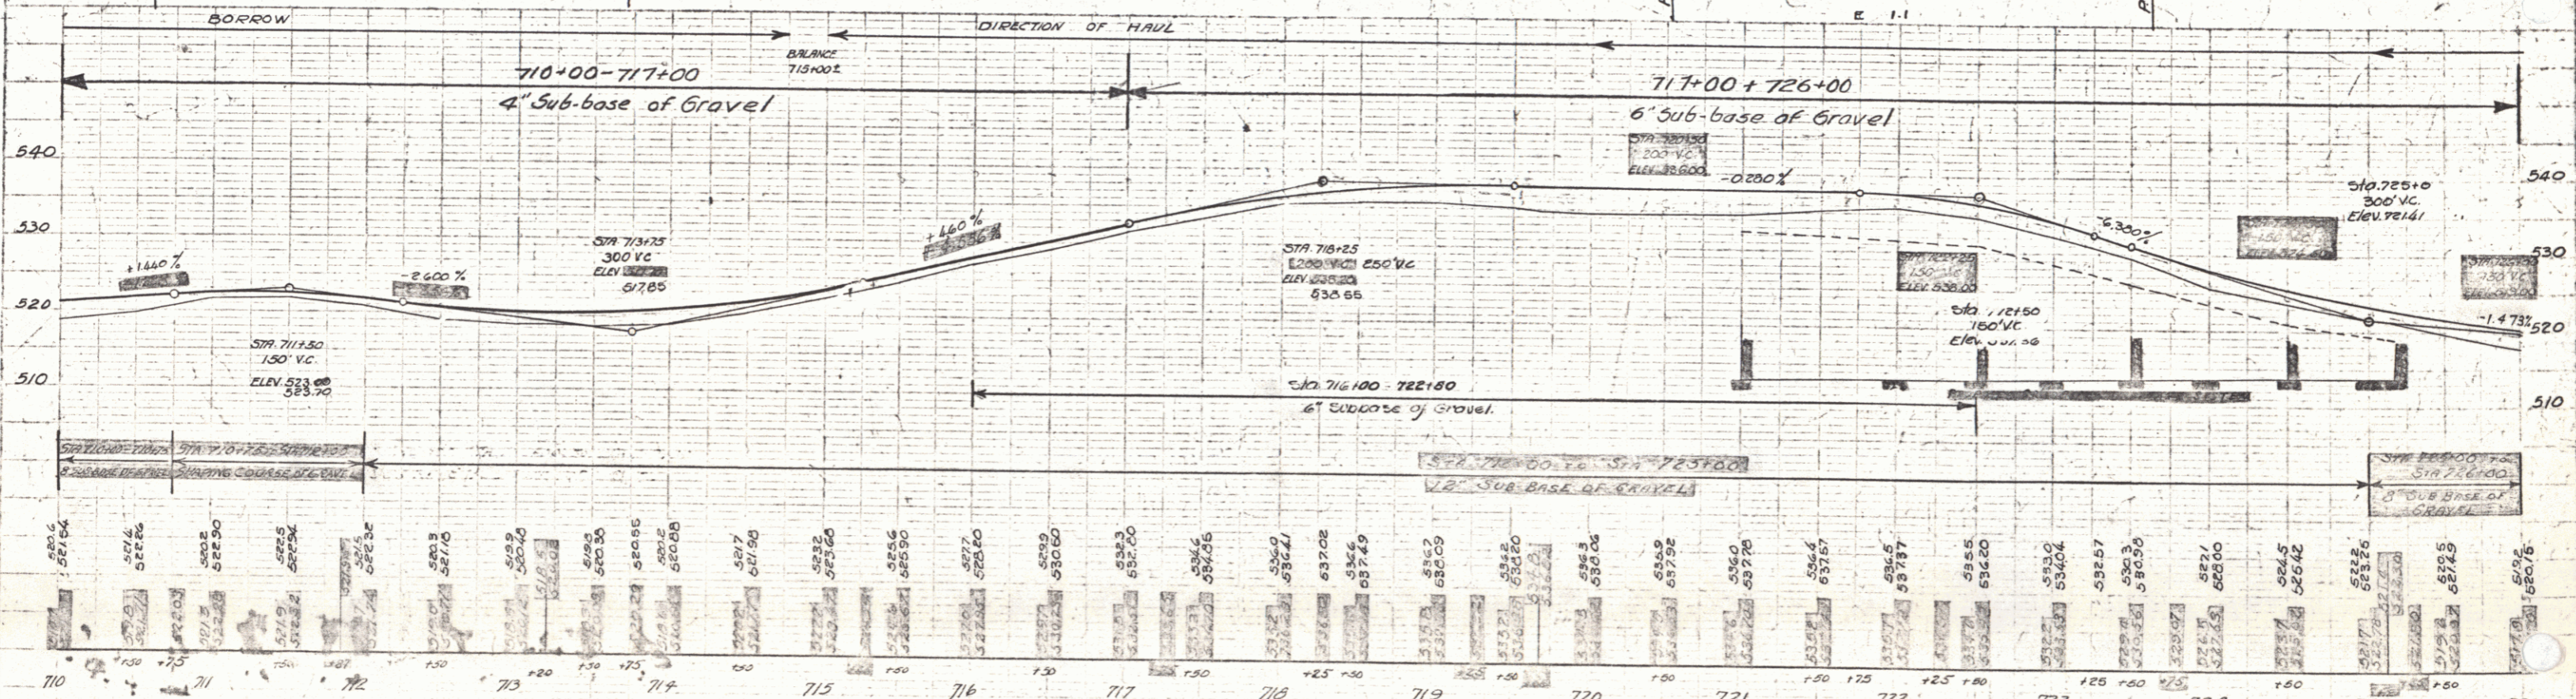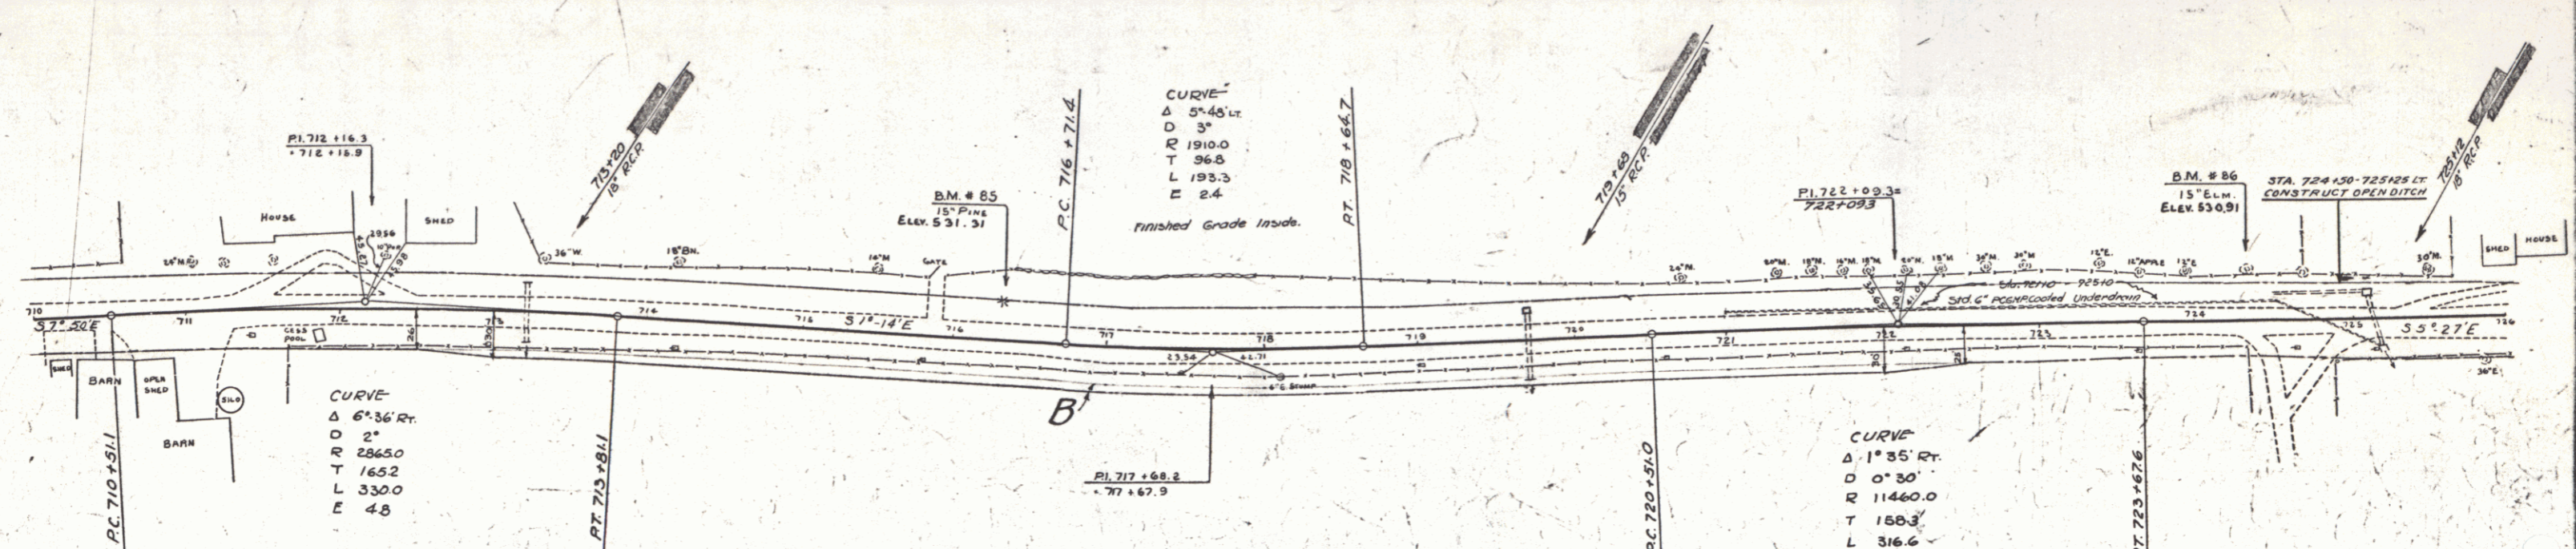

B.M. No. 85 SPIKE IN ROOT OF 15" PINE 23' LT. STA. 716+30 ELEV. 531.31
 B.M. No. 86 SPIKE IN ROOT OF 15" ELM 30' LT. STA. 724+33 ELEV. 530.91

SERIES F No. 129-C
 SHEET 31 OF 141