



GUIDE POSTS OF WOOD REQUIRED
 Curb Station 235+00

NEW 12" DIA. CON. PIPE CHURCH'S ROAD
 3000' DIA. LANE OVER CONCR. STREETS
 732+00 73 28 725' 1.84' 202 1

FED. RD. DIST. NO.	STATE	FUND. YEAR	FISCAL YEAR	SHEET NO.	TOTAL SHEETS
9	Vt.	22	C	33	141

Parcel	Kind of Instrument	Date of Instrument	Grantor	Grantee	Recorded	Remarks
Cnr. #4	Q.C.D.	8-27-31	T.H. Wheatley	St. of Vt.	26 338-9 11-A-31	Curb Sta. 735+00

PLAN
 F.W. HANFORD
 1931

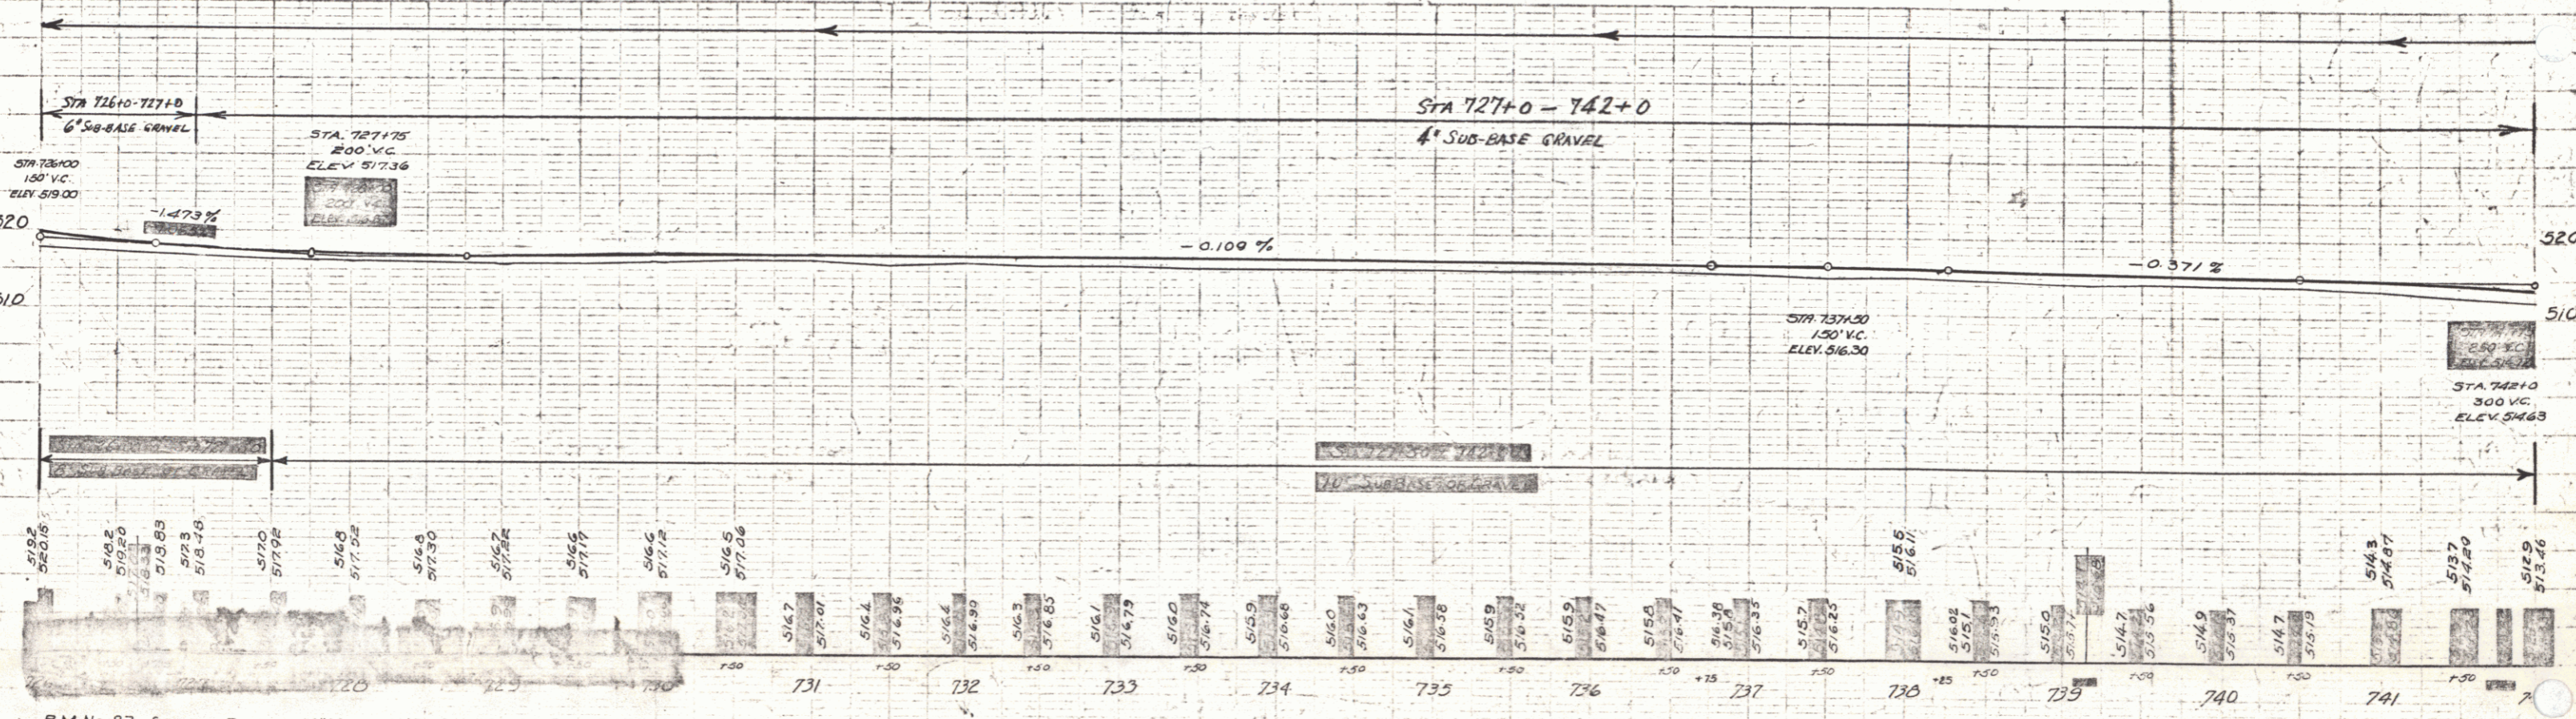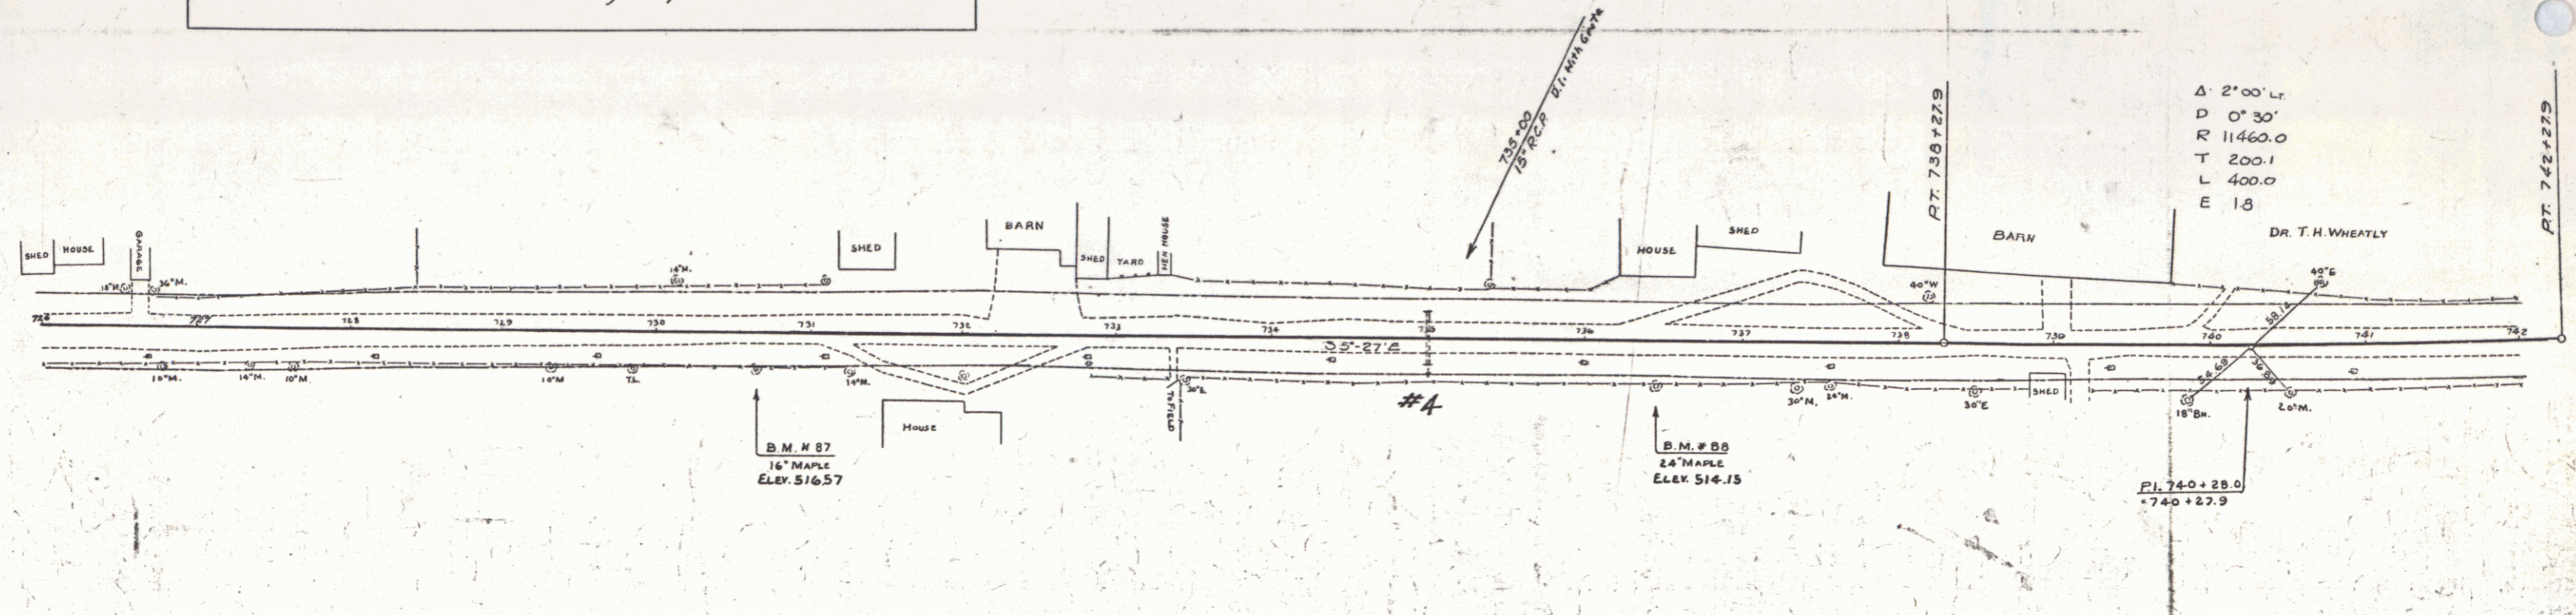

BM. No. 87 SPIKE IN ROOT OF 16" MAPLE 22' RT. STA. 730+63 ELEV. 516.57
 BM. No. 88 SPIKE IN ROOT OF 24" MAPLE 26' RT. STA. 736+43 ELEV. 514.15

SERIES F No. 129-C
 SHEET 33 of 141