
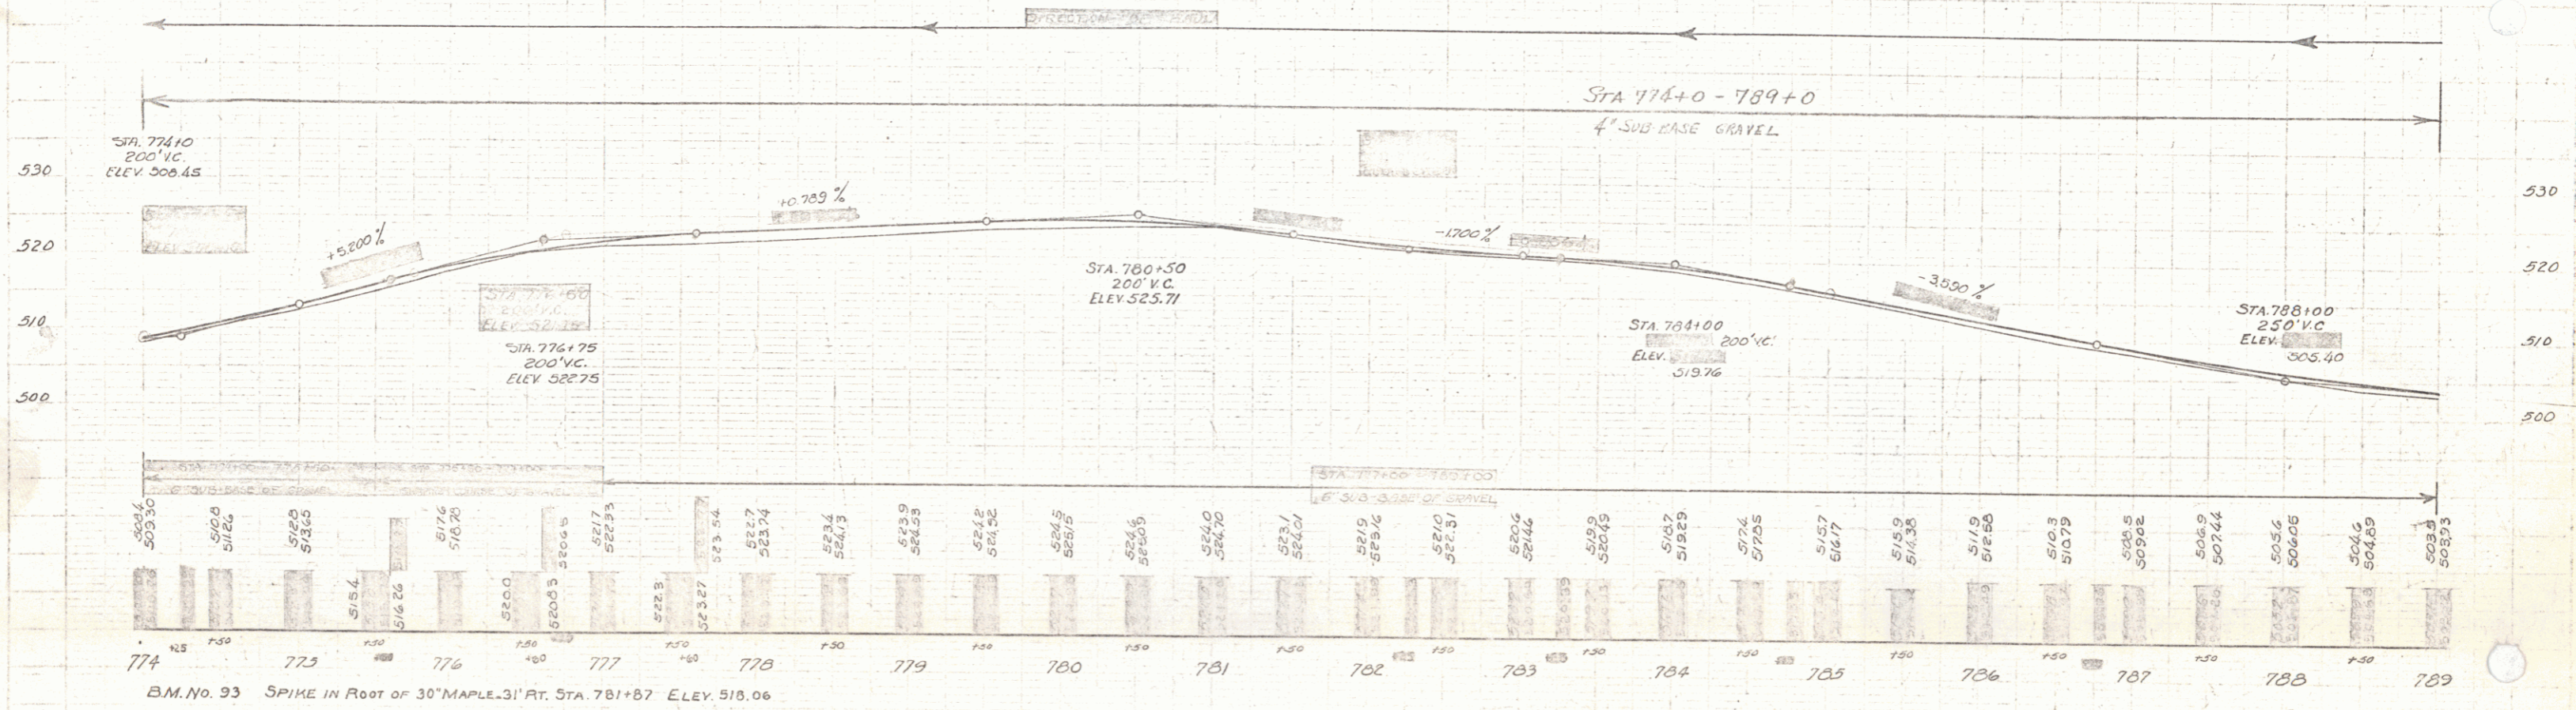


WOOD GUARD RAIL REQUIRED		GUIDE POSTS OF WOOD REQUIRED		NEW PINE POSTS REQUIRED	
STA.	LT.	STA.	LT.	STA.	LT.
777+30	26'	777+50	1'		

129-C 1931 36 1/41

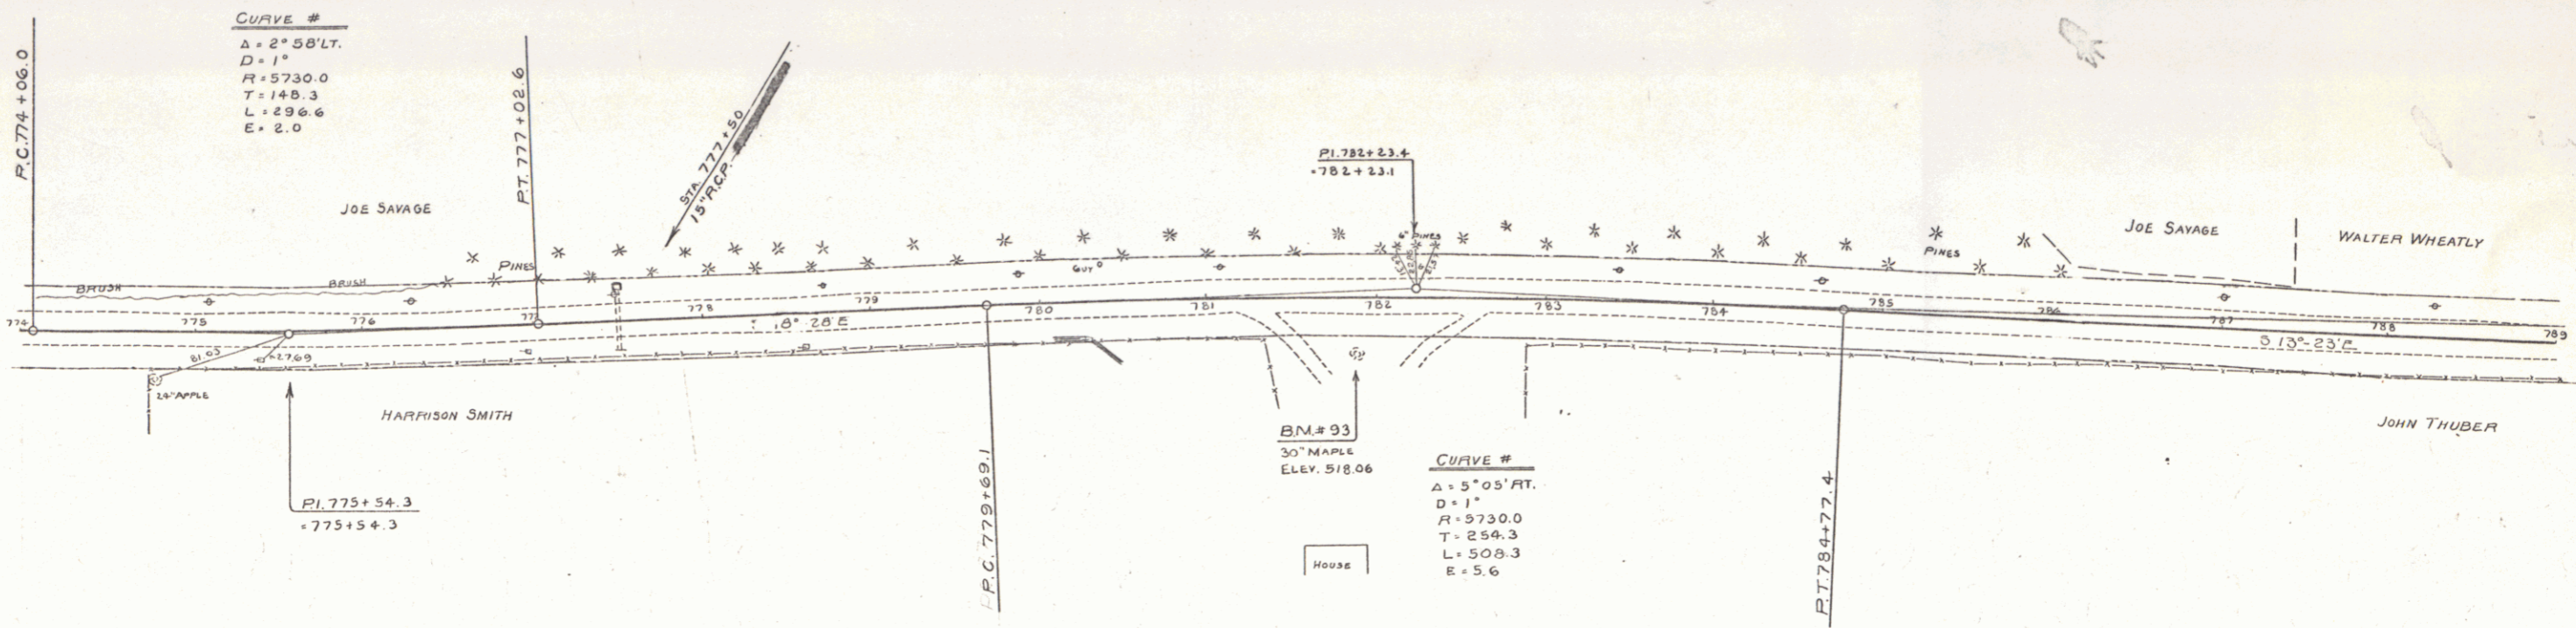

SERIES F No. 129-C  
SHEET 30 OF 41