

WOOD CURB & PAUL REQUIRED
 CURB STA 852+00 TO 854+00

STATION	DIAM	LENGTH	CONG. A	CONG. B	STEEL PIPE
852+00 - 852+10	18"	10'	1.2	1.2	1.2
852+10 - 852+20	18"	10'	1.2	1.2	1.2
852+20 - 852+30	18"	10'	1.2	1.2	1.2
852+30 - 852+40	18"	10'	1.2	1.2	1.2
852+40 - 852+50	18"	10'	1.2	1.2	1.2
852+50 - 852+60	18"	10'	1.2	1.2	1.2
852+60 - 852+70	18"	10'	1.2	1.2	1.2
852+70 - 852+80	18"	10'	1.2	1.2	1.2
852+80 - 852+90	18"	10'	1.2	1.2	1.2
852+90 - 853+00	18"	10'	1.2	1.2	1.2

STATION	DIAM	LENGTH	CONG. A	CONG. B	STEEL PIPE
853+00 - 853+10	18"	10'	1.2	1.2	1.2
853+10 - 853+20	18"	10'	1.2	1.2	1.2
853+20 - 853+30	18"	10'	1.2	1.2	1.2
853+30 - 853+40	18"	10'	1.2	1.2	1.2
853+40 - 853+50	18"	10'	1.2	1.2	1.2
853+50 - 853+60	18"	10'	1.2	1.2	1.2
853+60 - 853+70	18"	10'	1.2	1.2	1.2
853+70 - 853+80	18"	10'	1.2	1.2	1.2
853+80 - 853+90	18"	10'	1.2	1.2	1.2
853+90 - 854+00	18"	10'	1.2	1.2	1.2

RETAINING WALL REQUIRED
 STA 854+00 TO 854+10

STATION	WIDTH	LENGTH	AREA
854+00 - 854+10	4.5'	10'	7.5 sq. ft.



FEED NO.	STATION	FILE NO.	FEED NO.	STATION	FILE NO.
9	80-L	1931	44	141	

STATION	LOAF	CONG.	STEEL
853+60	RT	1.5 cu	157'

CURVE #
 Δ = 2° 29' LT.
 D = 0° 30'
 R = 1146.00
 T = 248.4
 L = 496.6
 E = 2.8

Parcel	Kind of Instrument	Date of Instrument	Grantor	Grantee	Recorded Randolph	Remarks
A	G.C.D.	10-28-31	NE Tyler	St. of W. 30	36A	2-2-32
B	"	10-28-31	W.F. Ashline	"	30	2-2-32

WHERE LINES ARE SHOWN TO CROSS WITH SUMMS SUMMS ARE TO BE CONSIDERED AS BELOW FLOW LINE OF CURB

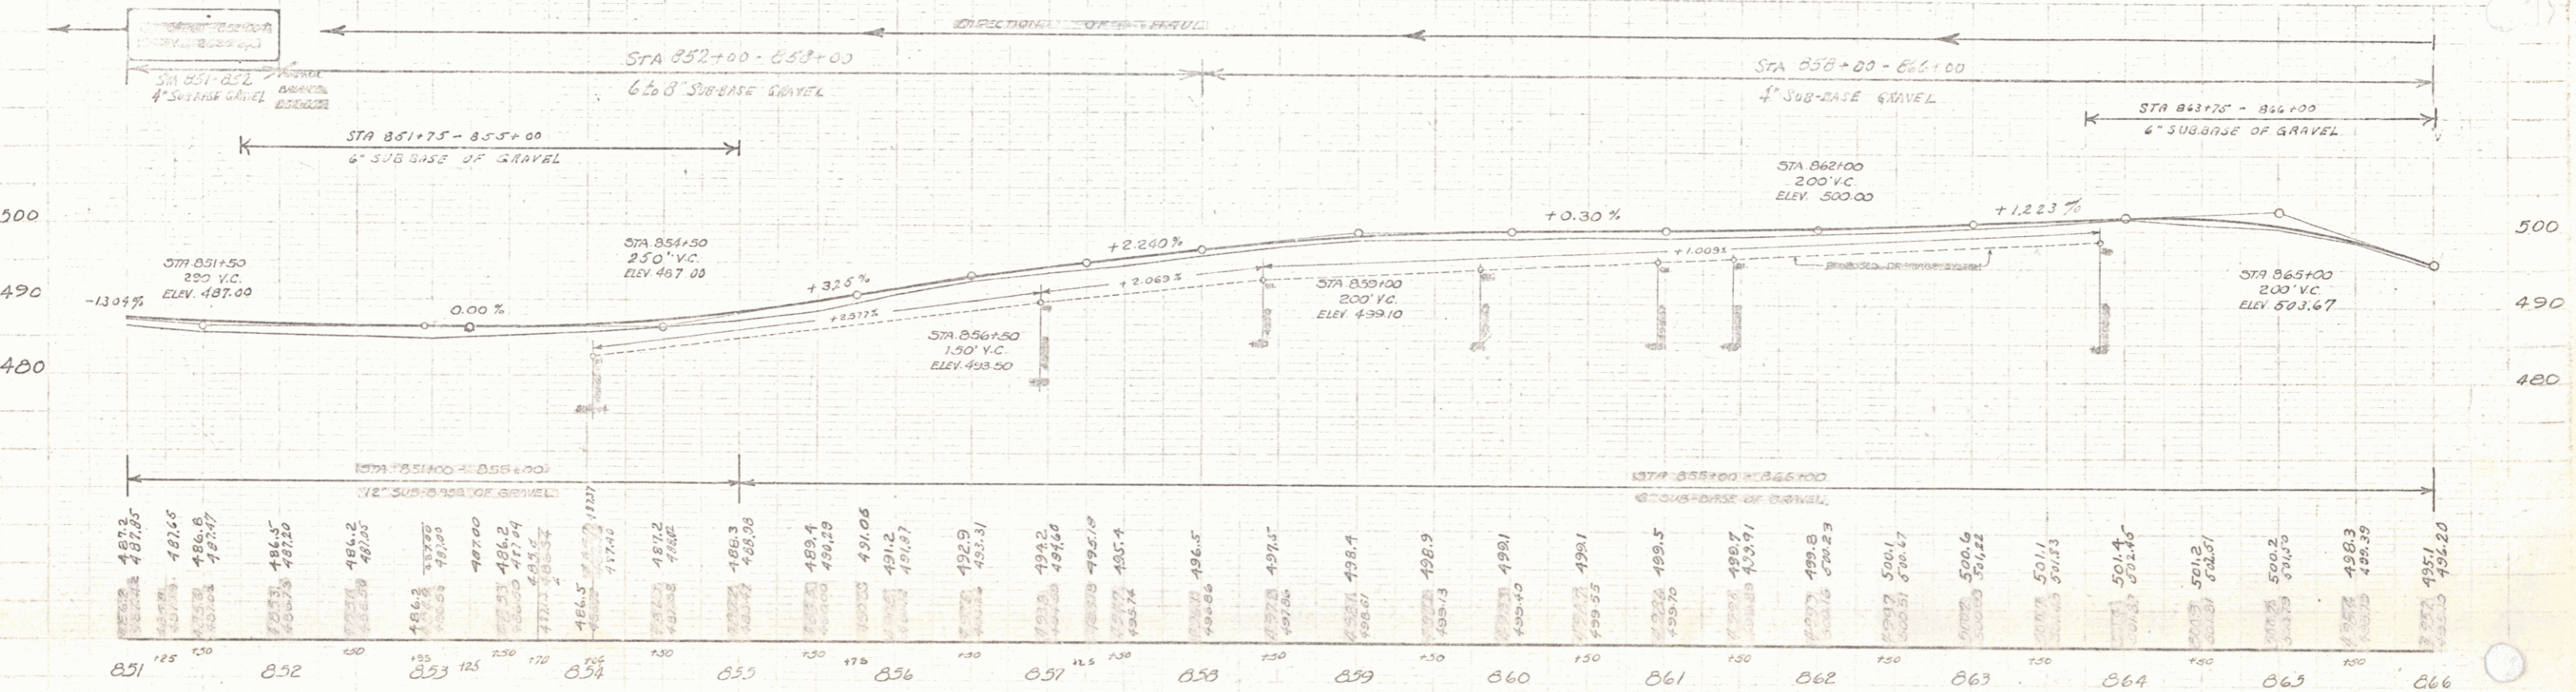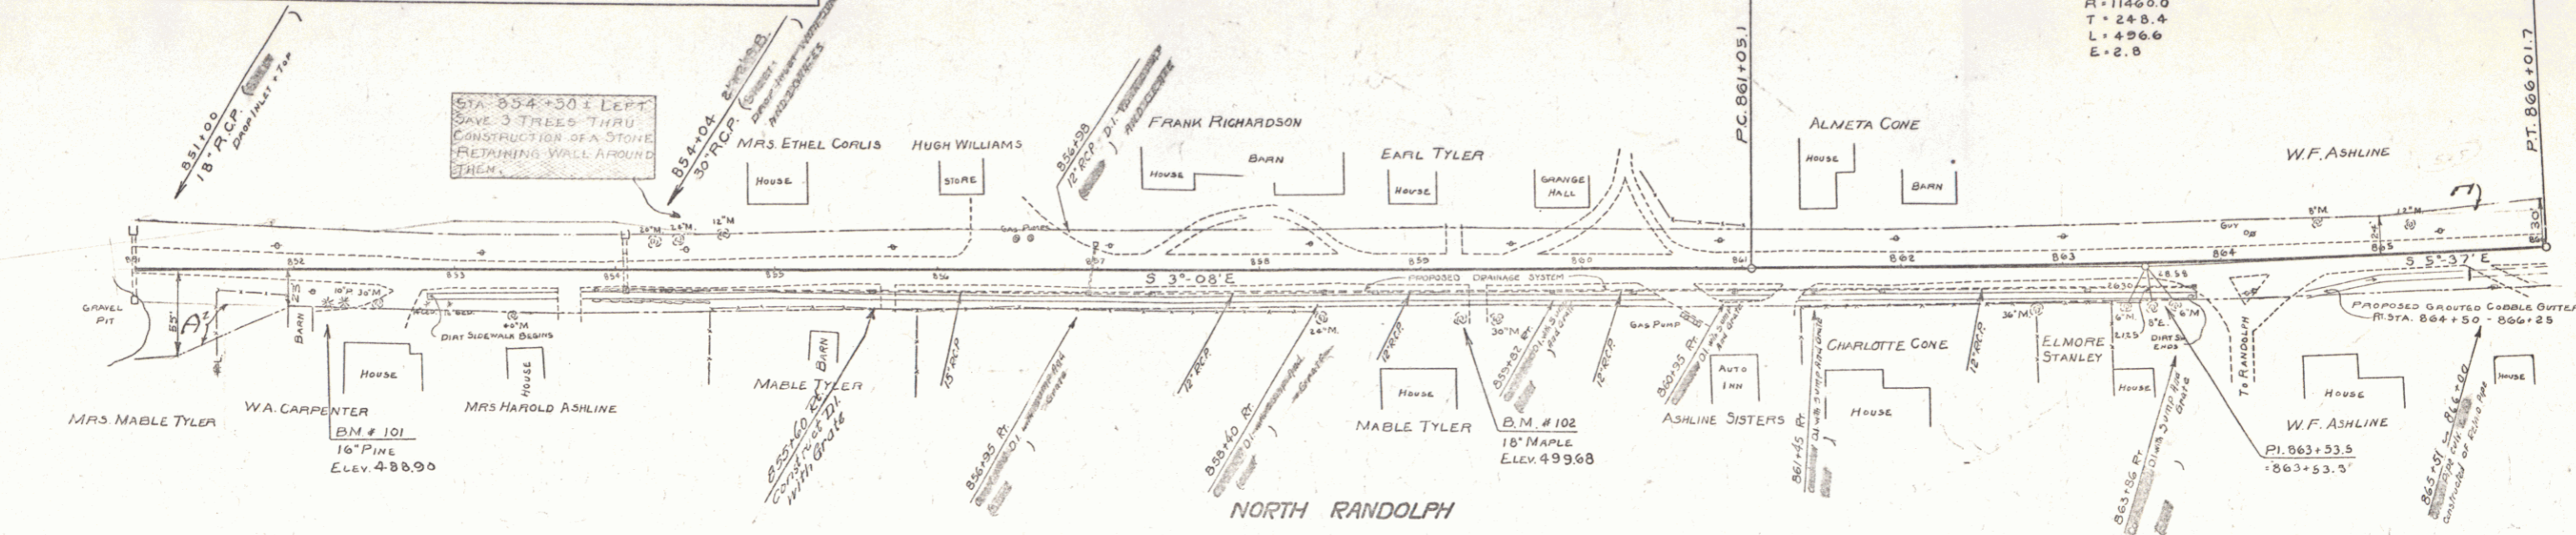

B.M. No. 101 SPIKE IN ROOT OF 16" PINE 17 FT. STA. 852+19 ELEV. 488.90
 B.M. No. 102 SPIKE IN ROOT OF 18" MAPLE 28 FT. STA. 859+46 ELEV. 499.68

SERIES No. 80-L
 SHEET 41 OF 141