
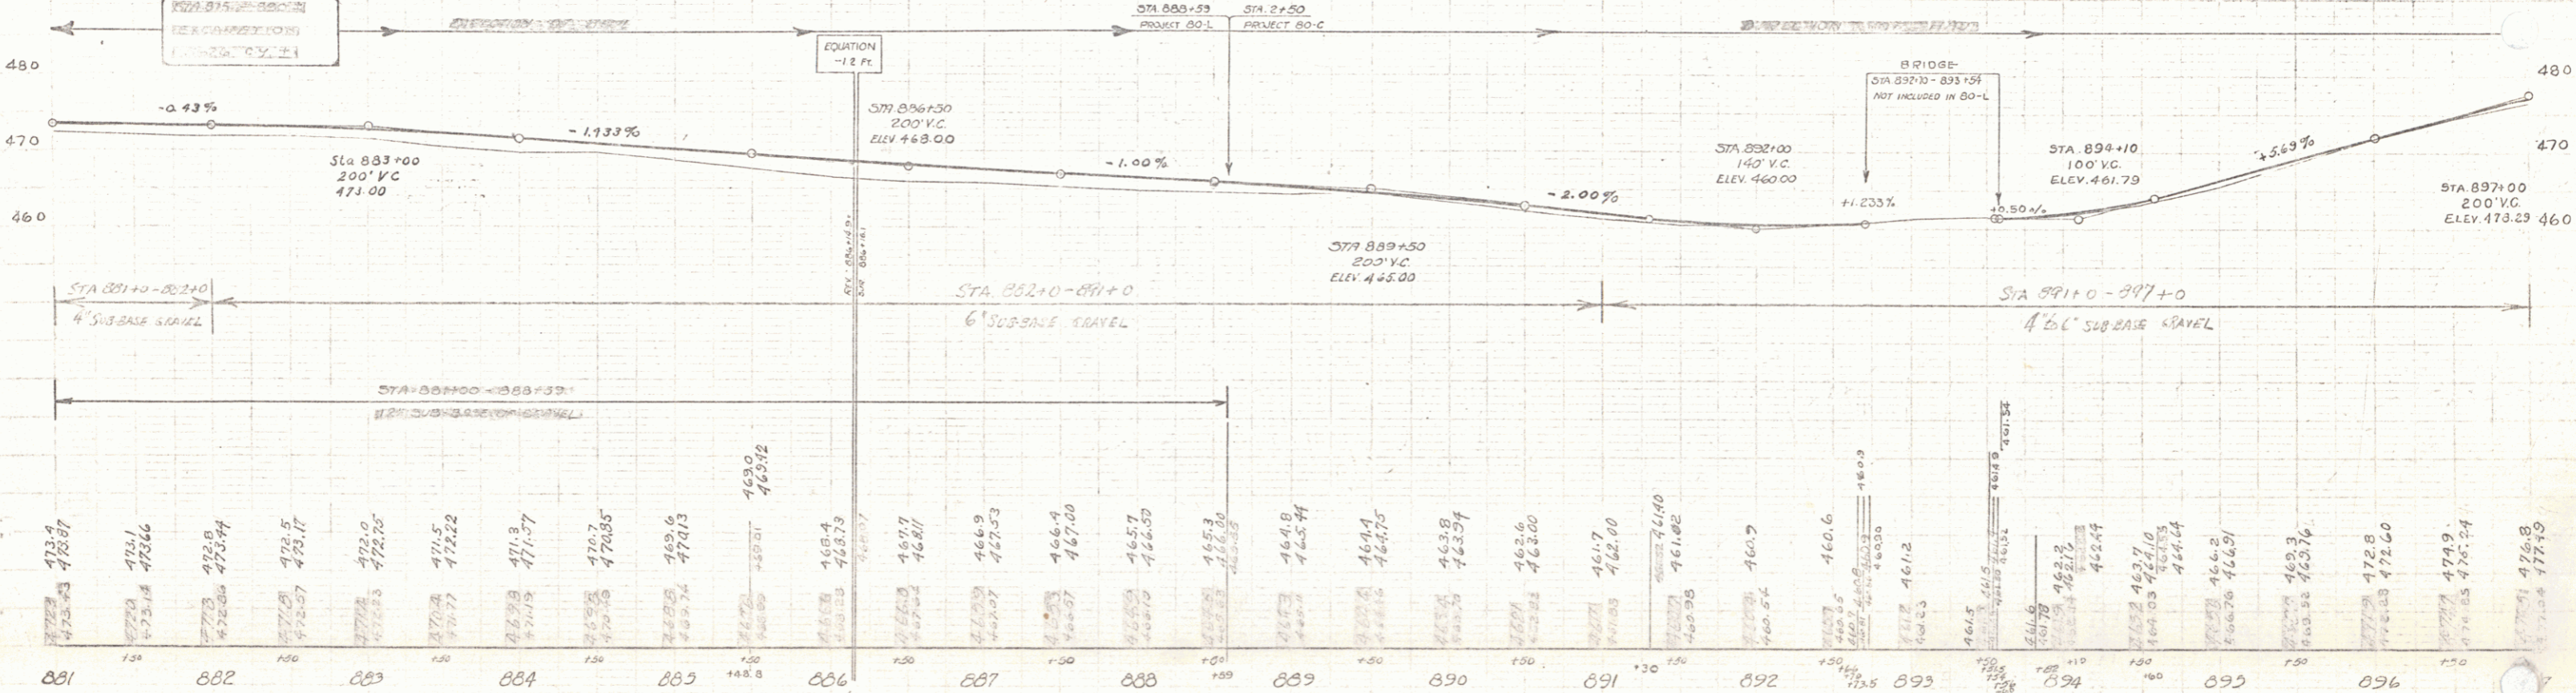


WOOD CHAINED RAIL REQUIRED	CABLE GUARD RAIL REQUIRED
STA. FROM	STA. FROM
004+50	001+00
24'	112'
24'	20'
	132'

Parcel	Kind of Instrument	Date of Instrument	Grantor	Grantee	Recorded	Remarks
A2	Q.C.D.	11-3-31	D.J. & H.M. Camp	St. of W. 50 183 A	2-3-32	Culk Sta. 884+50
A2	"	10-24-31	R.P. & G.F. Camp	"	50 274 A	2-3-31

DEEP INLET TOPS REQUIRED		
CULV. STA.	CAN. D.	STEP
884+00	22 CY	1'

SHEET NO.	TOTAL SHEETS
43	141

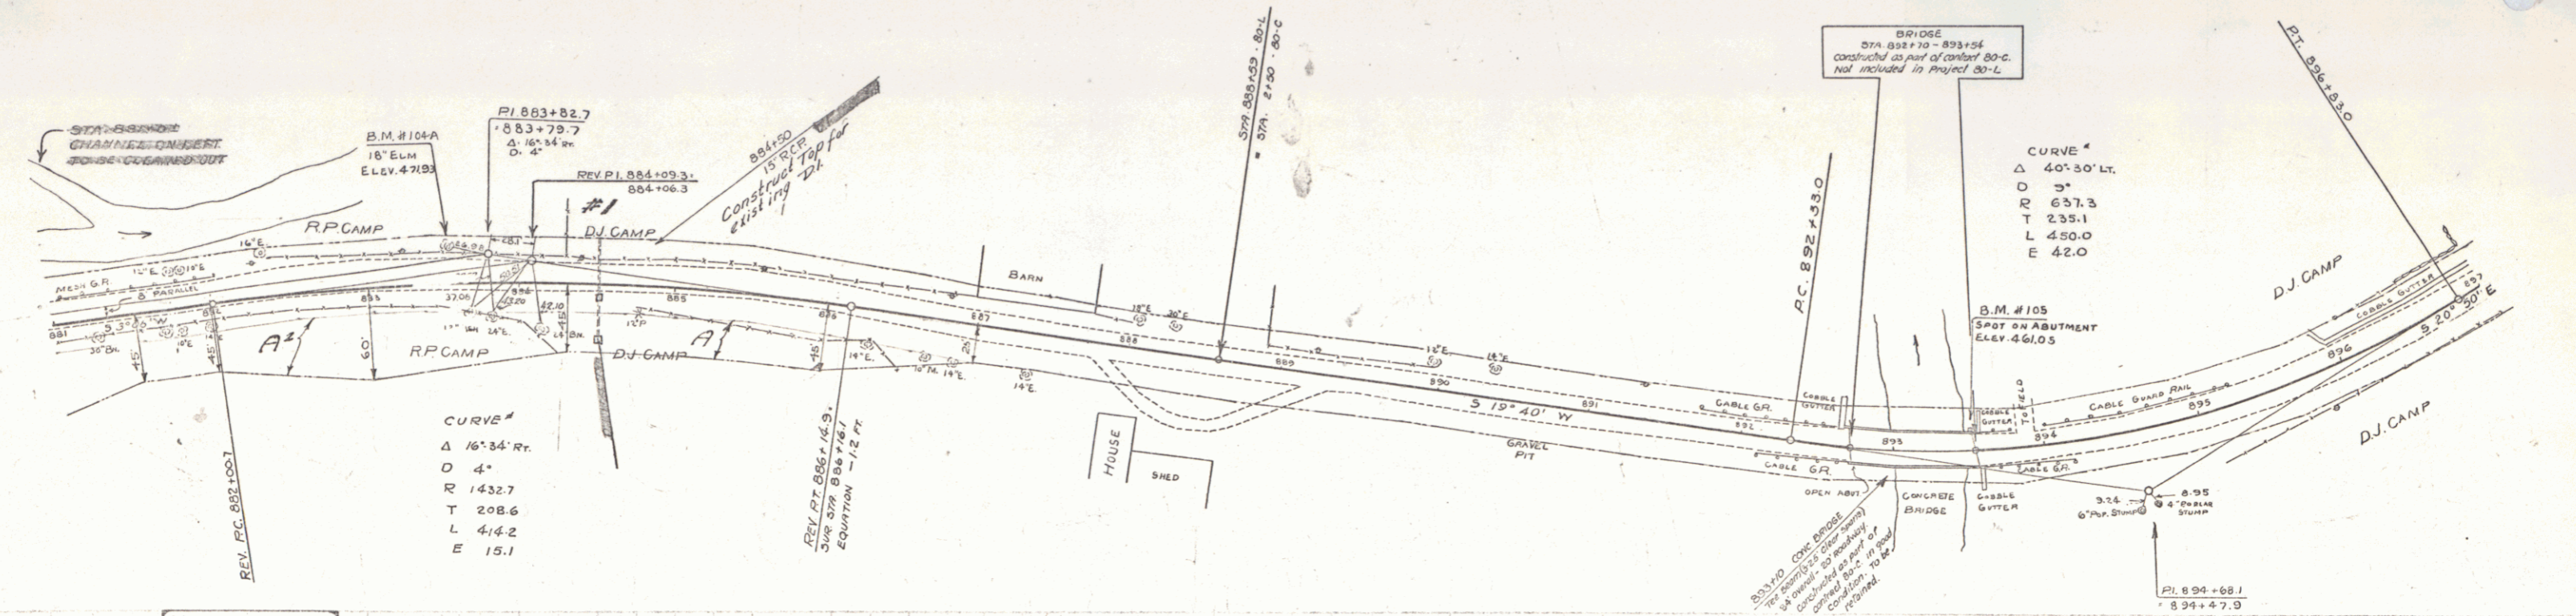

B.M. No. 104-A SPIKE IN FOOT OF 18" ELM 17 FT. LT. STA. 883+53 ELEV. 471.93
 B.M. No. 105 SPOT ON ABUTMENT OF CONG. BRIDGE 15 FT. LT. STA. 893+50 ELEV. 461.05

SERIES F No. 80-L
 SHEET 43 OF 141