

GUIDE POSTS REQUIRED	REQUIRED
Curb 3'x7'x12"	1
1026+24	1

CABLE GUARD RAIL REQUIRED	REQUIRED
2 1/2" x 2 1/2" L x E Leng. Const. City Leng.	48' 40' 88'
1026+24	48'
1027+10	40'
1037+10	88'



NEW REINF. CONC. PIPE CULVERTS REQUIRED				
STATION	DIAM	LENG	CONC A	STEEL
1026+24	18"	36'	2.7	75#
1034+30-1035+10	18"	80'	1.8	2.7
1037+10	15"	36'	2.7	75#

NEW REINF. CONC. BOX CULVERTS REQUIRED			
STATION	SIZE	CONC A	STEEL
1032+24	3'x3'	2.5	75#

GRAUTED COBBLE GUTTER REQUIRED			
STATIONS	Len R	WIDTH	AREA
1033+50-1034+30	RT.	4'-6"	40 sq. yd.
1040+50-1041+00	RT.	4'-6"	25 sq. yd.

NO.	STATE	FED. AD.	TOTAL	SHEET
1026	VT.	80-L	1931	52

Plan of Date of Grantor Grantee Recorded Remarks
 A, B, C. G.C.D. 11-6-34 Alton D. Deiron Sta. 1030+05 30 55' 7 2-3-31

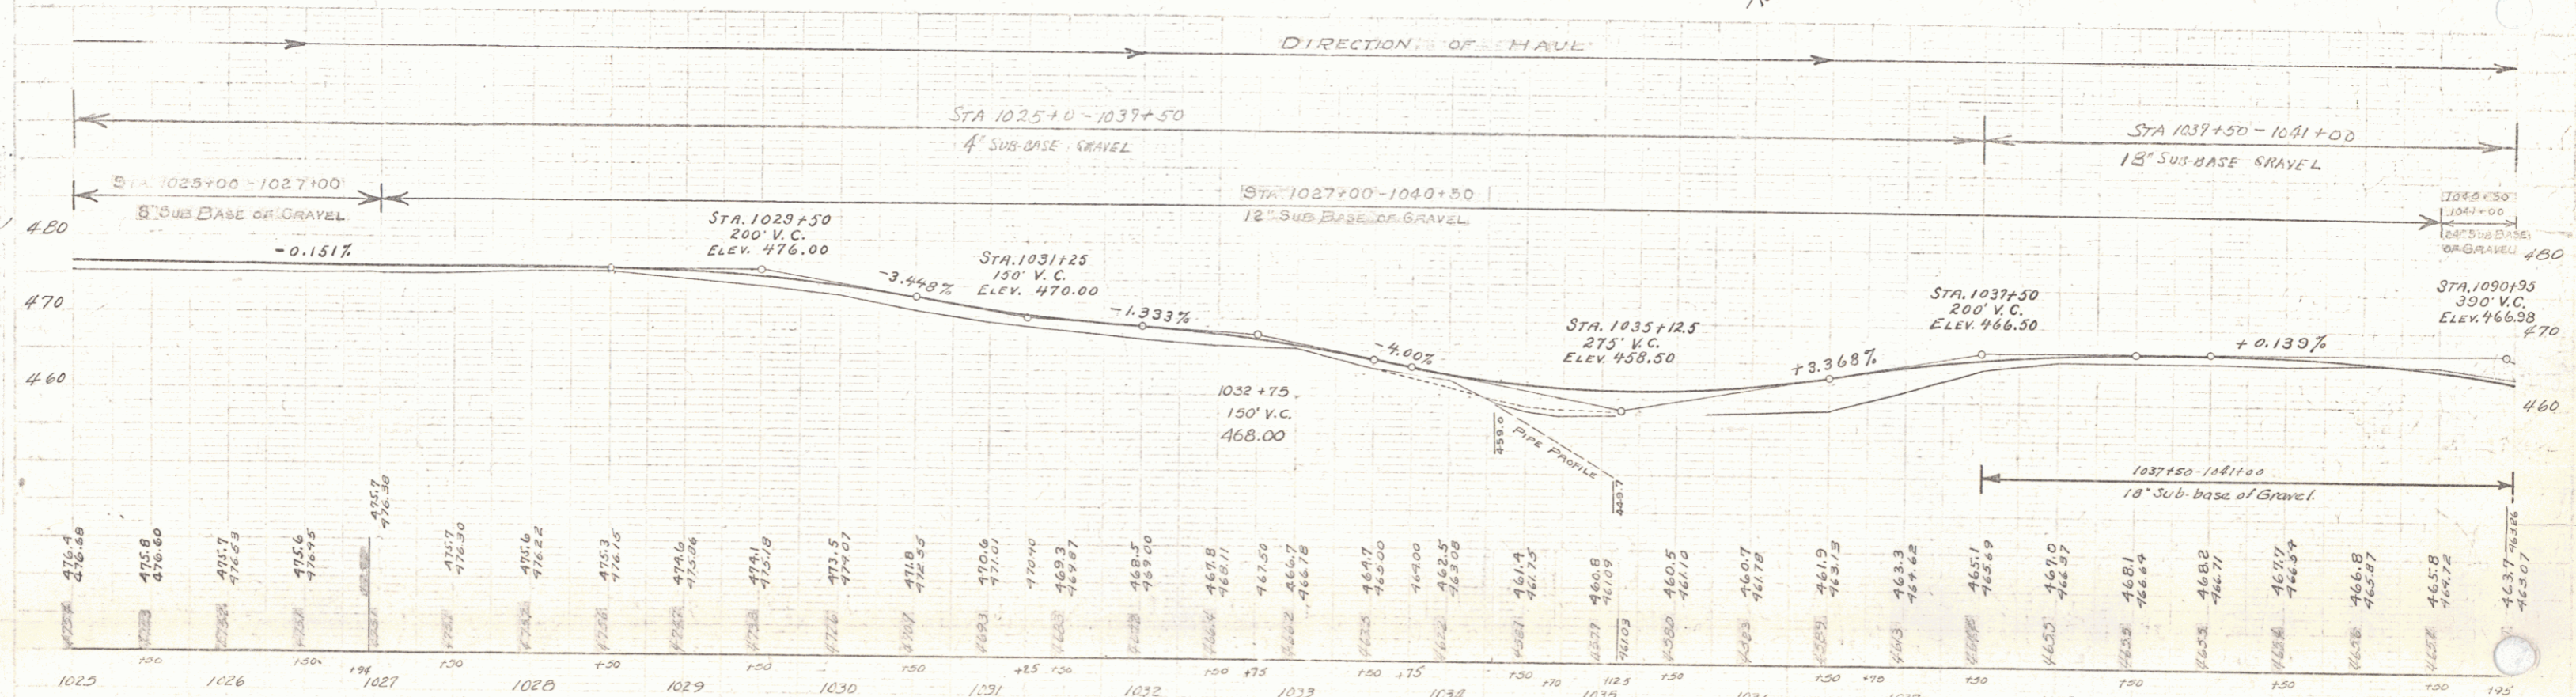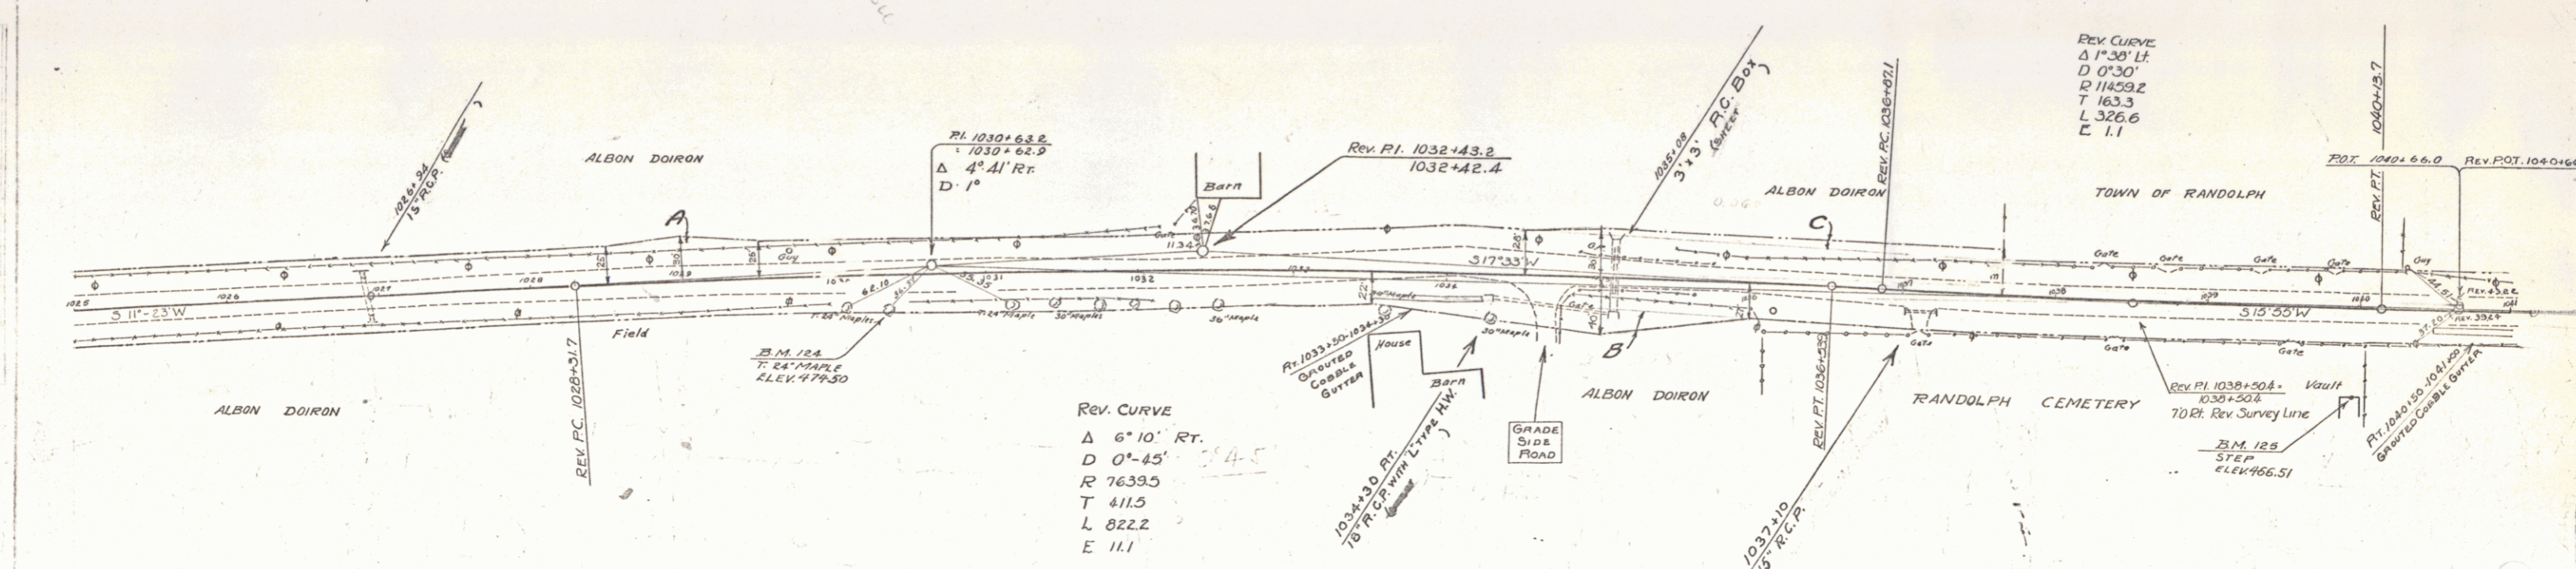

B.M. 124 Spine in Root T. 24" Maple 18" Rt. Sta. 1030+05 ELEV. 474.50
 B.M. 125 Step of Vault, 60' Rt. of Sta. 1039+96 ELEV. 466.51

SERIES F No 80-L
 SHEET 30 OF 1-1