

PLAN
 DATE: 1/16/63
 DRAWN BY: Palmer, Hopkins
 CHECKED BY: [Signature]
 NO. OF SHEETS CHECKED: [Blank]

PROFILE
 DATE: 1/16/63
 DRAWN BY: Palmer, Hopkins
 CHECKED BY: [Signature]
 NO. OF SHEETS CHECKED: [Blank]

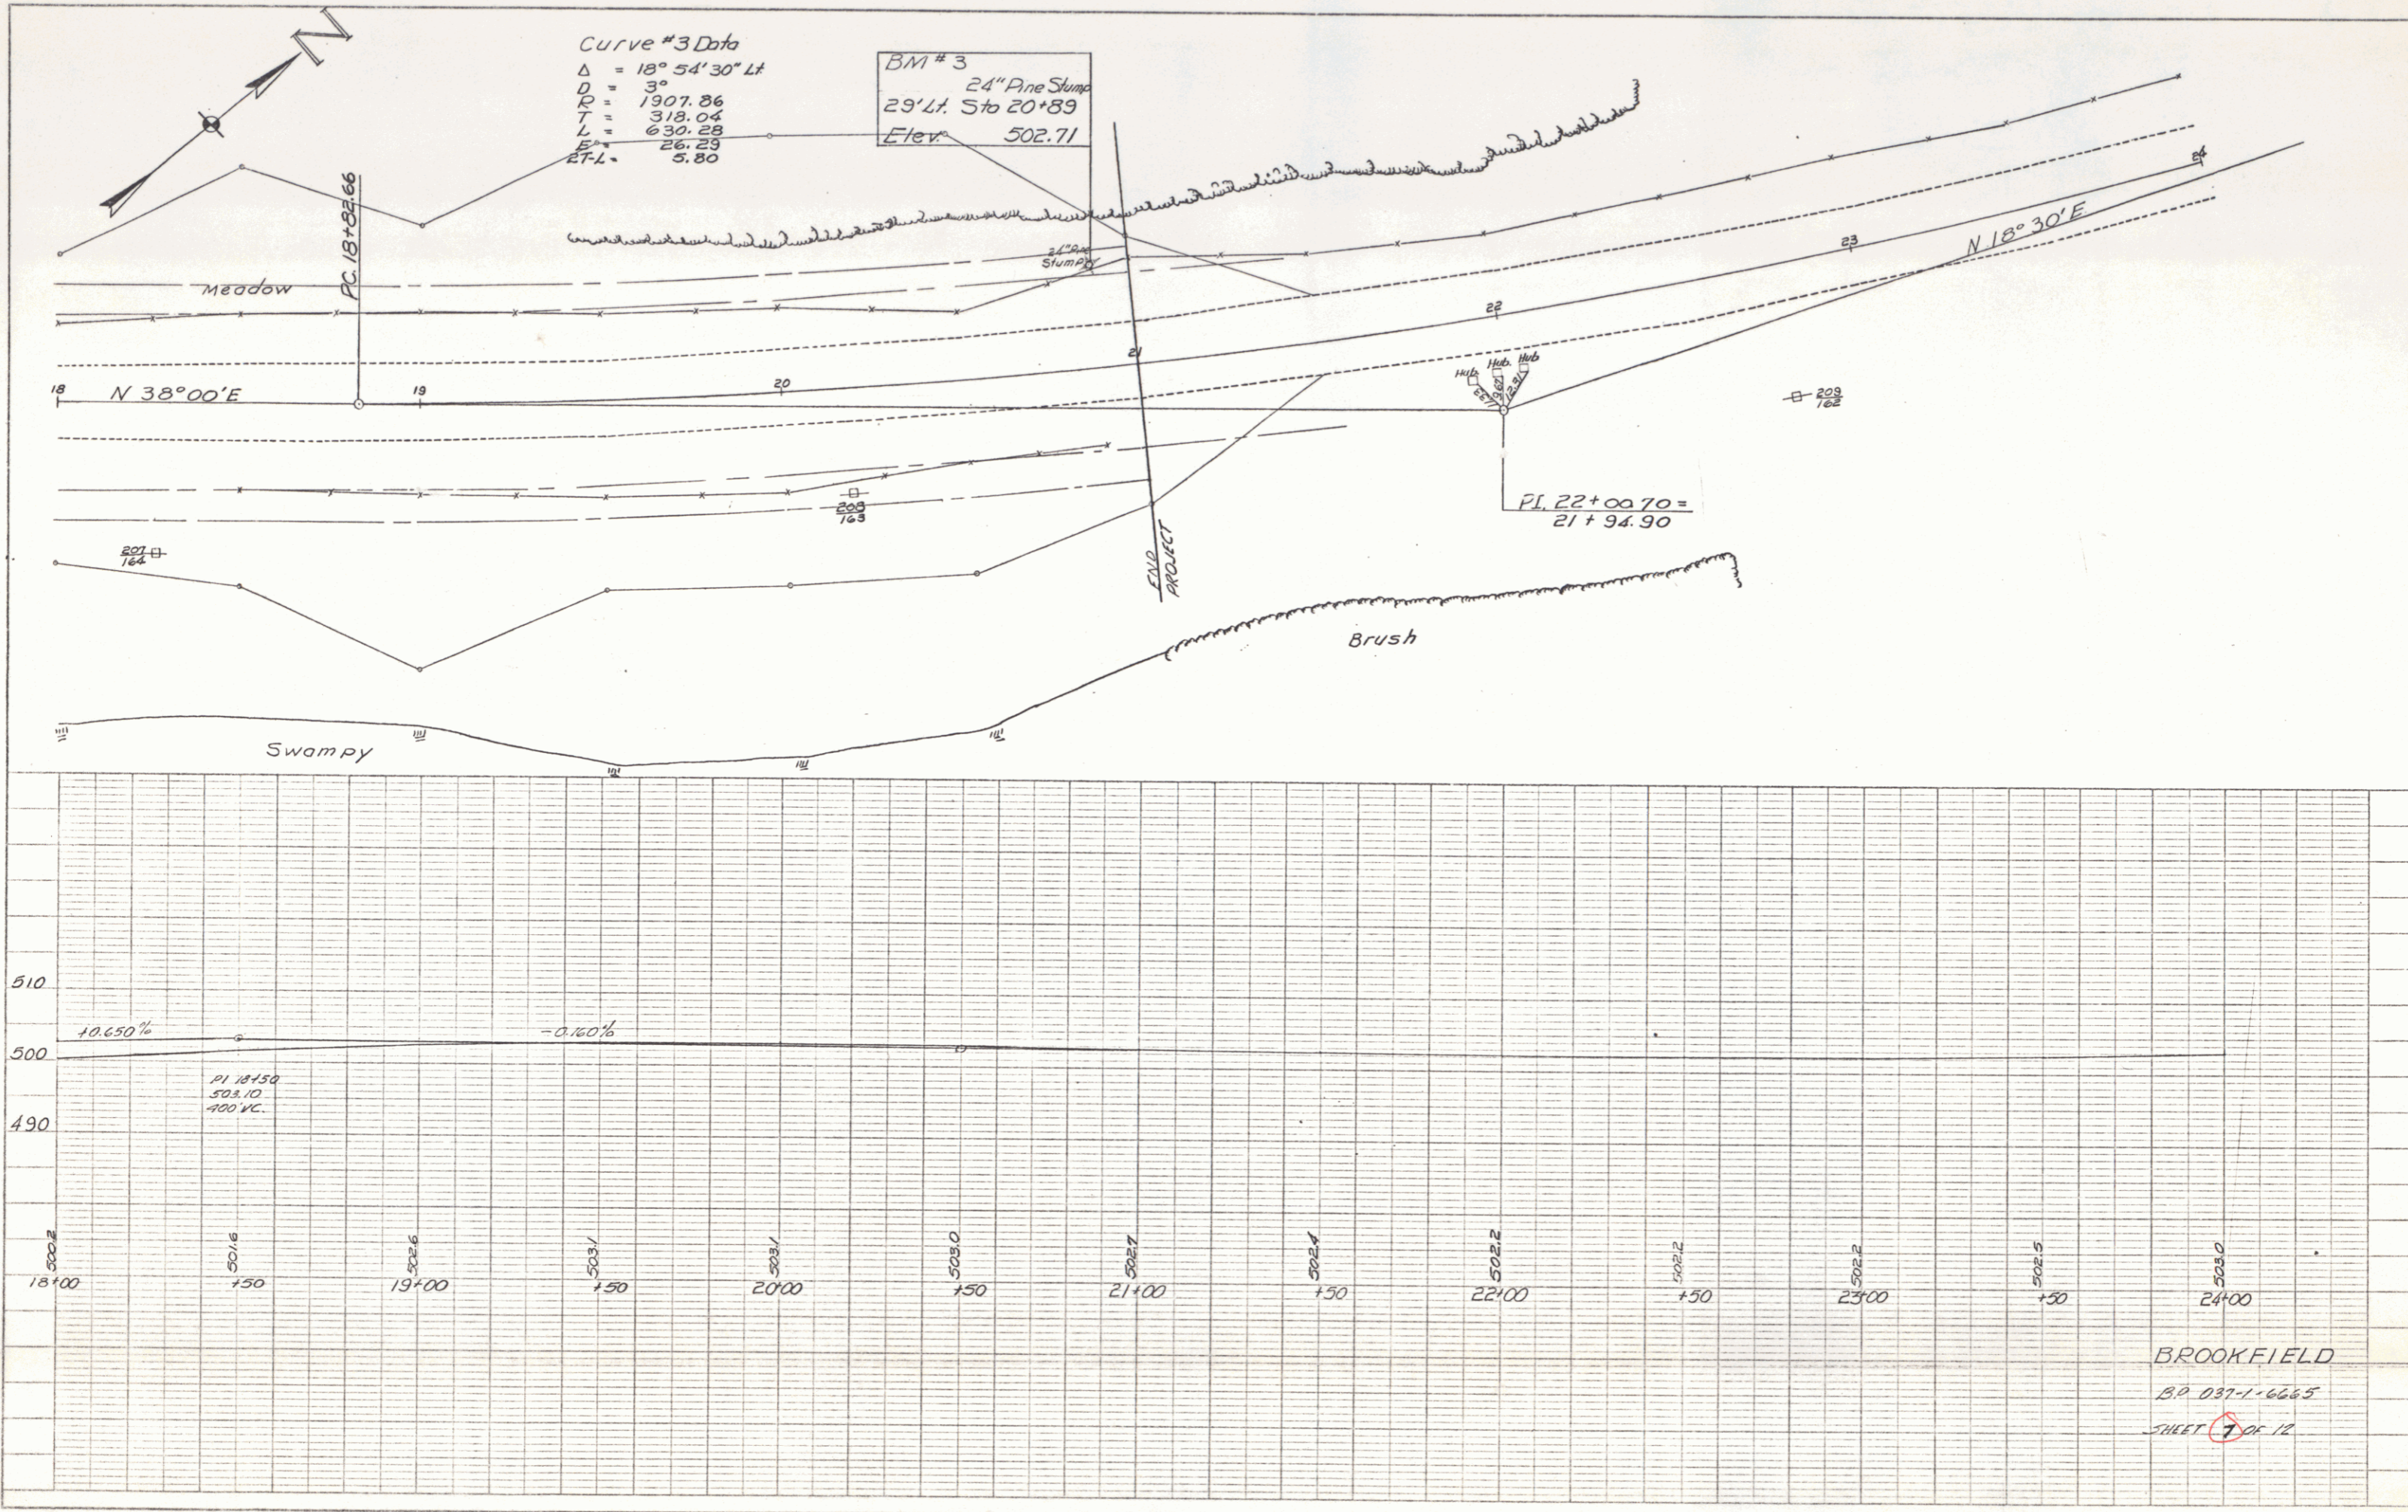


PLATE 1, PLAN-PROFILE
 KEIGHTLY & SISK CO.
 48 7010 PROGRESS ROAD, ST. LOUIS, MO. 63111

BROOKFIELD
 B.P. 037-1-6665
 SHEET 7 OF 12