



WOOD GUARD RAIL REQUIRED				GRABLE GUARD RAIL REQUIRED				NEW REINF CONC PIPE CULV REQUIRED				CULV REPAIRS REQUIRED			
CULV STA	Left	Right	Stations	LENG	CONC	By Leng	STA	DIAM	LENG	CONC	CONC	STEEL	CONC	STEEL	
12344.2	24'	24'	12344.2-12610.0	265'	120	140	12310.0	15"	56.77	140	1072.85	140	4.3	357	
12910.0	24'	24'	12745.0-13113.8	368'	80	288	12310.0	18"	14	300	3.8	25			
13440.6	24'	24'	13113.8-13440.6	326'	80	261									

SCALE 1" = 40' HORIZ. 1" = 10' VERT. 123-A 1931 12 B5

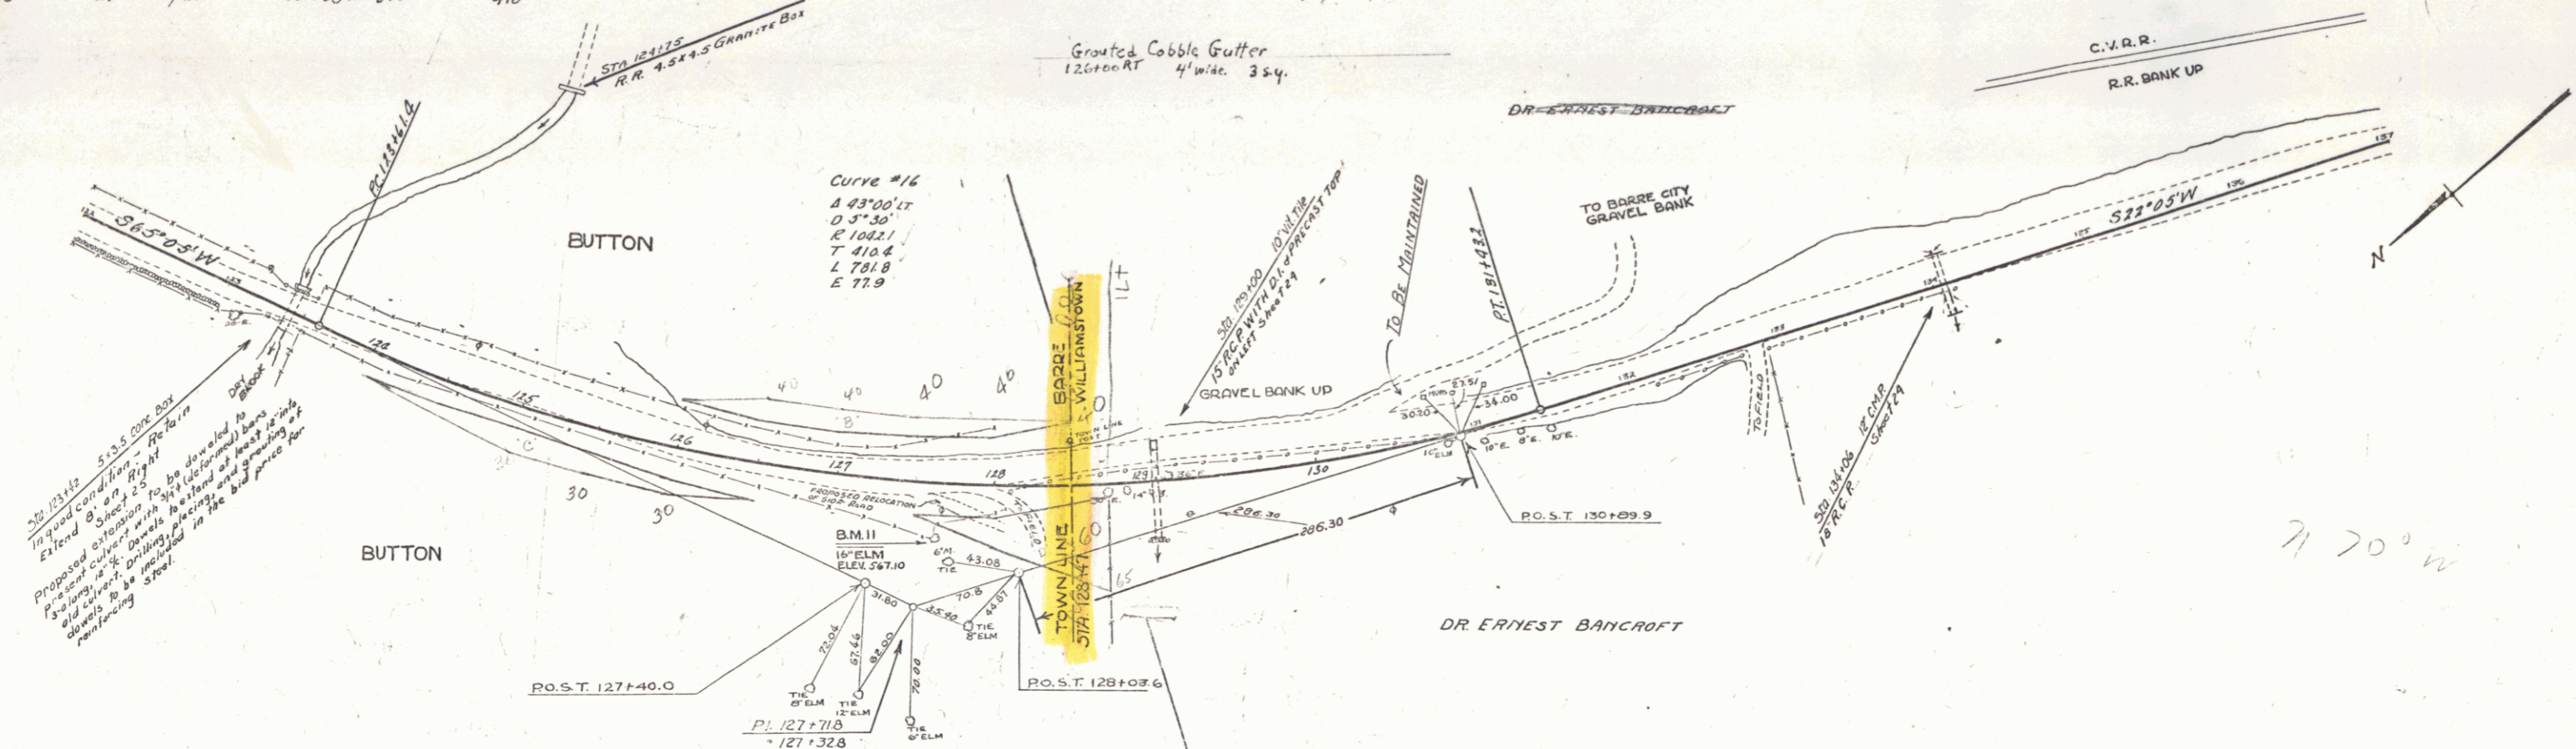

BUTMAN BUTMAN

CHANCE 87-30

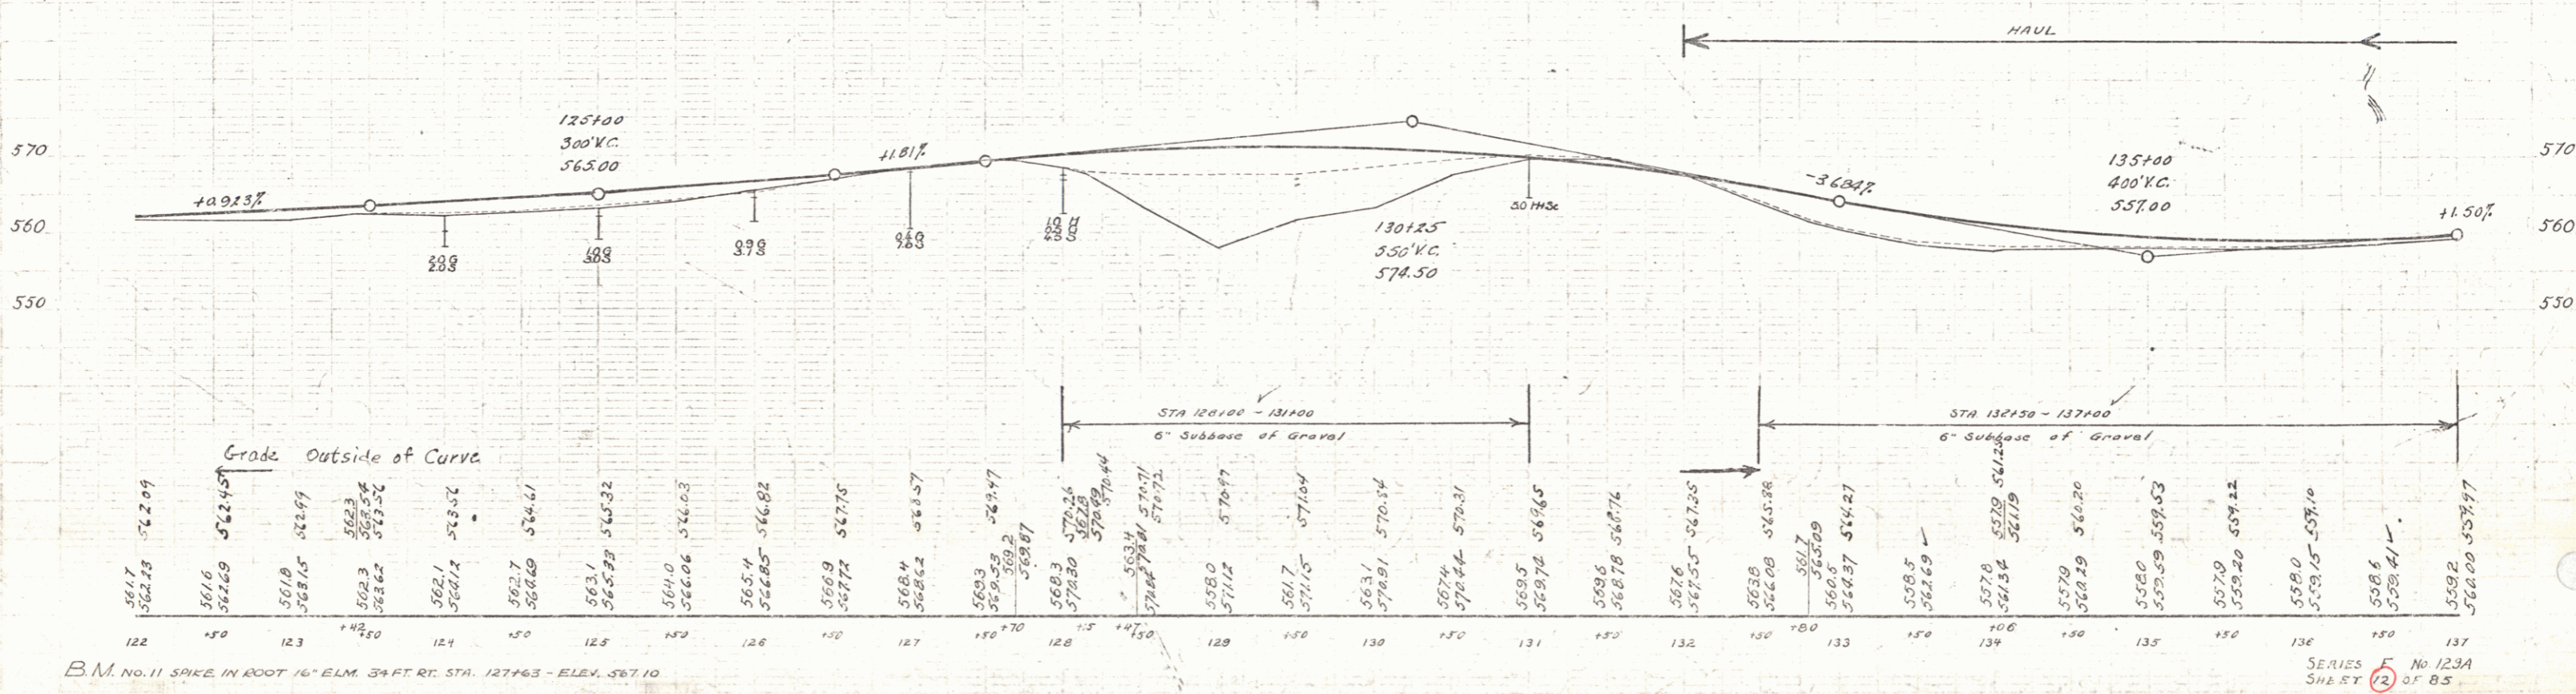

B.M. NO. 11 SPIKE IN ROOT 16" ELM. 34 FT. RT. STA. 127+63 - ELEV. 567.10

SERIES F No. 123A SHEET 2 OF 85