

**WOOD GUIDE POSTS REQUIRED**

Cully Sta.	Left	Right
109+18	-	1
200+60	-	1

**CABLE GUARD RAIL REQUIRED**

Stations	Length	Count	By
196+24-198+32	20	40	35
198+32-201+52	30	60	35
201+52-203+00	18	36	35

**NEW REIN. CONC. PIPE CULV. REQUIRED**

STA. DIAM.	LENG.	CONCR.	STEEL	CEMENT	MASS	STEEL	CEMENT	MASS
18" DIA.	10'	1.35	1.73	1.90	2.07	1.35	1.73	1.90
24" DIA.	10'	2.3	3.1	3.5	3.7	2.3	3.1	3.5

**NEW REIN. CONC. BOX CULV. REQUIRED**

STA. DIAM.	LENG.	CONCR.	STEEL	CEMENT	MASS	STEEL	CEMENT	MASS
18" DIA.	10'	1.35	1.73	1.90	2.07	1.35	1.73	1.90
24" DIA.	10'	2.3	3.1	3.5	3.7	2.3	3.1	3.5



**NEW C.C.P. PIPE CULV. REQUIRED**

STA. DIAM.	LENG.
24" DIA.	10'

**STO. UNDERDRAIN WITH 6" PERK C.G.M.P.**

Stations	Length
196+80-199+78	238'
	270'

129-A 1931 17 85

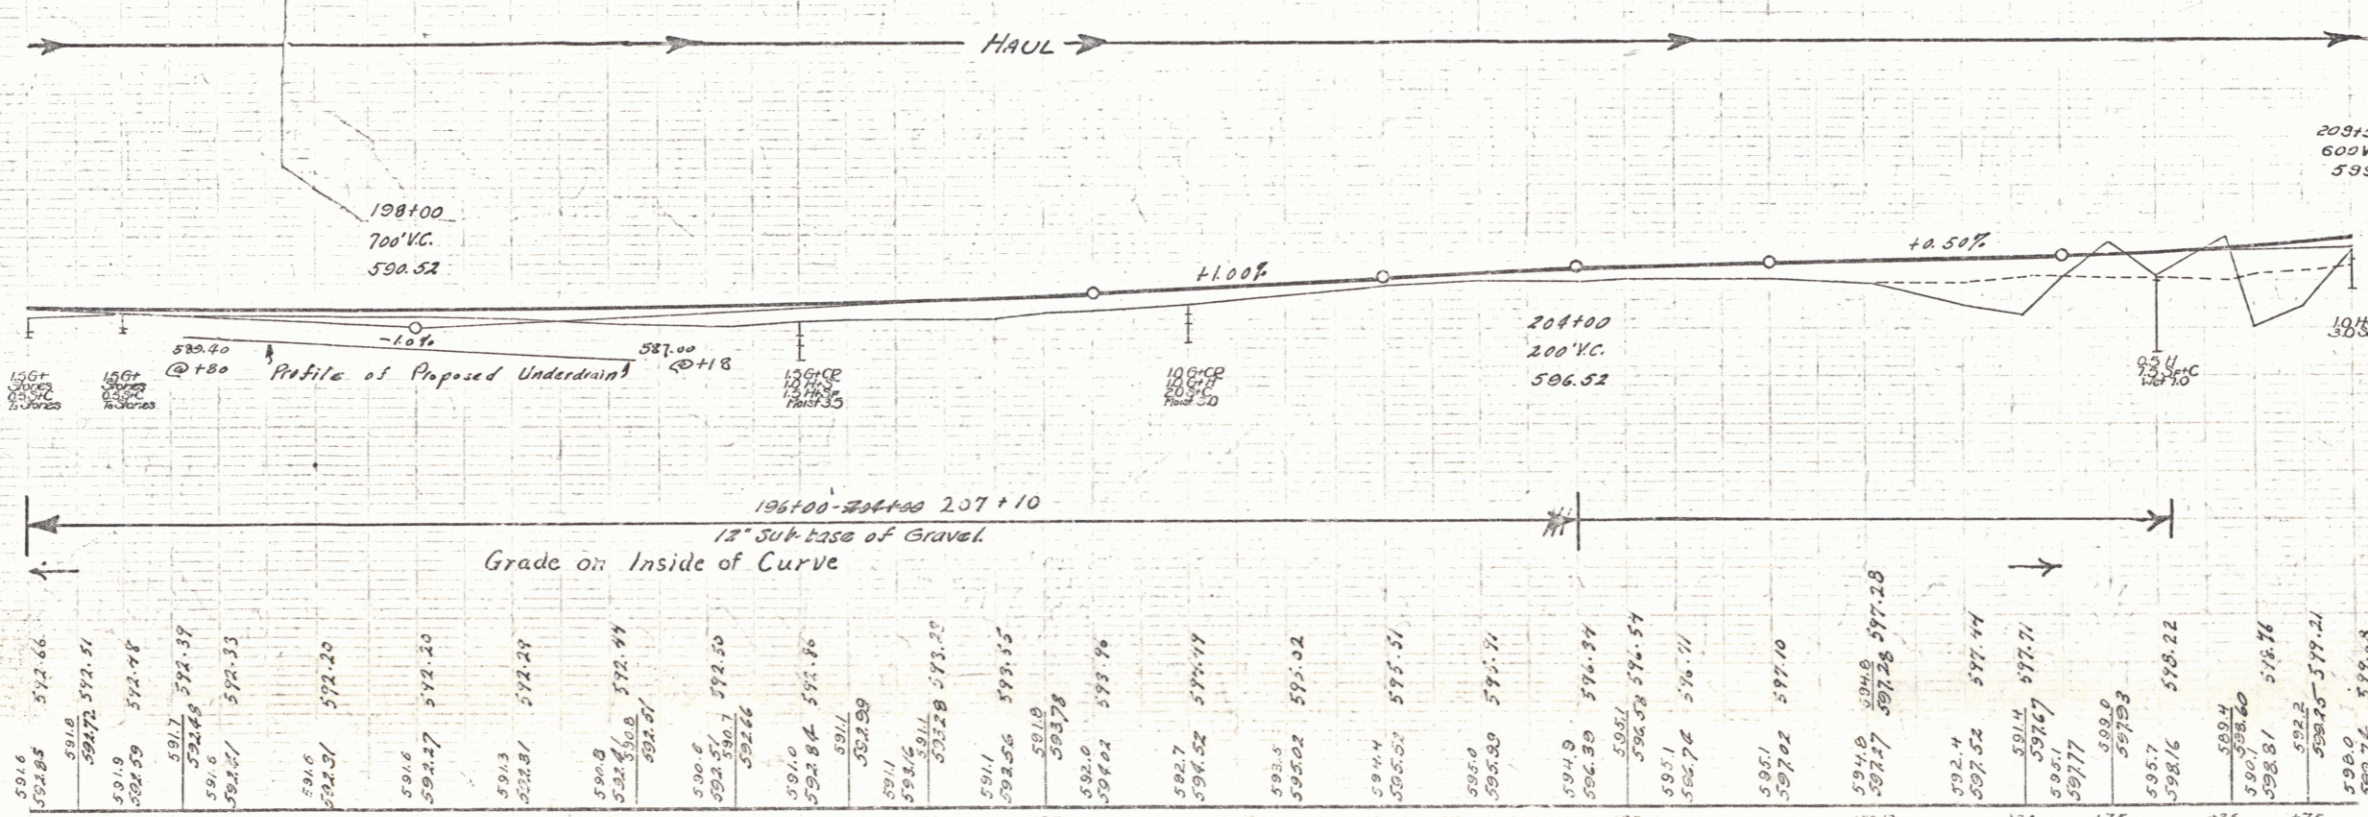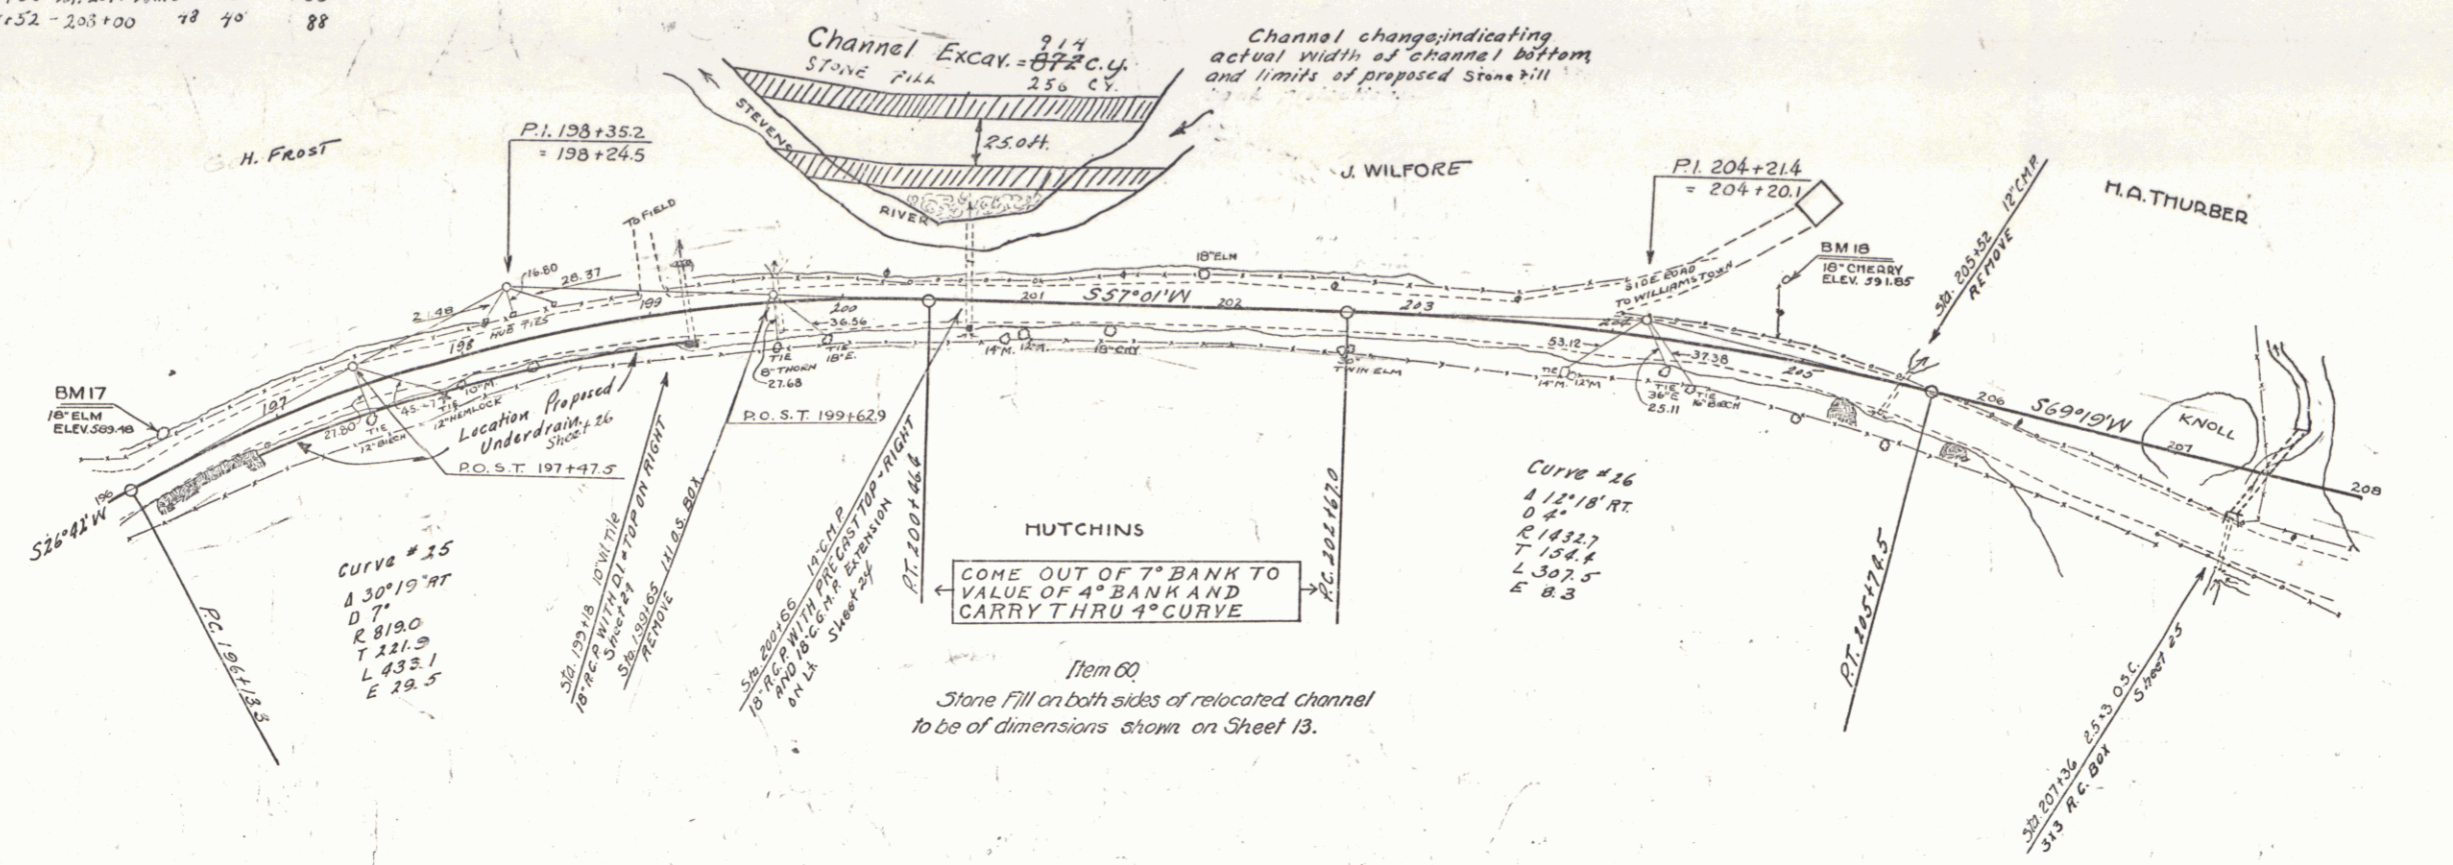

B.M. NO. 17 SPIKE IN BACK OF 3" ELM 15 FT. LT. STA. 196+42 - ELEV. 509.42  
 B.M. NO. 18 SPIKE IN SIDE 24" CHERRY STUMP 30 FT. LT. STA. 204+82 - ELEV. 591.05

SERIES F No 129-A  
 SHEET 17 OF 85