
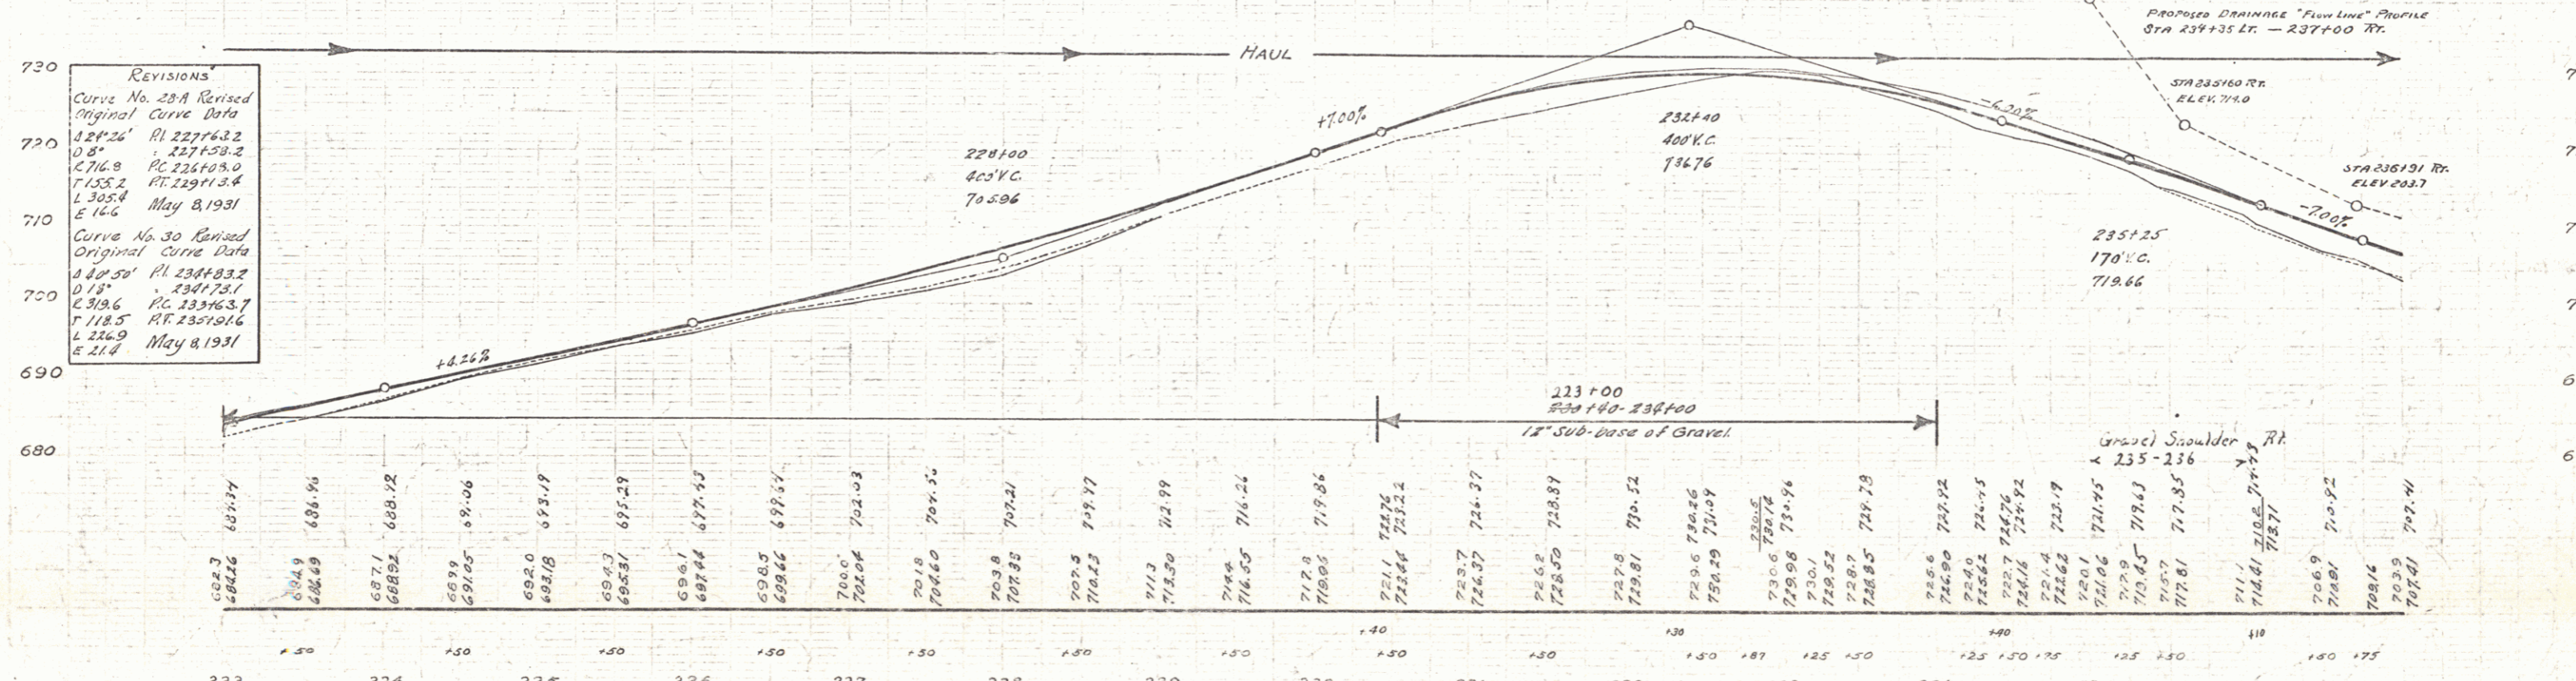


WOOD GUARD RAIL REQUIRED		CABLE GUARD RAIL REQUIRED		NEW REINFORCED CONCRETE PIPE CULV REQUIRED		NEW VITRIFIED CLAY PIPE CULV REQUIRED		GRADED CABLE GUTTER REQUIRED		CONCRETE CURB AND GUTTER REQUIRED		
CULV STA	Left	Right	Stations	Length	Const	Daylength	STA	DIAM	LENGTH	CONC	STEEL	
228+50		20'	228+20-228+40	148'	40'	108'	224+50	24"	20'	CONC	STEEL	
WOOD GUARD POSTS REQUIRED				PARCEL INSTRUMENT DATE		GRANTOR		GRANTEE		RECORDED		
CULV STA	Left	Right			A		O.C.O. S-20-31 C.W. & MARGA SEEVER		J.T. OF V.		WILLIAMSTOWN 30 20 S-20-31	
228+50											BENMARKS 225+74 (R.H. R) 225+79 " 225+80 "	

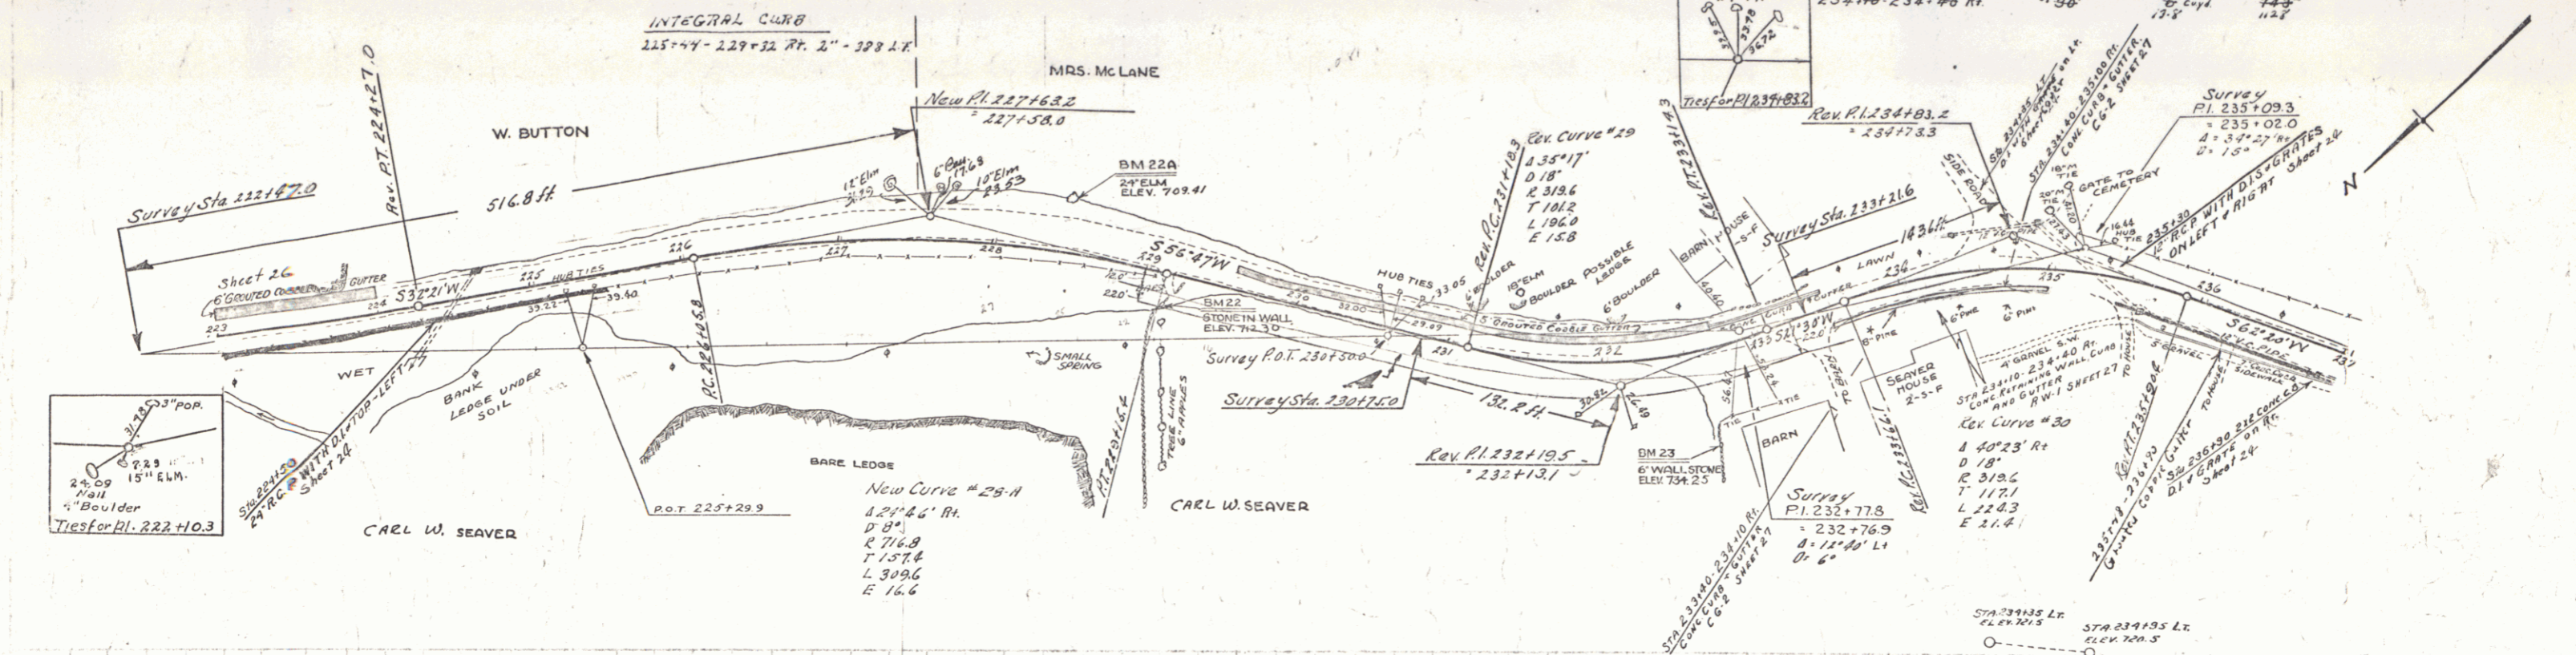

STATION	ELEVATION
223	684.16
224	688.12
225	691.05
226	695.29
227	700.04
228	704.55
229	709.11
230	713.50
231	717.86
232	721.92
233	725.62
234	728.87
235	731.52
236	733.76
237	735.24

BM 22 TOP OF STONE IN WALL 20 FT BT STA 223+10 ELEV 712.30
 BM 22A SHIP IN ROOT 24' ELM 32 FT LT STA 224+45 ELEV 709.41
 B.M. 23 TOP OF BOLDER IN WALL 6 FT BT STA 232+60 ELEV 734.25