
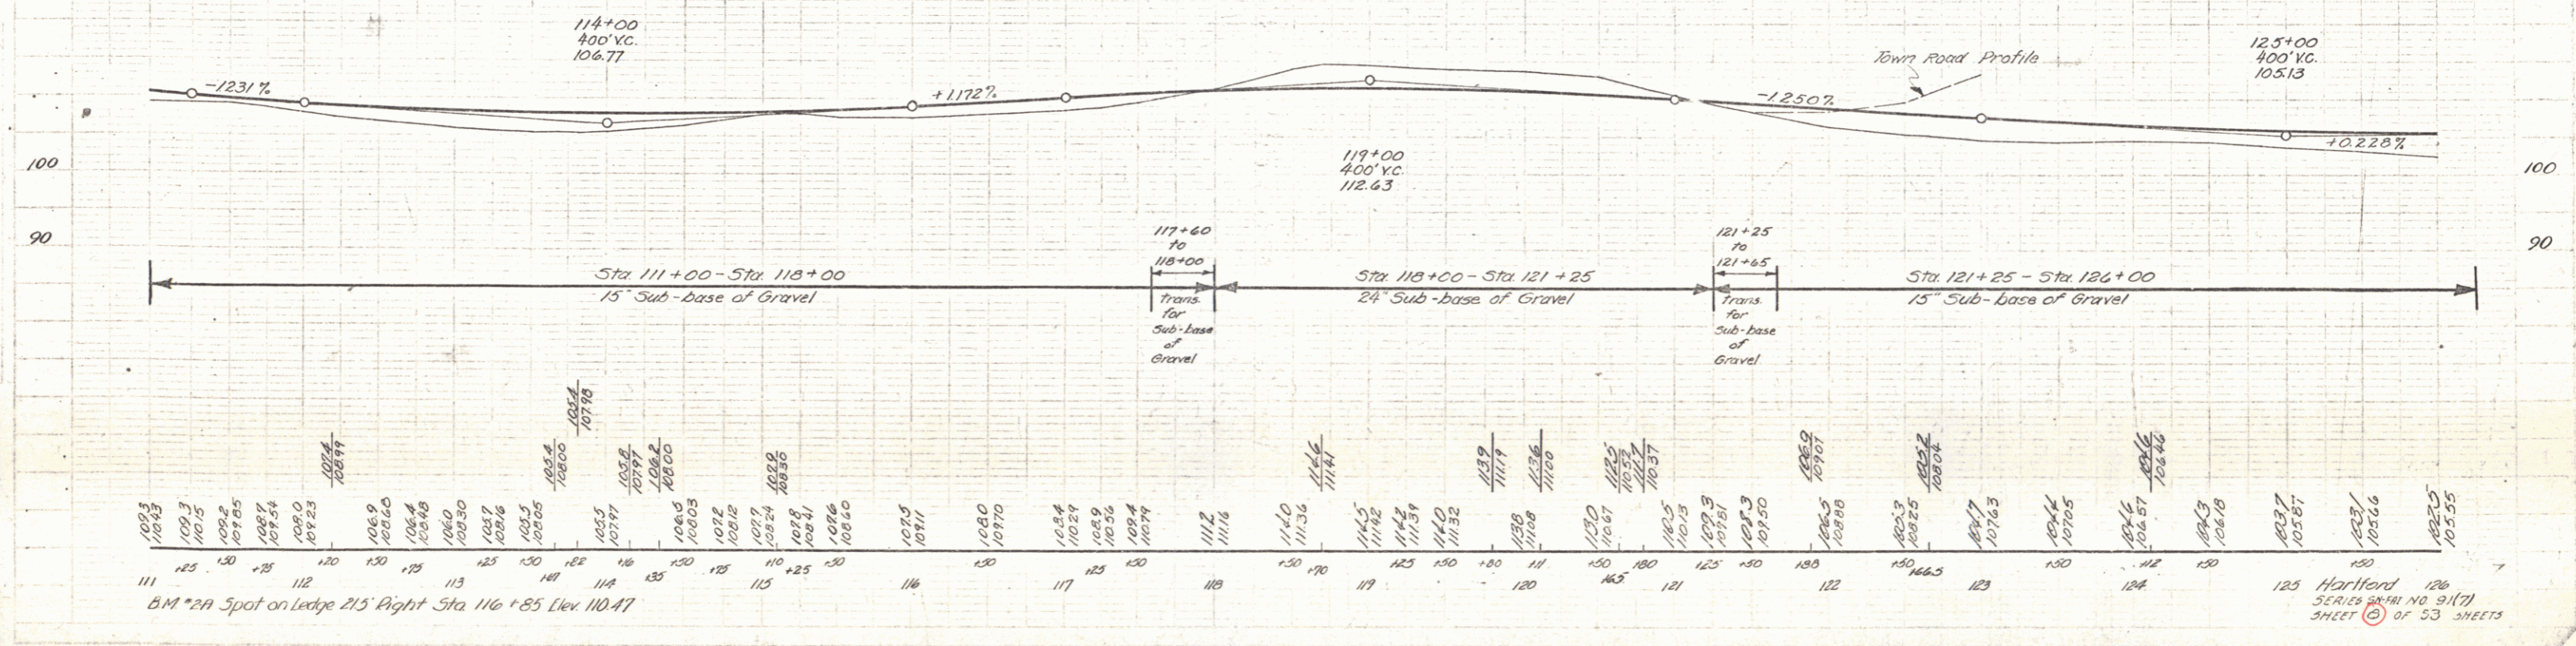


PARCEL	INSTRUMENT	DATE	GRANTOR	GRANTEE	RECORDED	REMARK
A	W.D.O.E.	3-25-42	GREGORY & ANTONELLA	ST. OF VT.	49 167	9-28-42 SLOPE BASE
A,B	W.D.O.E.	3-21-42	ROLAND STEVENS & JOSEPH LABELLE	ST. OF VT.	49 174	10-5-42
A,B	W.D.O.E.	3-21-42	ROLAND STEVENS	ST. OF VT.	49 168	9-28-42

PL. ROAD STATE DIST. NO. 9171 1943 B 53

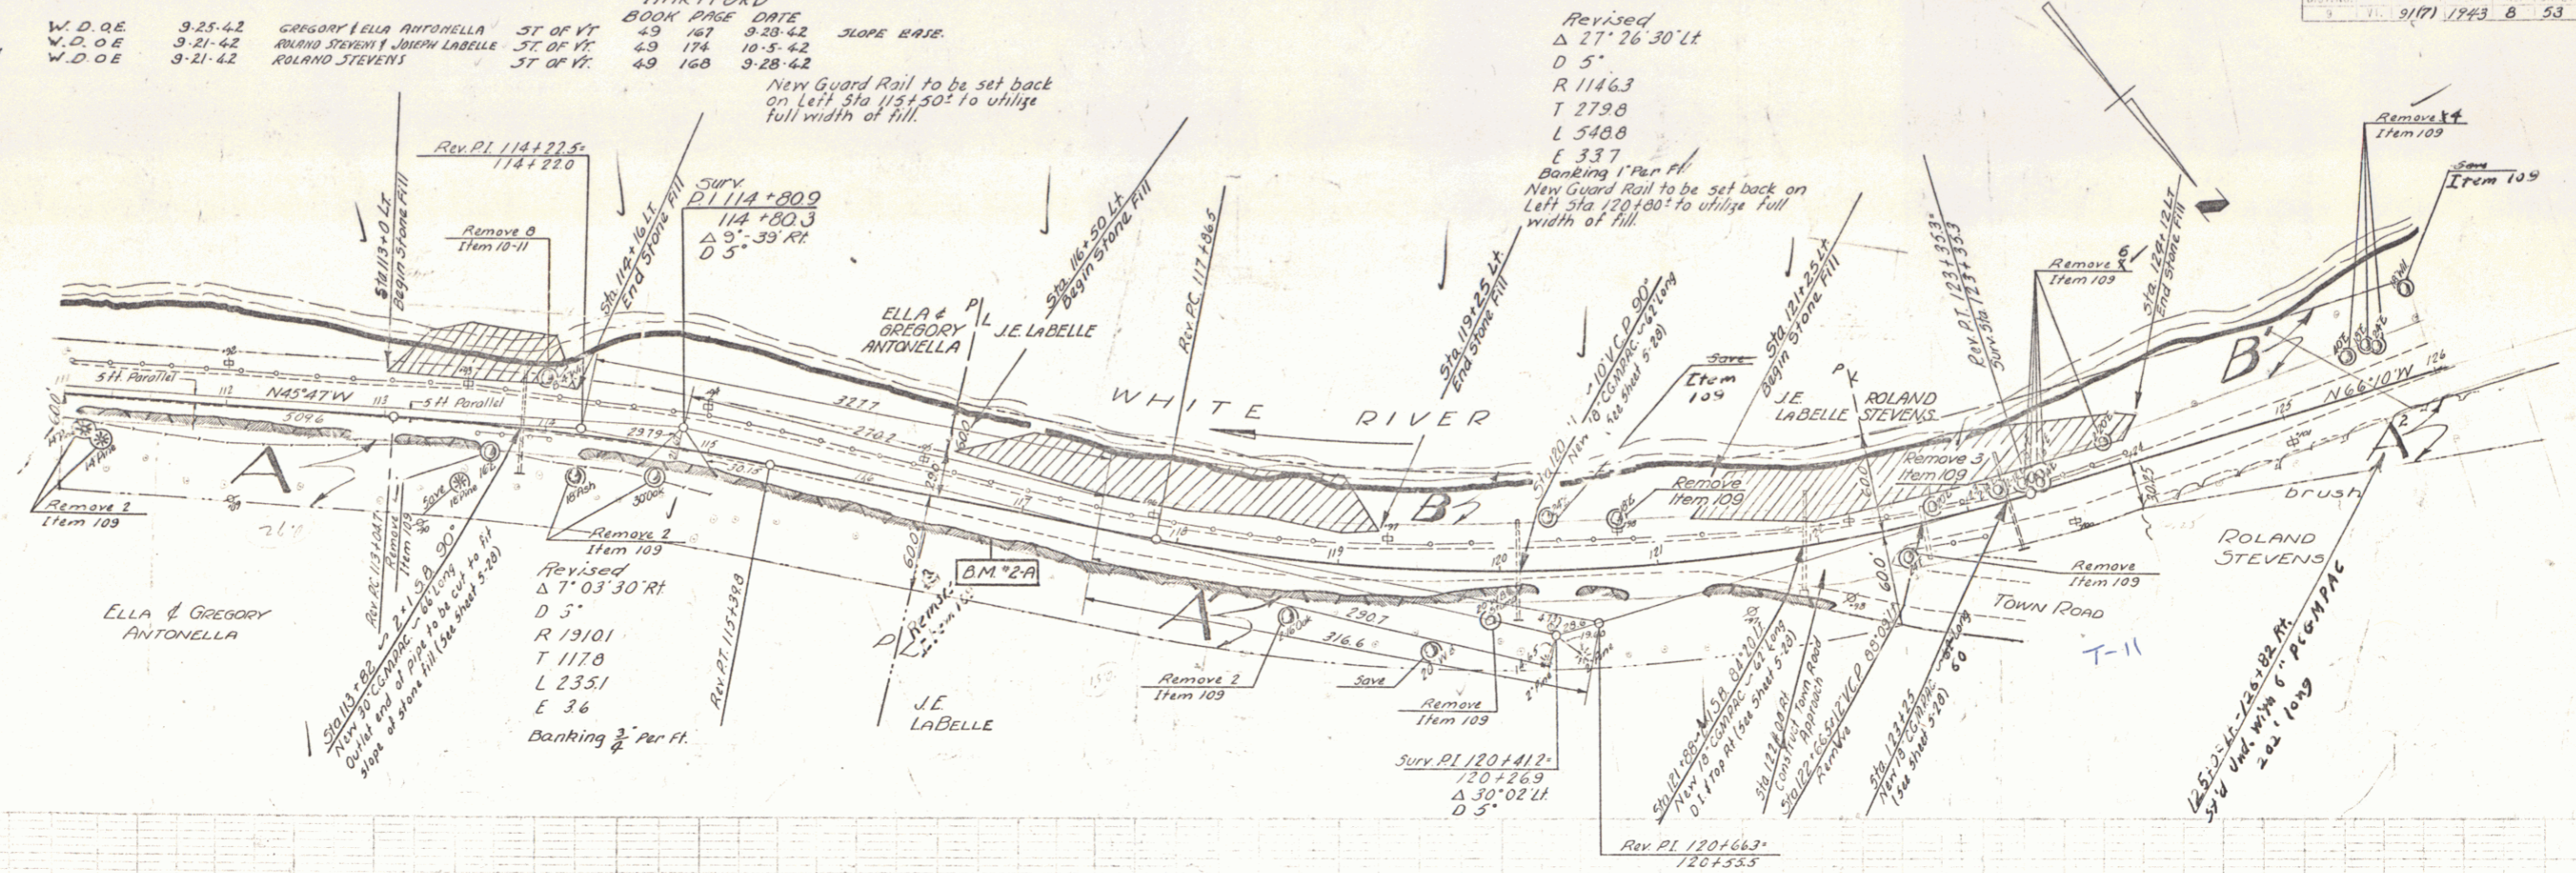

REV. 11-40
11-40
11-40

REV. 11-40
11-40
11-40

B.M. *2A Spot on Ledge 215' Right Sta 116+85 Elev 110.47

Hartford
SERIES DRAWING NO 91(7)
SHEET 8 OF 53 SHEETS

7