


PARCEL	INSTRUMENT	DATE	GRANTOR	GRANTEE	RECORDED	REMARK
A	C.C.D.	1-19-40	LESTER L. DAVIS MOCK	ST. OF VT.	48	67-9
A	C.C.D.	1-23-40	LIZZIE TROCY	ST. OF VT.	48	67-9



B.M. No. 3 Spk on bridge rail 11ft. left of sta. 128125. Elev. 104.52
 B.M. No. 4 Spike in roof of 24 Elm 30ft. left of sta. 142122 Elev. 106.05

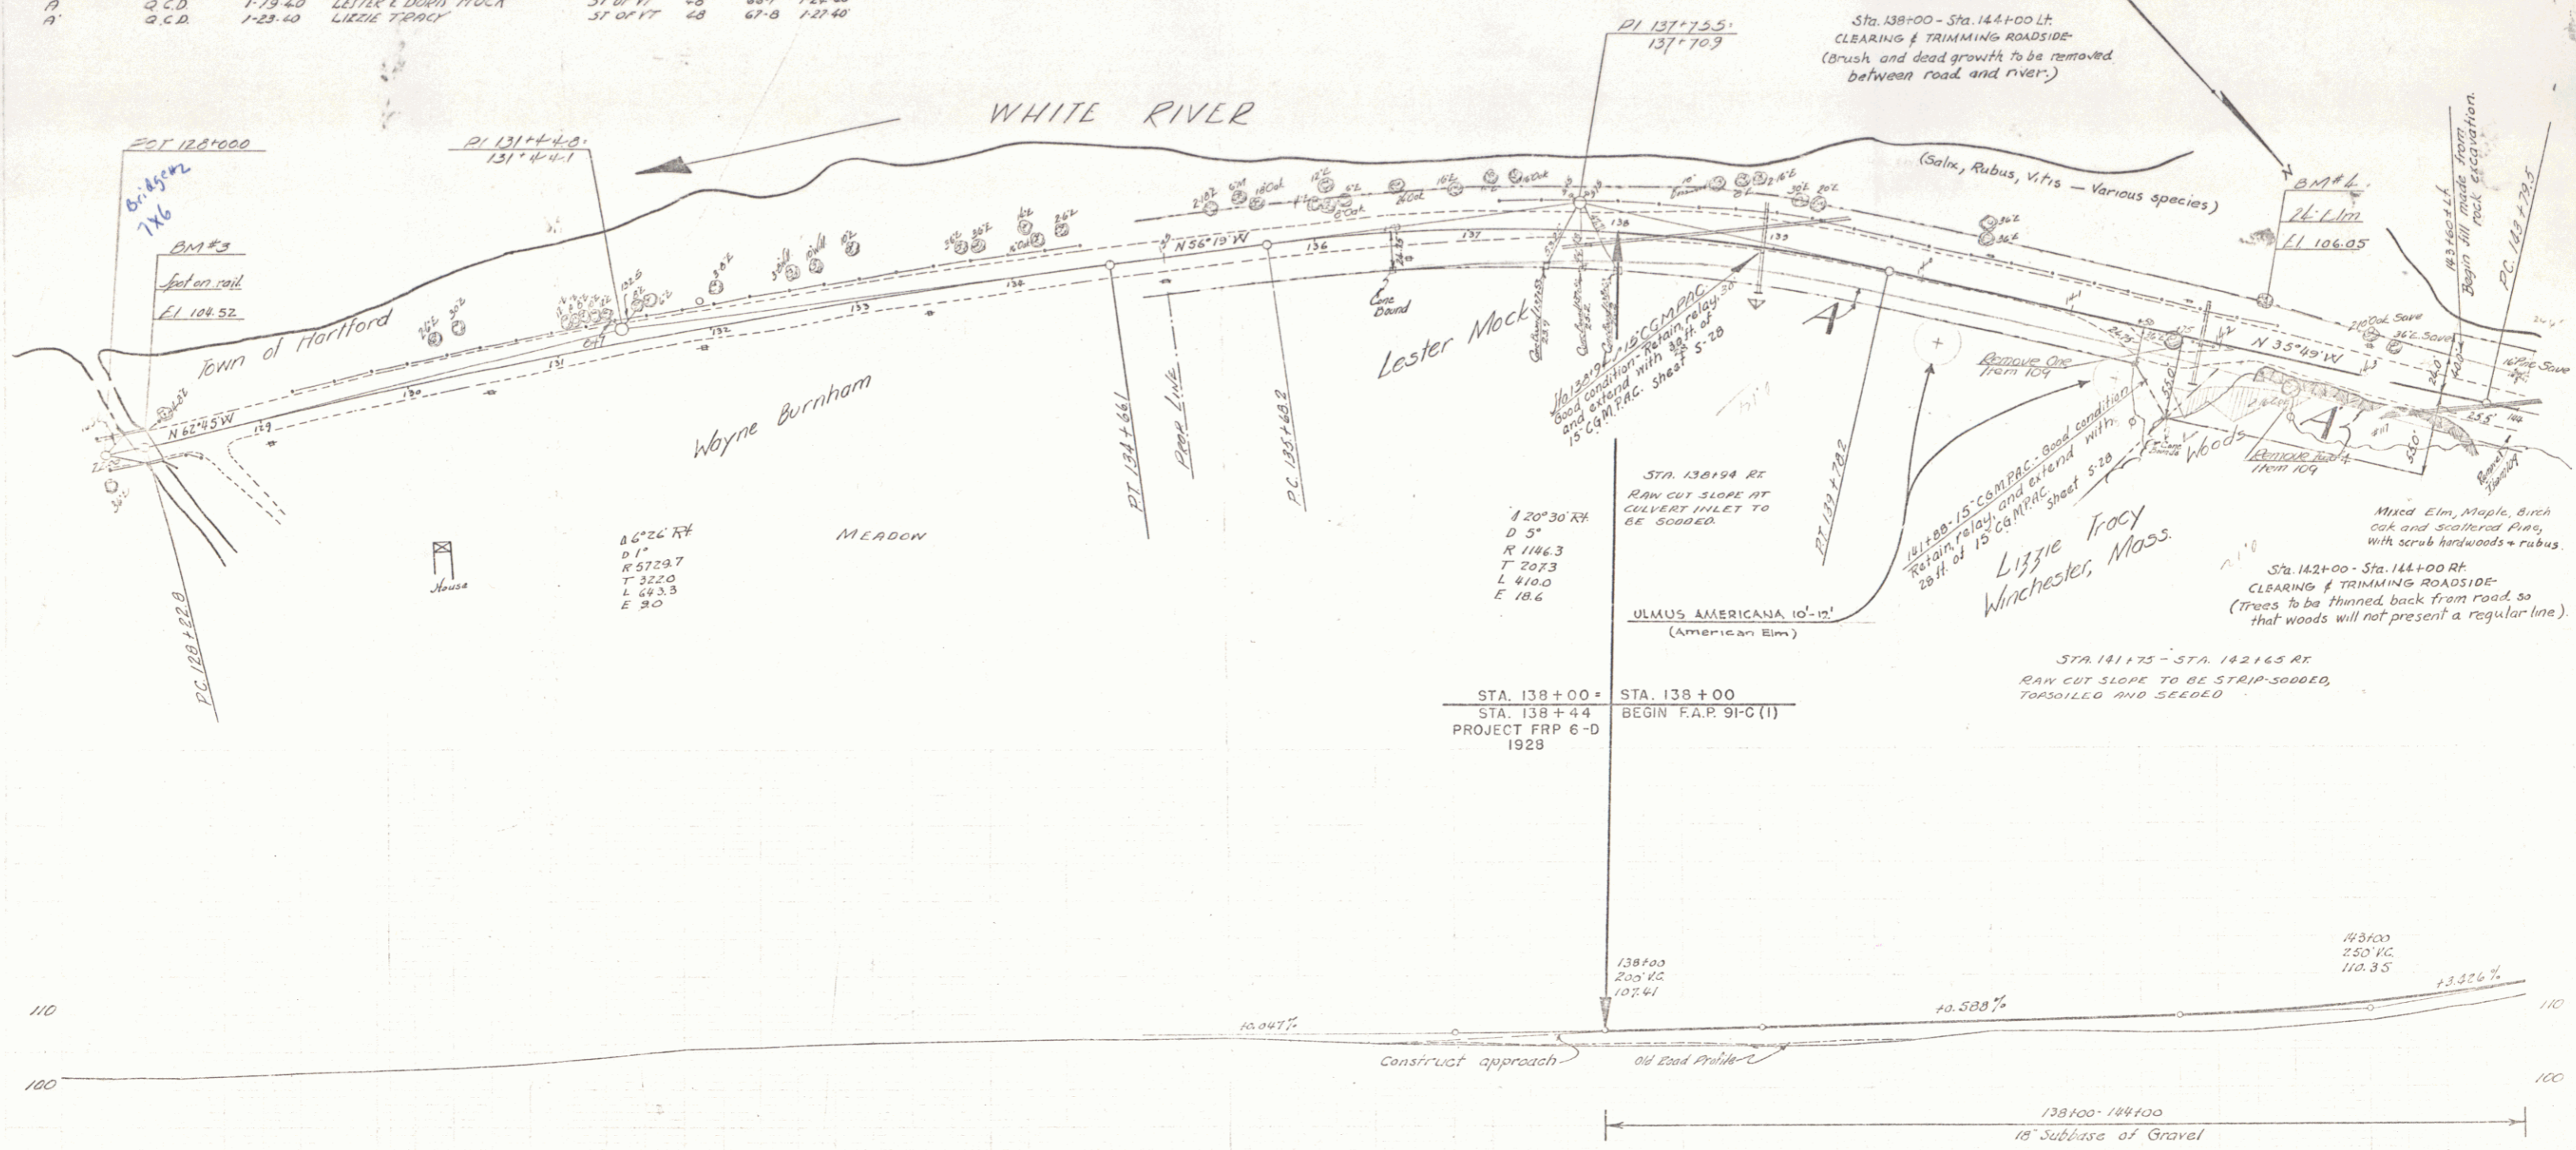