


PARCEL INTEREST DATE GRANTEE GRANTEE RECORDED REMARKS
 C Q.C.D. 1-19-40 BETHUNE & L. ADAMS ST. 1/2 HARTFORD 285 285 1-26-40

91211 1944 11 25

D 23°17'14"
 P 1637.3
 T 337.3
 L 663.1
 E 33.6

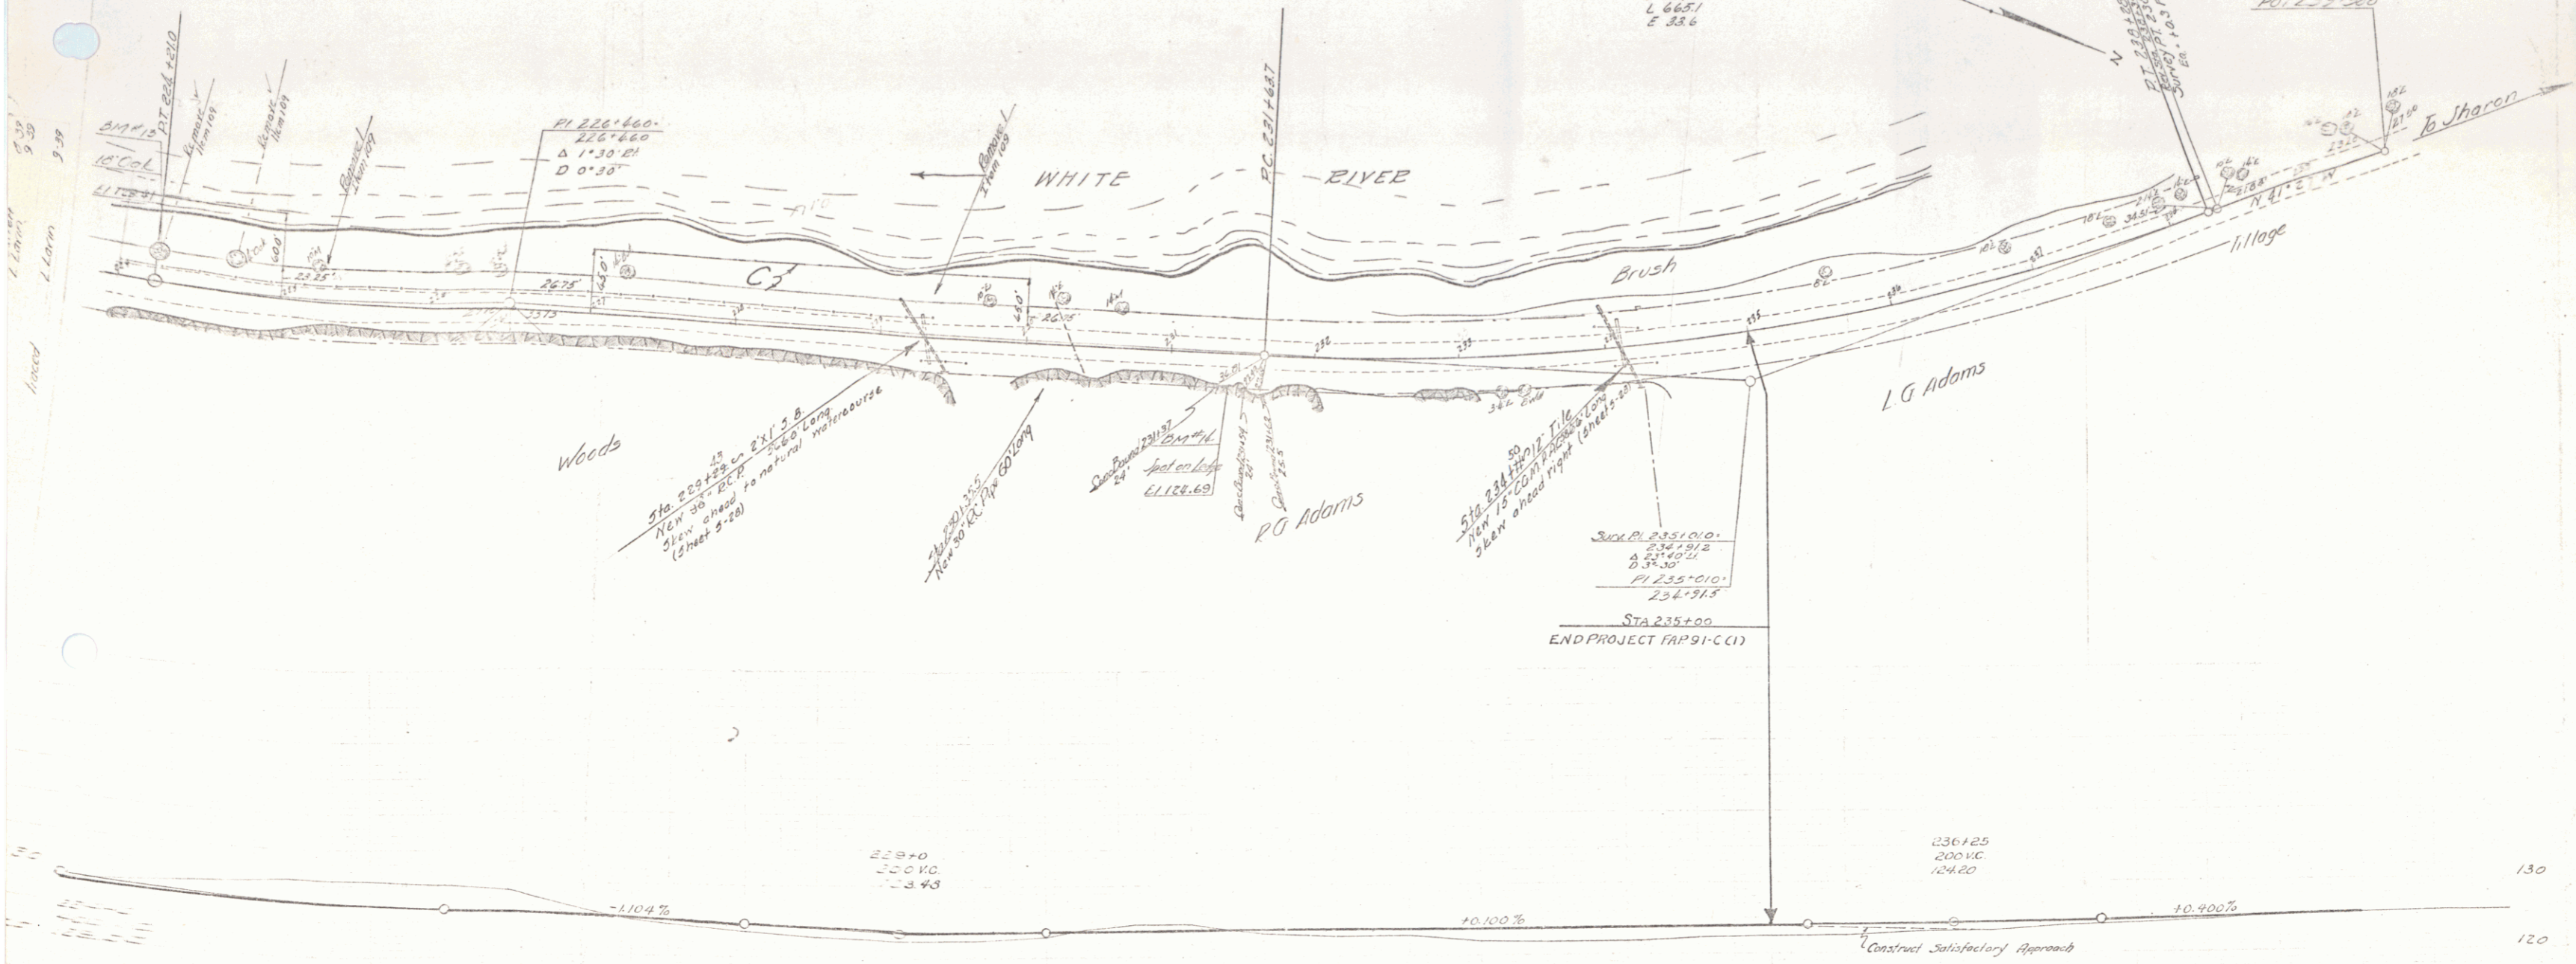

225+00 - 227+00 Sub-base of Gravel
 227+00 - 231+00 Shaping Course of Gravel
 231+00 - 232+00 10\"/>

Trunk of 18" Oak, 16th left of sta. 224+22 Elev. 120.41
 ledge, 23th right of sta. 231+40. Elev. 120.69

150	226	140	163	150	227	130	228	130	229	150	230	150	231	150	232	150	233	150	234	150	235	150	236	150	237	150	238	150	239	150	240
127.81	126.79	126.66	126.52	126.38	126.24	126.10	125.96	125.82	125.68	125.54	125.40	125.26	125.12	124.98	124.84	124.70	124.56	124.42	124.28	124.14	124.00	123.86	123.72	123.58	123.44	123.30	123.16	123.02	122.88	122.74	122.60

SHEET NO 91211
 SHEET 11 OF 68