


ADWARD LAYING
 LAYING
 FINISH



(To Be Returned To R.O.W. Division)
 PERPETUAL
 TOWN FILE
 HIGHWAY DIVISION
 M.P. 4.21 - 4.48
 0+14

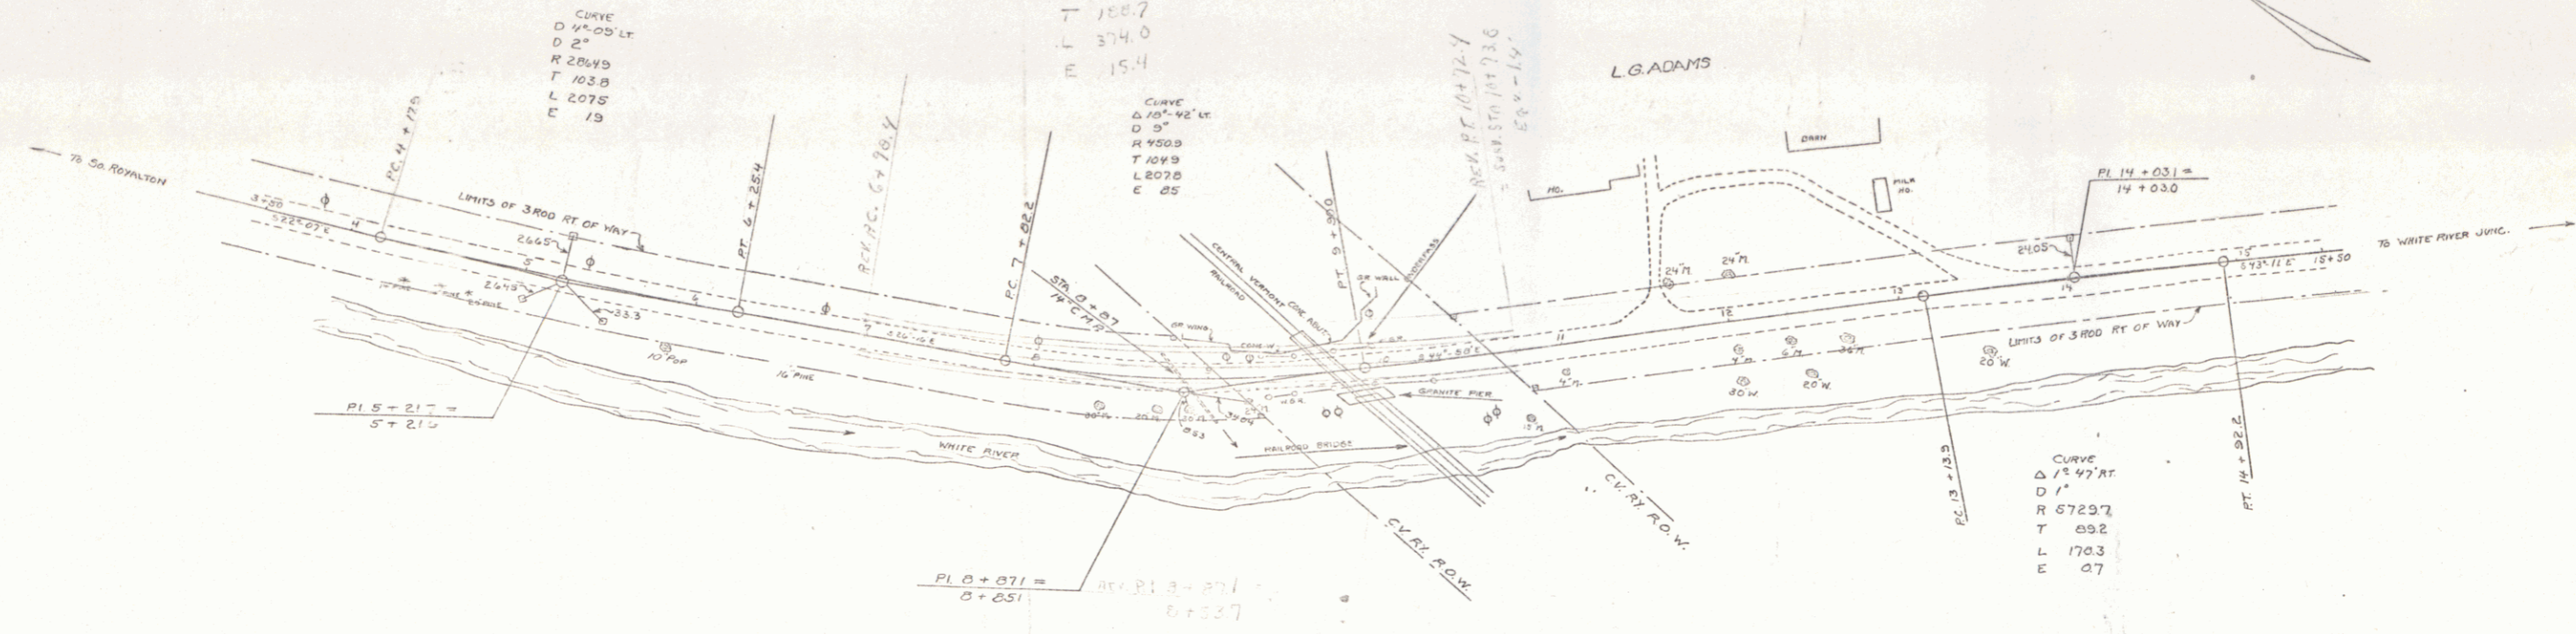

DETAILED LAYOUT
 UNDERPASS
 SCALE 1" = 10'

CONCRETE ROW MARKERS			
STATION	LT	RT	DISTANCE
8 + 05 ±	✓		24.75'
9 + 35 ±	✓		24.75'
10 + 40 ±	✓	✓	24.75'
10 + 20 ±		✓	24.75'

DISTANCE MEASURED TO BACK OF MARKER

CONCRETE E MARKERS			
STATION	LT	RT	DISTANCE
5 + 271			
14 + 031			

DISTANCE MEASURED TO CENTER OF MARKER

STATE OF VERMONT
 RIGHT OF WAY
 ADAMS PROPERTY
 TOWN OF HARTFORD
 ROUTE 14
 SCALE 1" = 30'

SHEET 2

DIST. # 4 PLANS 2