
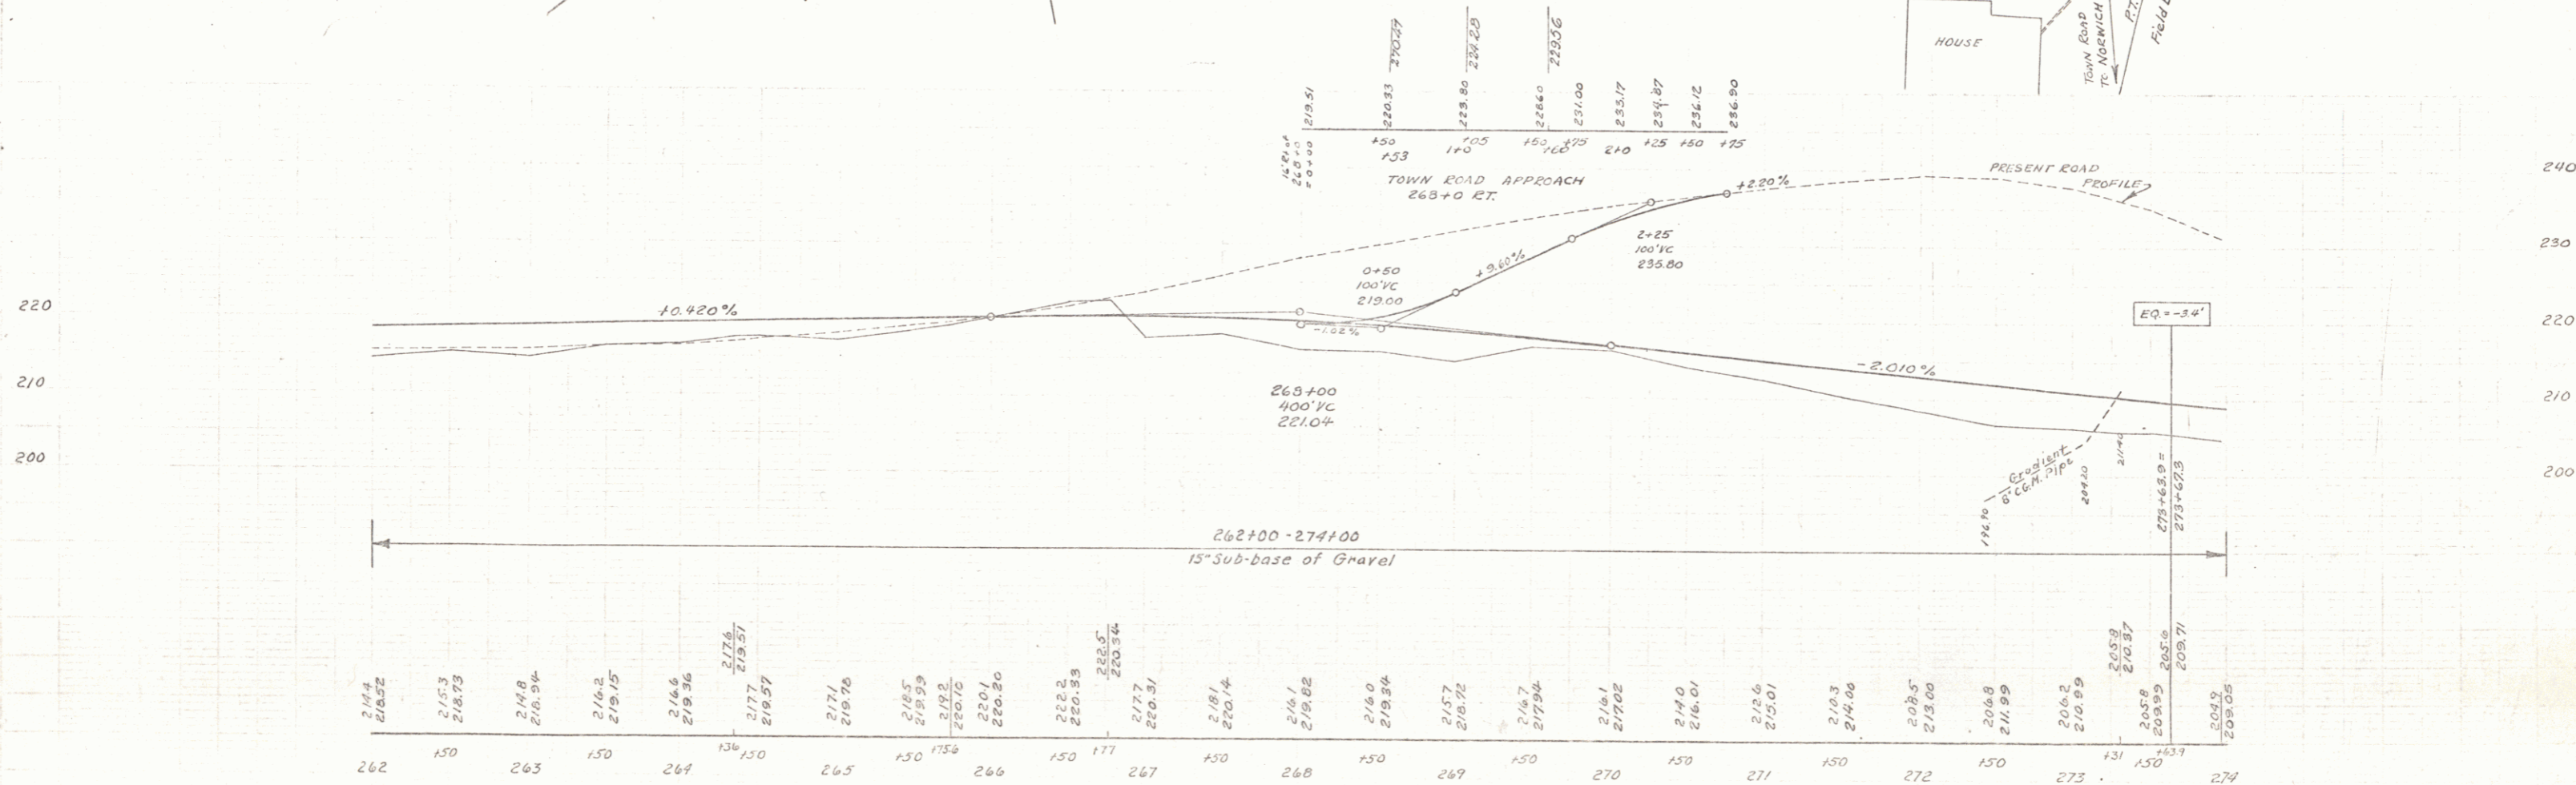


PARCEL INSTRUMENT DATE GRANTOR GRANTEE RECORDED REMARKS
 1908 W.D. 6-8-40 GEO. H. LAURA I. SAVAGE ST OF RT 48 158-9 6-23-40
 HARTFORD
 BOOK PAGE DATE
 158-9 6-23-40

91-D-01341 5 34

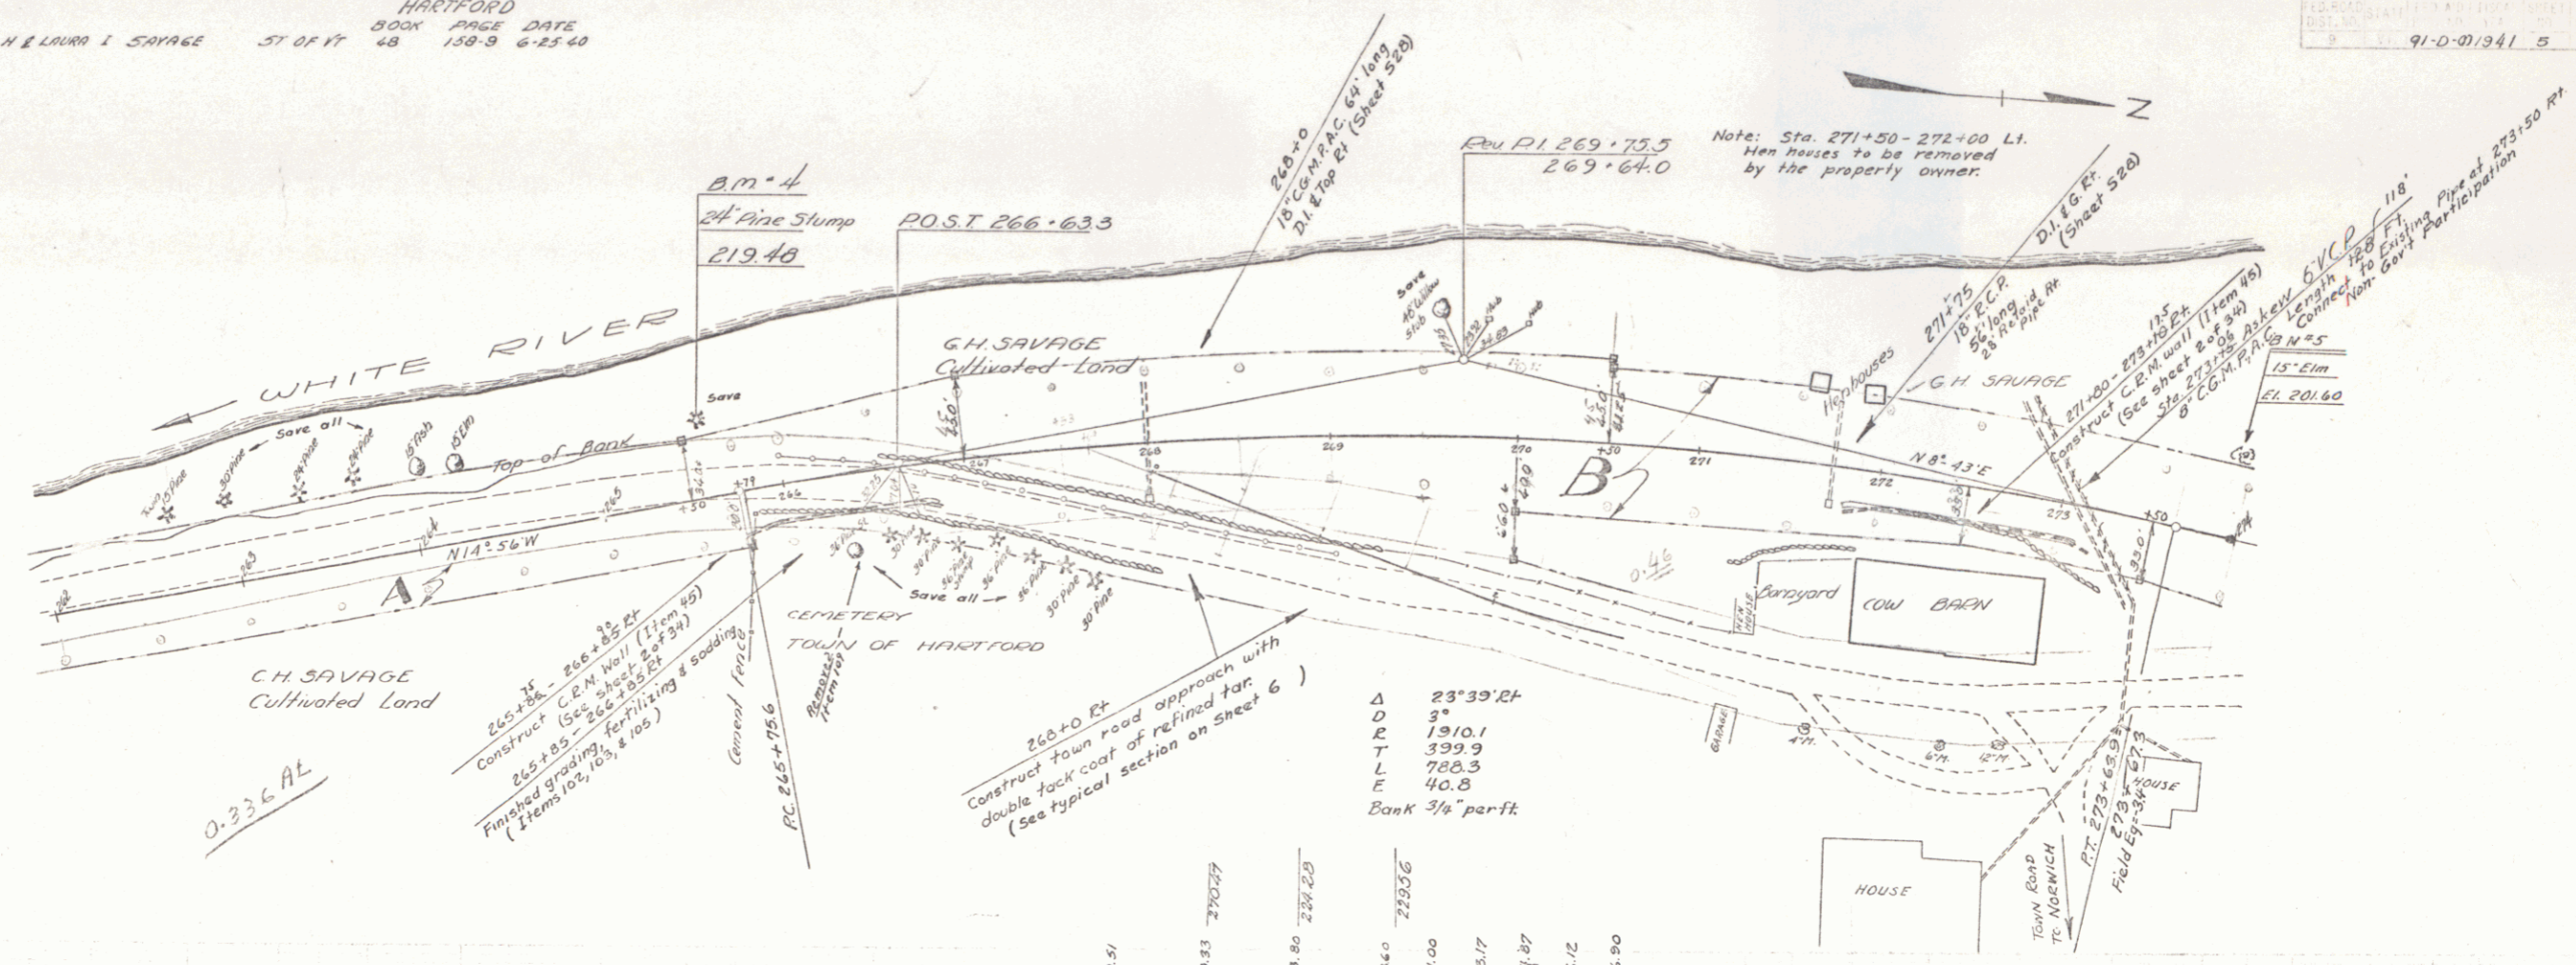

B.M. No 4 Spike in root of 30' Pine 43ft left of Sta. 265+59. Elevation 219.48
 B.M. No 5 Spike in root of 15' Elm 43ft left of Sta. 273+93. Elevation 201.60

HARTFORD
 SERIES (P.P. NO. 91-D-01)
 SHEET 5 OF 34