



PARCEL KIND OF DATE OF GRANTOR GRANTEE RECORDED REMARKS  
 INSTRUMENT INSTRUMENT HARTFORD  
 A R.C.D. 8-18-36 LANGDON HAZEN ESTATE 31,076 #7 103-F 8-26-36

PL. NO. STATE TOWN NO. YEAR NO. SHEET  
 31-B 1937 5 37

REV. CURVE  
 Δ 33° 49' 12"  
 D 37'  
 R 1318.1  
 T 530.6  
 L 1122.2  
 E 86.3

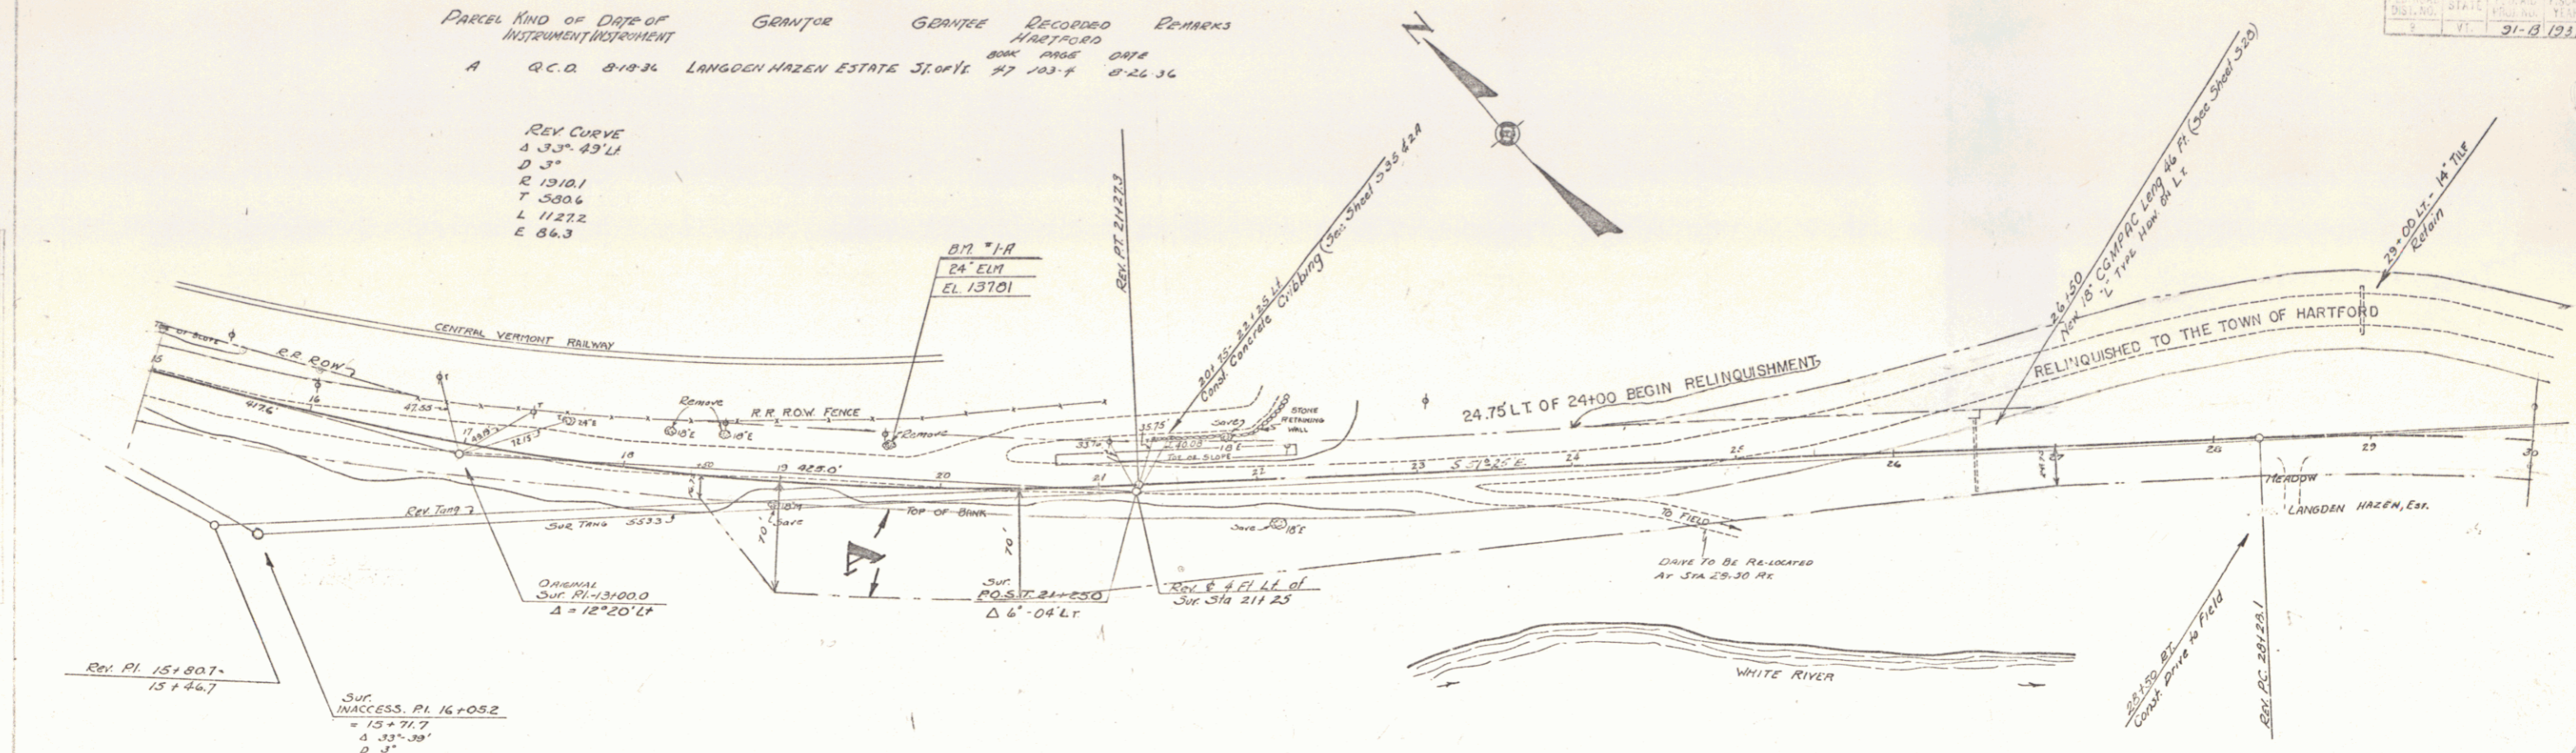

SECTION OF HIGHWAY SHOWN ABOVE & ON SHEET 6 IS RELINQUISHED TO THE TOWN OF HARTFORD & RECORDED JULY 26, 1977, IN BOOK 80, PAGES 594-595 OF LAND RECORDS OF THE TOWN OF HARTFORD.

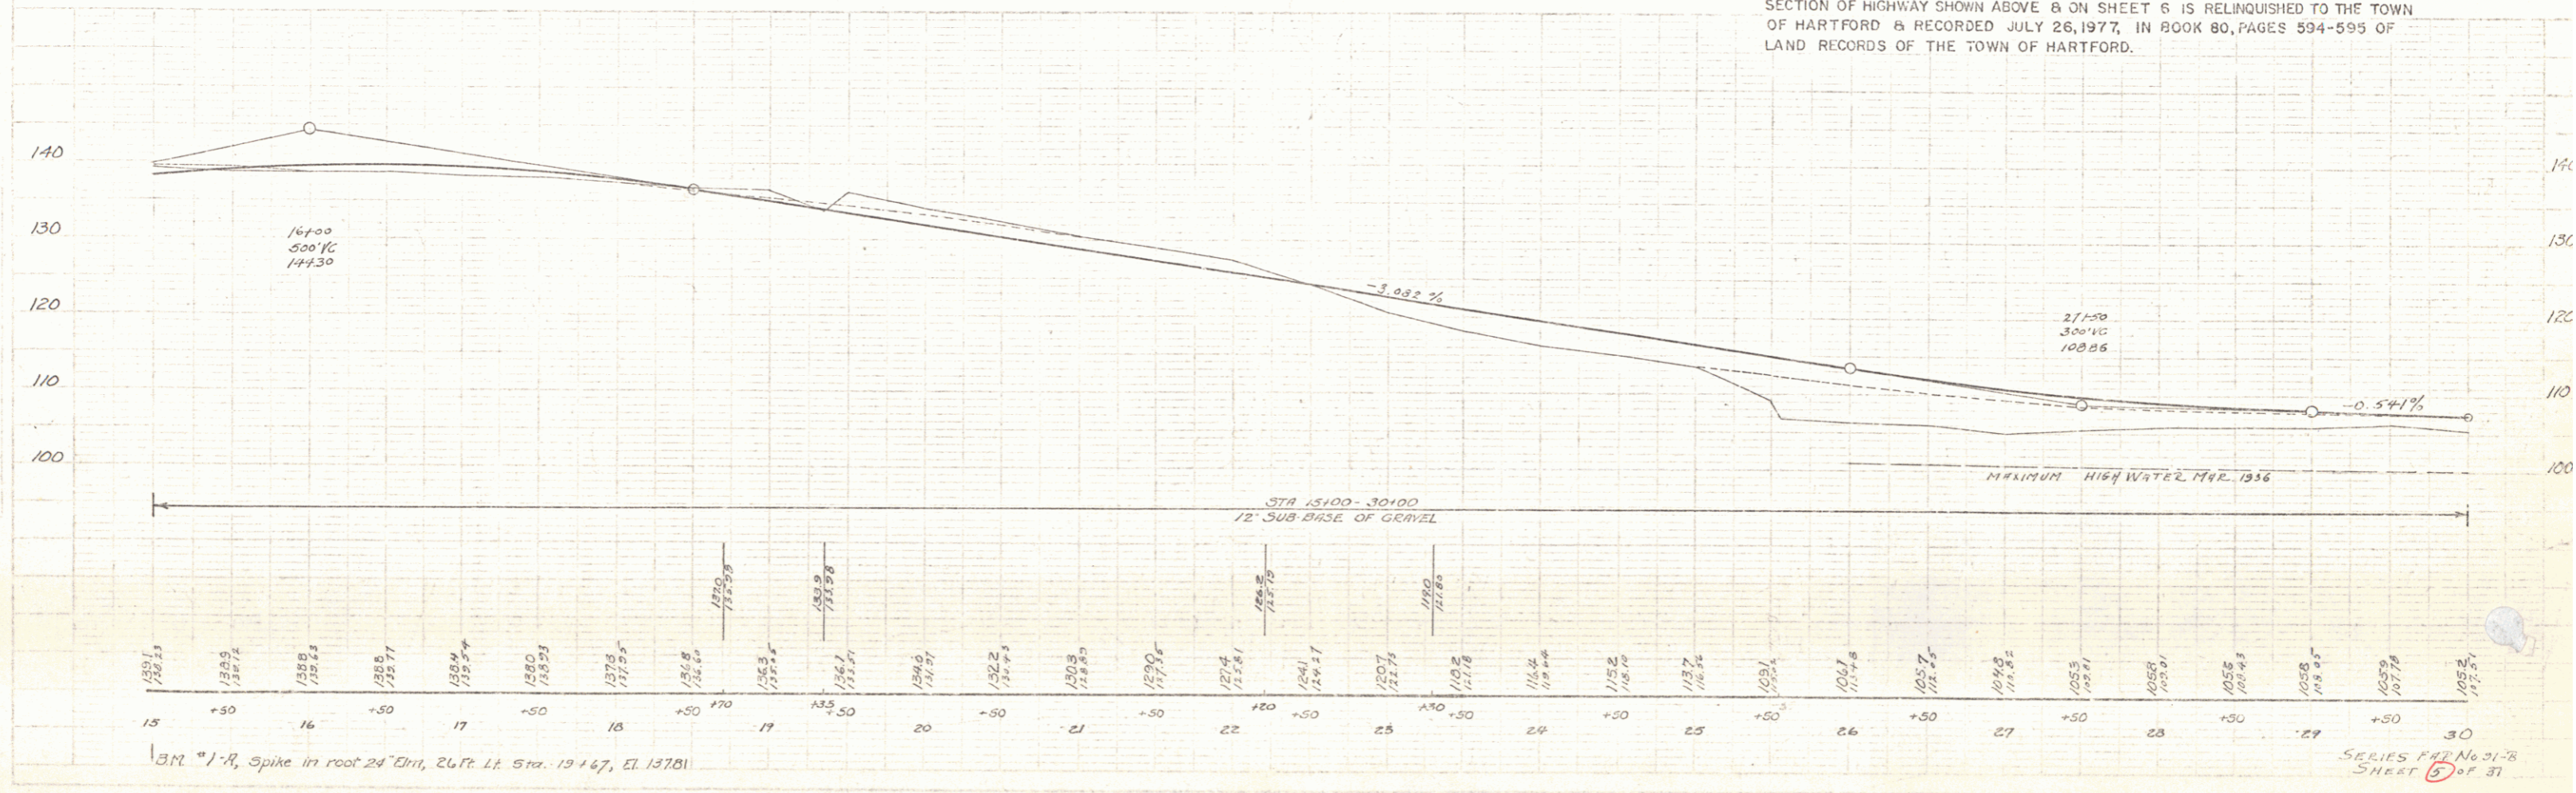

BM \*1-R, Spike in root 24" Elm, 24 Ft. Lt. Sta. 15+47, El. 137.81

SERIES PAD No 31-B SHEET 5 OF 37

AUG 12 1977 3